

FILED *JP*

AUG 17 1993

OREGON CORNER RESTORATION FORM

Section 1 Township 20S Range 9W

County DOUGLAS Date 5-19-93

COUNTY SURVEYOR  
DOUGLAS COUNTY, ORE.

CORNER DESIGNATION

NORTH 1/4 CORNER SECTION 1

- Condition Report Only
- Not Found
- Renewed
- Unrecovered
- Surveyed In
- Referenced Out

Previous Renewals/Surveys, etc. ORIGINAL G.L.O. SURVEY IN 1891 BY WILLIAM TAYLOR. 1953-1954 B.L.M. SURVEY BY THOMAS TULLMAN. 1972 SURVEY BY RICHARD HINTZ C.S. FILE # 63/153


Monument(s) & Accessories Found: (Condition and Source)

FOUND 1953 G.L.O. BRASS CAP IN GOOD CONDITION  
2 1/2" BRASS CAP BEARS N 89° 12' 52" W 81 7/8" - 1/4 CORNER SECTION 36.  
22" FIR STUMP BEARS S 55 1/4° E, 37' VISIBLE SCRIBING.  
20" FIR STUMP BEARS S 69° W, 27" HEALED FACE

Monument Detail

Sketch

1/4 S1  
1953

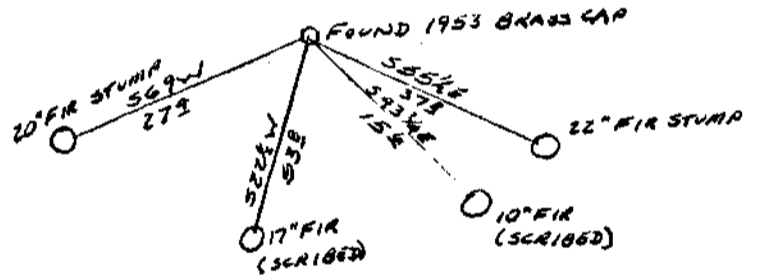

Monument Set (Procedures and Description)

NONE

New Accessories

17" FIR BEARS S 22 1/2° W, 53" BLAZED & SCRIBED "1/4 S1 BT"  
10" FIR BEARS S 43 3/4° E, 15" BLAZED & SCRIBED "1/4 S1 BT"

Location & Comments

CORNER LIES ON A  
GRADUAL NW CURVE

Compass Declination 20°  
 Firm  
 Ward NorthWest Inc.  
 P.O. Box 105  
 Florence, OR 97439  
 Party Chief WAYNE DONOVAN  
 Notes  
 Witness MIKE KESSLER

Surveyor's Seal

REGISTERED  
PROFESSIONAL  
LAND SURVEYOR

*Wayne R. Donovan*  
 OREGON  
 JULY 21, 1992  
 WAYNE R. DONOVAN  
 2553

EXPIRES 12/31/93

C.S. File No. 63/153-  
56

VC