

FILED

AUG 17 1993

OREGON CORNER RESTORATION FORM

Section 6 Township 20S Range 3W  
County Douglas Date 5-19-93

COUNTY SURVEYOR  
DOUGLAS COUNTY, ORE.

CORNER DESIGNATION

NORTHWEST CORNER SECTION 6

- Condition Report Only
- Not Found
- Renewed
- Unrecovered
- Surveyed In
- Referenced Out

Previous Renewals/Surveys, etc. ORIGINAL G.L.O. SURVEY BY WILLIAM P. WRIGHT  
1893-1894. 1953-1954 B.L.M. SURVEY BY THOMAS TILLMAN


Monument(s) & Accessories Found: (Condition and Source)

- FOUND 3 1/2" BRASS CAP IN GOOD CONDITION
- 30" FIR BEAR: S 20° E, 57 1/2' HEALED FACE
- 51" HEMLUCK BEAR: S 32 1/2° W, 24 1/2' HEALED FACE
- 40" FIR STUMP BEARS N 53 1/2° W, 49' NO MARKS
- 31" CEDAR BEARS N 03 1/4° E, 94 1/2' HEALED FACE

Monument Detail

	T195
	R3W
T20S	S31
R7W	S6
S1	T20S

1953

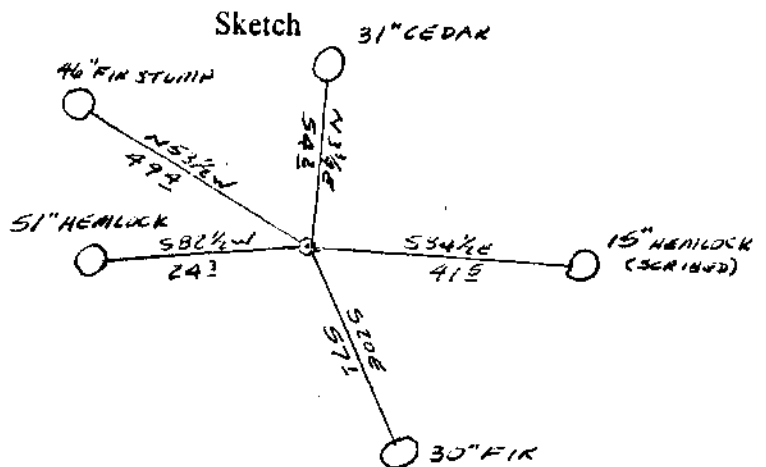

Monument Set (Procedures and Description)

NONE


New Accessories

15" HEMLUCK BEARS S 34 1/2° E, 41' BLAZED / SCRIBED "T20S R7W S6 ET"

Location & Comments

CORNER LIES ON A Compass Declination 20°  
NORTH EASTING BEARING Firm  
 Ward North West Inc.  
 P.O. Box 105  
 Florence, OR 97439  
 Party Chief WAYNE DONOVAN  
 Notes  
 Witness MIKE KESSLER

Surveyor's Seal

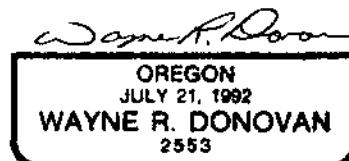

EXPIRES 12/31/93

C.S. File No. 63/153