

FILED

Date: 1-13-94 By: JP
This survey consists of:
Map: R.M. 3-80
Narrative:
Corner Rpt: C.S. 63/154

OREGON CORNER RESTORATION FORM

Section 16 Township 265 Range 3W

County Douglas Date January 3, 1994

DOUGLAS COUNTY
SURVEYOR

Corner Designation

$\frac{1}{4} \frac{59}{516}$

- Condition Report Only
- Not Found
- Renewed
- Unrecorded
- Surveyed In
- Referenced Out

Previous Renewals/Surveys, etc.


U.S.G.L.O. Survey, 1924.
Douglas County Surveyor's Office, January, 1966, C.S. File 54/7

Monument(s) & Accessories Found: (Condition and Source)

Found 2 1/2" Brass Cap on 1" Iron Pipe at 3 way
fence corner, fences going North, South & West. From
Brass Cap a:
14" White Oak BT, face overgrown, on N-S fence,
bears S 2° W (Record S 9° W), 58.7 feet.
24" White Oak BT, face overgrown, bears N 15° W,
22.4 feet (Record 23.1 feet).

Monument Detail

Sketch

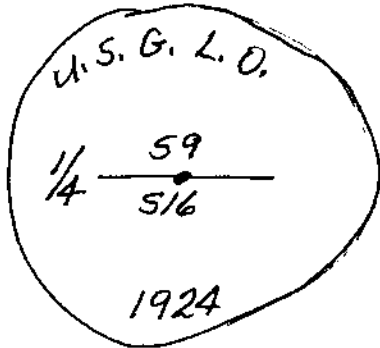

Monument Set (Procedures and Description)

None.

New Accessories

None.

Location & Comments

None.

See aerial photo.

Compass Declination 18° E

Firm/Agency Shaner Engineering

Address P.O. Box 1430
Roseburg, OR 97470

Party Chief B. Shaner

Notes " "

Witness John Wright

Surveyor's Seal

REGISTERED
PROFESSIONAL
LAND SURVEYOR

Bruce A. Shaner

OREGON
OCT. 4, 1987
BRUCE A. SHANER
430

Expires Dec. 31, 1994

C.S. File No. 63/154