

FILED

Date: 3/15/94 By: JC

This survey consists of:

Map: _____

Narrative: _____

Corner Rpt: C.S. 63/154

OREGON CORNER RESTORATION FORM

Section 28 Township 31S Range 8W

County DOUGLAS Date 12/13/94

Corner Designation

E 1/4 28/27

DOUGLAS COUNTY
SURVEYOR

- Condition Report Only
- Not Found
- Renewed
- Unrecorded
- Surveyed In
- Referenced Out

Previous Renewals/Surveys, etc. M87-74

Monument(s) & Accessories Found: (Condition and Source)

FOUND: 1977 CAD. BCIP

24" CEDAR, N70E, 9²Ft, Fair condition

23" CEDAR, N86³/₄W, 30⁷Ft, tall stump

Monument Detail

Sketch

Monument Set (Procedures and Description)

New Accessories

20" FIR, S77E, 35^o, Scribed "1/4 S.27 BT"

16" MADRONE, N64E, 20², Scribed "1/4 S.27 BT"

17" FIR, N9E, 24¹, Scribed "1/4 S.27"

Location & Comments

Surveyor's Seal

Compass Declination _____

Firm/Agency ROSEBURG

FOREST PRODUCTS


Address P.O. BOX 1088

ROSEBURG, OR 97470

Party Chief Bill Olson

Notes _____

Witness Ralph McManis

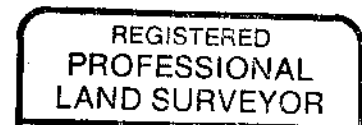

Mark F. Smalley
 OREGON
 JULY 26, 1988
 MARK F. SMALLEY
 2354

RENEWS 12/31/94