

M 120-31

FILED

Date: 7-11-94 By: JP
This survey consists of:
Map: M 120-31
Narrative:
Corner lpt: C.S. 63/154

OREGON CORNER RESTORATION FORM

Section 16 Township 32S Range 8W

County Douglas Date June 30, '94

DOUGLAS COUNTY
SURVEYOR

Corner Designation

$\frac{9}{16} | \frac{10}{15}$

- Condition Report Only
- Not Found
- Renewed
- Unrecorded
- Surveyed In
- Referenced Out

Previous Renewals/Surveys, etc.


Douglas County Surveyor, 1968 (Powell)

Monument(s) & Accessories Found: (Condition and Source)

Found 2 1/2" Brass Cap on a 1" Galv. Iron Pipe, from which a:
40" D. Fir BT, scribes visible, bears S28°W, 34.3 feet.
10" Madrone BT, face overgrown, bears N53°W, 27.8 feet
(record 28.8 feet).
16" Pine BT (record 8"), bears N88°E, 34.2 feet (record 35.7 ft.)
(face overgrown.)
5" Pine BT, bearing East, 33.0 feet, Now Gone.

Monument Detail

Sketch

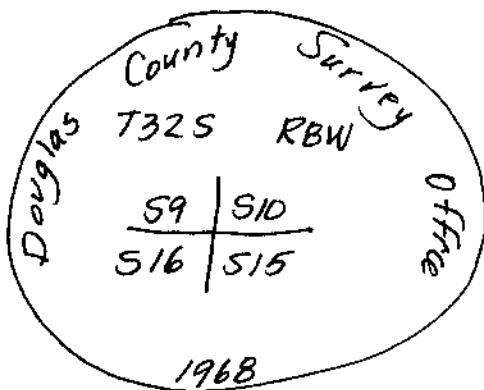

Monument Set (Procedures and Description)

None.

New Accessories

6" D. Fir BT, I scribed "515 T32S RBW BT"
bears S51°E, 11.4 feet.

Location & Comments

Corner lies 500 feet Compass Declination 20°E
above & west of Firm/Agency Shaner
U.S. B.L.M. Road Engineering, Inc.
No. 32-8-15, Address P.O. Box 1430
at timber corner. Roseburg, Oregon 97470
 Party Chief Shaner
 Notes "
 Witness Jack Wright

Surveyor's Seal

REGISTERED
PROFESSIONAL
LAND SURVEYOR

Bruce A Shaner

OREGON
OCT. 4, 1967
BRUCE A. SHANER
430

Expires Dec. 31, '94
C.S. File No. 63/154 ①