

Date: 7-11-94 By: JP
This survey consists of:
Map: M 120-31
Narrative: _____
Corner Rpt: C.S. 63/154

OREGON CORNER RESTORATION FORM

Section 16 Township 32S Range 8W

County Douglas Date June 30, 1994

DOUGLAS COUNTY
SURVEYOR

Corner Designation

$\frac{1}{4}$ $\frac{S9}{516}$

- Condition Report Only
- Not Found
- Renewed
- Unrecorded
- Surveyed In
- Referenced Out

Previous Renewals/Surveys, etc.


Original corner by U.S.G.L.D. now gone. By Proportional Measurement I set this corner.

Monument(s) & Accessories Found: (Condition and Source)

None.

Monument Detail

Sketch

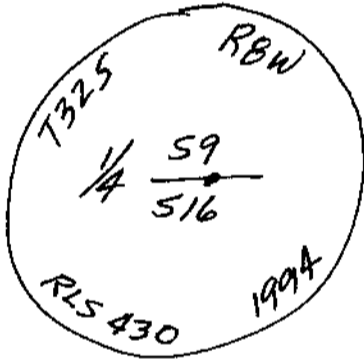

Monument Set (Procedures and Description)

Set 2 1/2" Brass Cap on a 1" x 30" Iron Pipe, from which a:

New Accessories:

8" D. Fir BT, I scribed "1/4 S9 BT" bears N5°W, 15 1/2 feet.
10" D. Fir BT, " " "1/4 S9 BT" bears N30°E, 18 1/2 feet.

New Accessories

10" D. Fir BT, I scribed "1/4 516 BT" bears S22°E, 11 1/2 feet.
8" D. Fir BT, " " "1/4 516 BT" bears S22°W, 13 1/2 feet.
Set 6 feet steel fence post, bears West, 10 feet.

Location & Comments

Corner lies 40 feet West of top of main ridge which bears N80°E & S80°W.

Compass Declination 20°E

Firm/Agency Shaner Engineering, Inc.

Address P.O. Box 1430 Roseburg, Oregon 97470

Party Chief B. Shaner

Notes "

Witness Jack Wright Eric Nielsen

Surveyor's Seal

REGISTERED
PROFESSIONAL
LAND SURVEYOR

Bruce A Shaner

OREGON
OCT. 4, 1957
BRUCE A. SHANER
430

Expires Dec 31, 1994

C.S. File No. 63/154