

FILED

Date: 8/16/94 By: MF

This survey consists of:

Map: _____

Number of _____

Corner Kpt: CS 63/154

OREGON CORNER RESTORATION FORM

Section 19 Township 29S Range 7W

County Douglas Date 7/8/94

DOUGLAS COUNTY
SURVEYOR

Corner Designation

Oro Grande Claim
Corner 2

- Condition Report Only
- Not Found
- Renewed
- Unrecorded
- Surveyed In
- Referenced Out

Previous Renewals/Surveys, etc.


BLM Survey 1988-1989

Monument(s) & Accessories Found: (Condition and Source)

Iron Pipe & Brass Cap - BLM

Monument Detail

Sketch

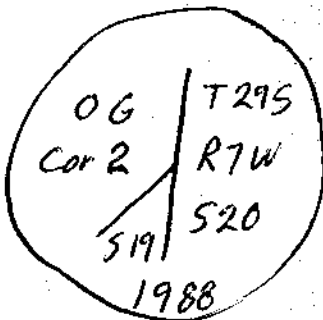

Monument Set (Procedures and Description)

New Accessories

New BTs: 6" Pine S 75° E 22' Scribed "COR 2 BT"
6" Fir S 49° E 12' Scribed "COR 2 BT"

Location & Comments

Surveyor's Seal

Compass Declination 19°

Firm/Agency Roseburg Forest Products

Address P.O. Box 1088

Roseburg, OR 97470

Party Chief Felix Raddatz

Notes _____

Witness _____

REGISTERED
PROFESSIONAL
LAND SURVEYOR

Mark F. Smalley

OREGON
JULY 26, 1988
MARK F. SMALLEY
2354

RENEWS 12/31/94

C.S. File No. 63/154