

FILED

Date: 8/16/94 By: Ac
This survey consists of:
Map: _____
Narrative: _____
Corner Rpt: CS 63/154

OREGON CORNER RESTORATION FORM

Section 36 Township 31S Range 7W

County Douglas Date 7/12/94

Corner Designation

35 | 36
2 | 1

DOUGLAS COUNTY
SURVEYOR

- Condition Report Only
- Not Found
- Renewed
- Unrecorded
- Surveyed In
- Referenced Out

Previous Renewals/Surveys, etc.

Cadastral Survey 1964

Monument(s) & Accessories Found: (Condition and Source)

1964 BCIP
FIR, 13", N9W, 21¹/₂ft, GOOD HEALED FACE
FIR, 36", N80E, 31¹/₂ft, O.B.T.
FIR, 14", S20E, 7¹/₂ft, DOWN, O.B.T.
FIR, 18", S60W, 9¹/₂ft, GOOD HEALED FACE, O.B.T.
FIR, 20", N17W, 80²/₂ft, GOOD HEALED FACE, No Record

Monument Detail

Sketch

Monument Set (Procedures and Description)


New Accessories

CEDAR, 10", S79W, 23¹/₂ft, SCRIBED "S 2 BT"

Location & Comments

CORNER IS 200 FEET Compass Declination 19°
EAST OF R 31-7-25.1 Firm/Agency ROSEBURG
ROAD FOREST PRODUCTS
 Address P.O. Box 1088
ROSEBURG, OR 97470
 Party Chief Bill Olson
 Notes _____
 Witness _____

Surveyor's Seal

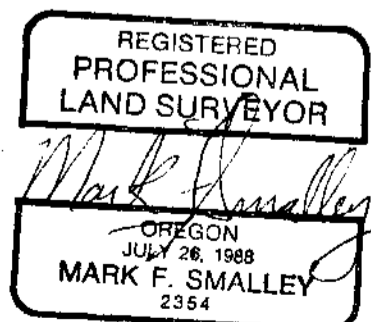

RENEWS 12/31/94

U.S. File No. 63/154