

FILED

Date: 11-14-94 By: JC

This survey consists of:

Map: _____

Narrative: _____

Corner Rpt: C.S. 63/154

OREGON CORNER RESTORATION FORM

Section 36 Township 24S Range 7W

County DOUGLAS Date 10-24-94

Corner Designation

W $\frac{1}{4}$

35 | 36

DOUGLAS COUNTY SURVEYOR

- Condition Report Only
- Not Found
- Renewed
- Unrecorded
- Surveyed In
- Referenced Out

Previous Renewals/Surveys, etc.

p 3236 - 1893 GLO SURVEY

Monument(s) & Accessories Found: (Condition and Source)

24" CEDAR S47E 25' (1893 GLO) NOW 64" HEALED

20" FIR S76 1/2 W 22 1/4 (1893 GLO) NOW 44" HEALED

Monument Detail

Sketch

T24S R7W

$\frac{1}{4}$

35 | 36

Monument Set (Procedures and Description)

SET $\frac{5}{8}$ " X 48" IRON ROD AND ALUM. CAP MARKED "LS 2354" 1994

New Accessories

7" W. FIR N19W 4' SCRIBED "1/4 S Pt"

11" FIR N80E 11' SCRIBED "1/4 S Pt"

Location & Comments

Surveyor's Seal

Compass Declination _____

Firm/Agency ROSEBURG

FOREST PRODUCTS

Address P.O. Box 1088

ROSEBURG, OREGON


Party Chief F. WHITE

Notes W. OLSON

Witness R. McMANIS



Mark F. Smalley

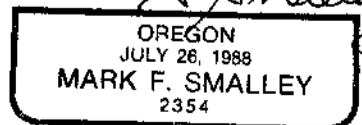

EXP. 12-31-94

C.S. File No. 63/154 19