

FILED

Date 2-1-95 By JP
This survey consists of:
Section _____
Range _____
Township _____
Corner Set: _____

OREGON CORNER RESTORATION FORM

Section 6 Township 21S Range 11W

County DOUGLAS Date JUNE, 1994

DOUGLAS COUNTY
SURVEYOR

Corner Designation

NW 1/16 SEC. 6

- Condition Report Only
- Not Found
- Renewed
- Unrecorded
- Surveyed In
- Referenced Out

Previous Renewals/Surveys, etc. ORIGINALLY SET BY R. WARD
IN SURVEY FOR CHAMPION INTERNATIONAL CORP.,
DATED AUGUST, 1979.


Monument(s) & Accessories Found: (Condition and Source)

FOUND 2 1/2" BRASS CAP ON 2 1/2" O.D. GALV. IRON PIPE,
WITH BENT-OVER STEEL POST (FENCE POST) ALONG SIDE.
BOTH RECORD STEEL FENCE WITNESS POSTS WERE
FOUND LOOSE ON GROUND ON LANDING. RESET
THE SOUTHERLY FENCE POST AT APPROXIMATE
RECORD POSITION.

(6" STEEL FENCE POST S01042'E, 12.1')

(6" STEEL FENCE POST S89°55'E, 11.8')

Monument Detail

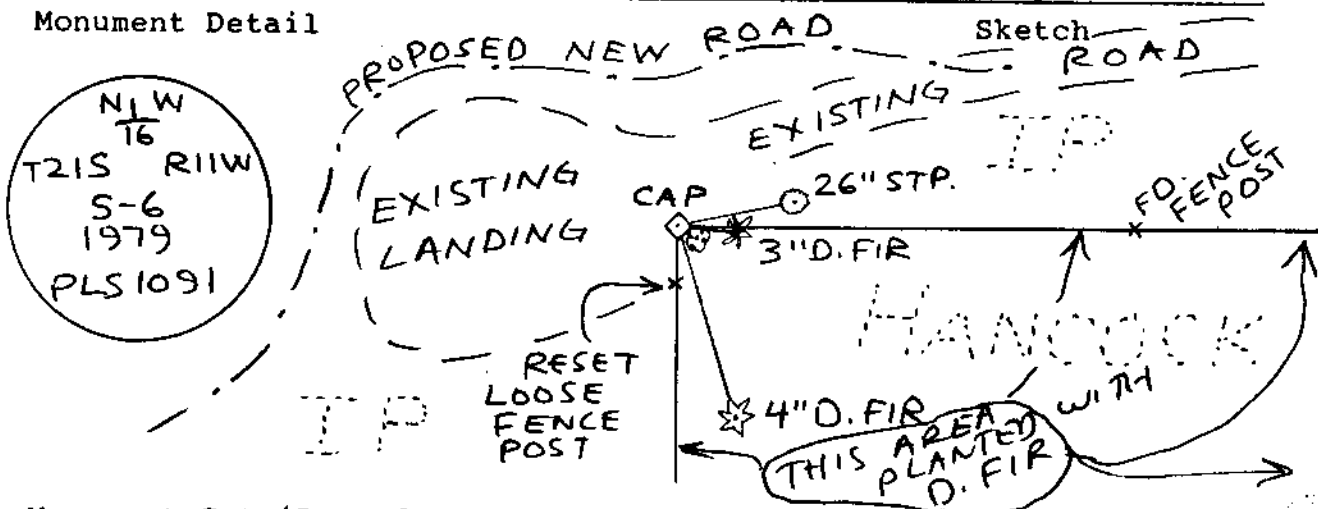

Monument Set (Procedures and Description)

NONE. CUT BRUSH LOW AROUND MONUMENT.

New Accessories

- SET TAGS ON NEW B.T.'S. BEARINGS ARE TO TREE CENTER.
- 26" FIR STUMP, N79°E, 25.1' TO NAIL IN SIDE-CENTER-TAG ONLY.
- 3" D. FIR, S88°E, 11.9' TO NAIL, KNIFE SCRIBED X AT DBH, BT ON
- 4" D. FIR, S18°E, 41.7 TO NAIL, " " SAME LOW FACE
- 2" ALDER, S65°E, 4.0, TAG ONLY

Location & Comments

CAP IS 0.3' HIGH
IN LOCAL NOT-
DISTURBED GROUND.
ON A LANDING.
USED SILVA
HAND COMPASS
AND SPENCER
STEEL TAPE.

Compass Declination 19°E
Firm/Agency ENGR. DEPT.
INTERNATIONAL PAPER
Address 711 PORT DOCK RD
REEDSPORT, OR
Party Chief A. BLACHLY
Notes A. BLACHLY
Witness ROBERT HARTE
SANDRA ROSENKRANCE

Surveyor's Seal

REGISTERED
PROFESSIONAL
LAND SURVEYOR

JPB

OREGON
JULY 26, 1985
ANDREW T. BLACHLY
2168

File No. 63/154(26)