

M 121-52

FILED

Date: 2-16-95 By: JC
This survey consists of:
Map: M 121-52
Narrative: _____
Corner Rpt: C.S. 63/161


OREGON CORNER RESTORATION FORM

Section 34 Township 26S Range 3W

County Douglas Date Feb. 3, 195

DOUGLAS COUNTY
SURVEYOR

Corner Designation

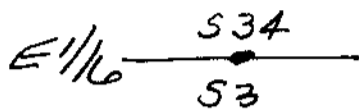

- Condition Report Only
- Not Found
- Renewed
- Unrecorded
- Surveyed In
- Referenced Out

Previous Renewals/Surveys, etc. _____


U.S.B.L.M., 1958,

Monument(s) & Accessories Found: (Condition and Source)

Found 3 1/4" Brass Cap on 2 1/2" Iron Post, from which a:
18" Cedar BT (record 12"), face overgrown, bears
N 46° E (record N 44 1/2° E), 72.5 Feet (record 73.9 Feet).
22" Cedar BT (record 10"), face overgrown, bears
S 73 3/4° W, 98.5 Feet (record 99.7 feet).

Monument Detail

Sketch

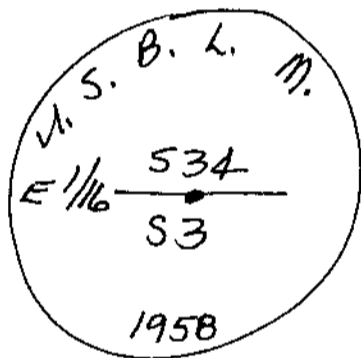

Monument Set (Procedures and Description)

None.

New Accessories

Set 6 foot Steel Post at North, 10 feet from corner.

Location & Comments

350 feet South
from E-W
Logging Road.

Compass Declination 21° E

Firm/Agency Shaner
Engineering, Inc.

Address P.O. Box 1430
Roseburg, Oregon 97440

Party Chief B. Shaner

Notes " "

Witness Jack Wright

Surveyor's Seal

REGISTERED
PROFESSIONAL
LAND SURVEYOR

Bruce A. Shaner

OREGON
OCT. 4, 1957
BRUCE A. SHANER
430

Expires June 30, '96

C.S. File No. 103/161-1