

M121-52

FILED

Date: 2-16-95 By: JC

This survey consists of:  
Map: M121-52

Narrative:  
Corner Rpt: C.S. 63/16

OREGON CORNER RESTORATION FORM

Section 34 Township 26S Range 3W

County Douglas Date Feb. 3, 195

DOUGLAS COUNTY  
SURVEYOR

Corner Designation

South  $\frac{1}{4}$ S, Sec. 34  
=  $\frac{1}{4}$ S  $\frac{534}{53}$

- Condition Report Only
- Not Found
- Renewed
- Unrecorded
- Surveyed In
- Referenced Out

Previous Renewals/Surveys, etc.

U.S. B.L.M. Survey, August- November, 1958.

Monument(s) & Accessories Found: (Condition and Source)

Found as recorded.

Monument Detail

Sketch

N/A

Monument Set (Procedures and Description)

N/A



New Accessories

N/A

Location & Comments

Surveyor's Seal

Compass Declination 21°E  
 Firm/Agency Shaner Engineering, Inc.  
 Address P.O. Box 1430  
Roseburg, Oregon 97470  
 Party Chief B. Shaner  
 Notes " "  
 Witness Jack Wright

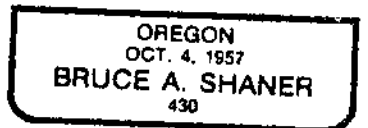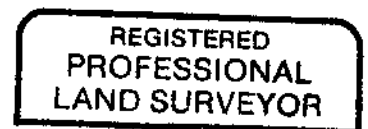

Expires June 30, '96

C.S. File No. 63/16-2