

FILED

Date: 2/15/95 By: BC
This survey consists of:
Map: M 121-49
Narrative: _____
Corner Rpt: CS 63/161


OREGON CORNER RESTORATION FORM

Section 2 Township 27S Range 3W

County Douglas Date Feb. 3, '95

DOUGLAS COUNTY
SURVEYOR

Corner Designation

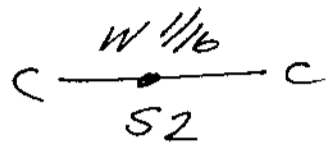


- Condition Report Only
- Not Found
- Renewed
- Unrecorded
- Surveyed In
- Referenced Out

Previous Renewals/Surveys, etc. None

Monument(s) & Accessories Found: (Condition and Source)
None

Monument Detail

Sketch

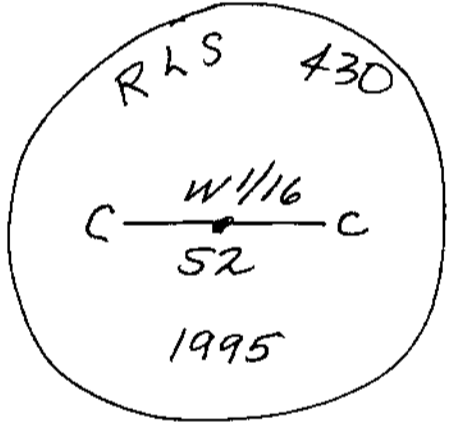

Monument Set (Procedures and Description)

2 1/2 inch Brass Cap on 1" x 30" Galv. Iron Pipe,
on E-W Fence & in Mound of Stone.

New Accessories

6" Oak BT, I scribed "CW 1/16 S 2 BT",
bears N 2° W, 171 Feet.
6" Cedar BT, I scribed "CW 1/16 S 2 BT"
bears N 14° E, 539 Feet.

Location & Comments

on E-W fence
off North end
of Corifer Lane.

Compass Declination 21° E
Firm/Agency Shaner
Engineering, Inc.
Address P.O. Box 1430
Roseburg, OR 97470
Party Chief B. Shaner
Notes " "
Witness Jack Wright

Surveyor's Seal

REGISTERED
PROFESSIONAL
LAND SURVEYOR

Bruce A. Shaner
OREGON
OCT. 4, 1957
BRUCE A. SHANER
430

Expires June 30, '96