

FILED

Date 2/15/96 By BC
Map No. M 121-49
Narrative CS 63/161
Corner No. CS 63/161

OREGON CORNER RESTORATION FORM

Section 2 Township 27S Range 3W

County Douglas Date JAN. 23, 1995

DOUGLAS COUNTY
SURVEYOR

Corner Designation

Center 1/4 Section Corner

- Condition Report Only
- Not Found
- Renewed
- Unrecorded
- Surveyed In
- Referenced Out

Previous Renewals/Surveys, etc.


Ren Geisler, M103-61, 1987.

Monument(s) & Accessories Found: (Condition and Source)

Found 2 1/2" Alum. Cap on 2" Alum. Pipe from which:
8" D. Fir BT, scribes visible, bears N11°E, 59.9 feet.
10" D. Fir BT, face overgrown, bears S85°E (Record
S88°E), 66.5 feet.

Monument Detail

Sketch

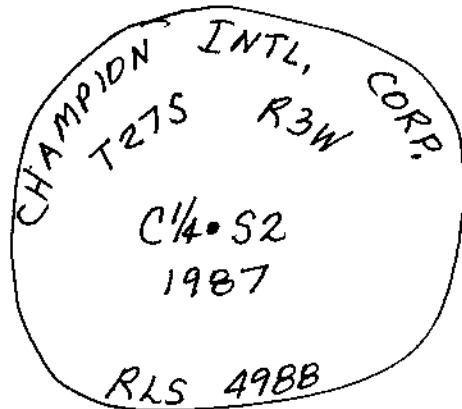

Monument Set (Procedures and Description)

None Set.


New Accessories

6" D. Fir I scribed "C 1/4 S2 BT" bears S71°E,
39.2 feet.
6 Ft. Steel Fence Post, I set, bears South, 1.1 feet.

Location & Comments

About 800 Ft. Compass Declination 21° E
East of Little River Firm/Agency Shaner
Road & on E-W Engineering, Inc
fence line: (actually Address P.O. Box 1430
about 50 feet East Boseburg, OR 97470
of end of said fence) Party Chief B. Shaner
Notes " "
Witness Jack Wright

Surveyor's Seal

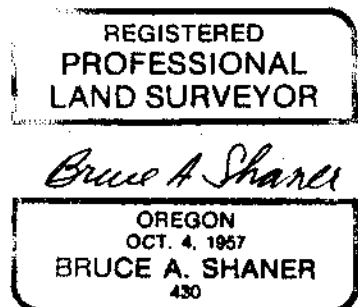

Expires June 30, '96

C.S. File No. 63/161-9