

FILED

Date 5-23-95 By: JP

This survey consists of:

Map: _____

Narrative: _____

Corner Rpt: C.S. 63/161-26

OREGON CORNER RESTORATION FORM

Section 14 Township 30S Range 6W

County DOUGLAS Date 5-4-95

DOUGLAS COUNTY
SURVEYOR

Corner Designation

$\frac{1}{4} \frac{14}{23}$

- Condition Report Only
- Not Found
- Renewed
- Unrecorded
- Surveyed In
- Referenced Out

Previous Renewals/Surveys, etc.


P.L.S.S. 540400

Monument(s) & Accessories Found: (Condition and Source)

- 1/2" IRON PIPE
- 20" OAK N49W 50° FT GOOD HEALED FACE
- 18" OAK S79E 34° FT GOOD OPEN FACE SCRIBE VISIBLE

Monument Detail

Sketch

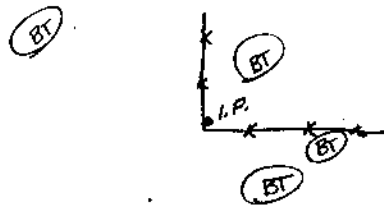

Monument Set (Procedures and Description)

New Accessories

- 11" MADRONE N38E 15⁵ FT SCRIBED "1/4 S BT"
- 11" MADRONE S53E 23⁴ FT SCRIBED "1/4 S BT"

Location & Comments

Surveyor's Seal

Compass Declination 20°

Firm/Agency ROSEBURG FOREST PRODUCTS

Address PO Box 1088

ROSEBURG OR 97470

Party Chief OLSON

Notes MCMANN

Witness _____

