

Date: 7-28-95 By: JP
This survey consists of:
Map: M 122-23
Narrative: _____
Corner Rpt: 63/161-31

OREGON CORNER RESTORATION FORM

Section 25 Township 31S Range 6W

County Douglas Date July 26, 1995

DOUGLAS COUNTY
SURVEYOR

Corner Designation

CS 1/16

- Condition Report Only
- Not Found
- Renewed
- Unrecorded
- Surveyed In
- Referenced Out

Previous Renewals/Surveys, etc. _____


None

Monument(s) & Accessories Found: (Condition and Source)

None

Monument Detail

Sketch

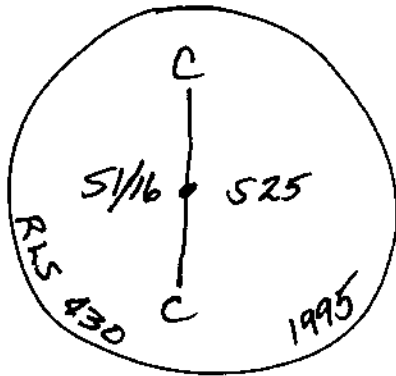

Monument Set (Procedures and Description)

I set a 2" x 30" Iron Pipe with a 3" Brass Cap
Marked as above, and from which a:

New Accessories

10" D. Fir BT, I scribed "CS 1/16 S25 BT" bears N52°W, 12± feet.
8" D. Fir BT, " " " " " " " " bears S48°W, 7± feet.
6 Foot Steel Fence Post bears West, 1± feet.

Location & Comments

See Survey Map.

Compass Declination 18°E

Firm/Agency Shaner
Engineering

Address P.O. Box 1430
Roseburg, Oregon 97470

Party Chief B. Shaner

Notes " "

Witness Brian Rabern
David Snyder

Surveyor's Seal

REGISTERED
PROFESSIONAL
LAND SURVEYOR

Bruce A. Shaner

OREGON
OCT. 4, 1957
BRUCE A. SHANER
430

Renews 6-30-96

C.S. File No. 63/161-31