

Date: 7-28-95 By: JP

This survey consists of:  
Map: M 122-23

Narrative: \_\_\_\_\_  
Corner Rpt: C.S. 63/161-32

OREGON CORNER RESTORATION FORM

Section 25 Township 31S Range 6W

County Douglas Date July 26, 1995

DOUGLAS COUNTY  
SURVEYOR

Corner Designation

SE 1/16

- Condition Report Only
- Not Found
- Renewed
- Unrecorded
- Surveyed In
- Referenced Out

Previous Renewals/Surveys, etc. \_\_\_\_\_


None

Monument(s) & Accessories Found: (Condition and Source)

None

Monument Detail

Sketch

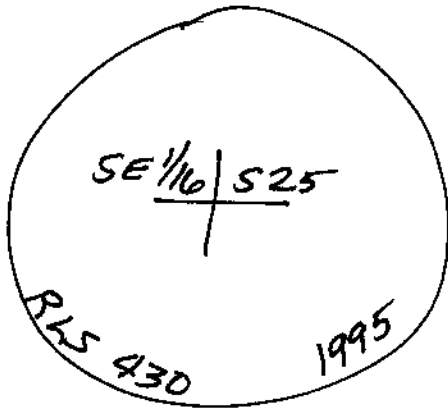

Monument Set (Procedures and Description)

I set a 2"x30" Iron Pipe with a 3" Brass Cap, marked as above, and from which a:

New Accessories

10" D. Fir BT, I scribed " SE 1/16 S25 BT" bears S79°W, 46.6 Feet.  
12" D. Fir BT, " " " " " " " " bears N38°E, 4.1 Feet.  
6 Foot Steel Fence Post, North, 1.0 feet.

Location & Comments

Corner sets in a small draw which falls Easterly.

Compass Declination 10°E

Firm/Agency Shaner Engineering

Address P.O. Box 1430 Roseburg, Oregon 97470

Party Chief B. Shaner

Notes B. Shaner

Witness David Snyder

Brian Rabern

Surveyor's Seal

