

FILED

Date: 7-28-95 By: JP

This survey consists of:

Map: M 122-23

Narrative: \_\_\_\_\_

Corner Rpt: CS 63/161-33

OREGON CORNER RESTORATION FORM

Section 25 Township 31S Range 6W

County Douglas Date July 26, 1996

Corner Designation

C 1/4

DOUGLAS COUNTY  
SURVEYOR

- Condition Report Only
- Not Found
- Renewed
- Unrecorded
- Surveyed In
- Referenced Out

Previous Renewals/Surveys, etc. \_\_\_\_\_


None.

Monument(s) & Accessories Found: (Condition and Source)

None.

Monument Detail

Sketch

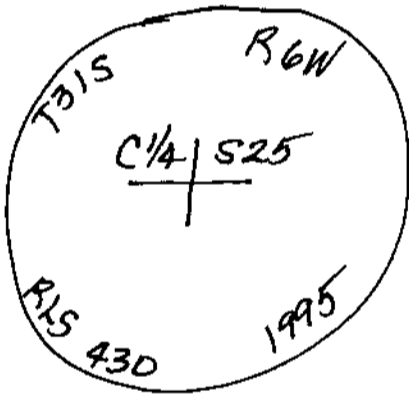

Monument Set (Procedures and Description)

I set a 2" x 30" Iron Pipe with a 3" Brass Cap, marked as above, and from which a:

New Accessories

- 8" D. Fir BT, I scribed "C 1/4 S 25 BT", bears N 38° E, 18 1/2 feet.
- 8" Pine BT, I scribed "C 1/4 S 25 BT" bears due East, 14 1/2 feet.
- 10" D. Fir BT, " " " " " " " bears S 7° E, 24 3/4 feet.
- 6" Pine BT, " " " " " " " bears S 36° W, 37 feet.
- 6 Ft. Steel Fence Post bears West, 1 1/2 feet.

Location & Comments

Corner is 400 Ft. South of USBLM Road. Tagged in ing

Compass Declination 18° E

Firm/Agency Shaner Eng-

Address P.O. Box 1430

Roseburg, Oregon 97470

Party Chief B. Shaner

Notes B. Shaner

Witness David Snyder

Brian Rabern

Surveyor's Seal

REGISTERED  
PROFESSIONAL  
LAND SURVEYOR

Bruce A Shaner

OREGON  
OCT. 4, 1957  
BRUCE A. SHANER  
430

Renews 6-30-96

C.S. File No. 63/161-33