

GOVERNMENT CORNER RESTORATION FORM

FILED

Township 27 S Range 5 W Sec. 31 County DOUGLAS

SEP 27 1989

State OR Date 9/21/89 No. _____

COUNTY SURVEYOR
DOUGLAS COUNTY, ORE.

Corner Designation _____

536 | 531

51

- ____ Condition Report Only
- ____ Not Found
- Renewed
- ____ Unrecorded
- ____ Surveyed In
- ____ Referenced Out

Previous Renewals #23 T27-5 #112 T27-6

Monument(s) Found: (Condition and Source)

3/4" DIA IRON BOLT PROTRUDING 6 IN
ABOVE GROUND, BOLT LEANS 4 IN.
WEST OF PLUMB. (FROM REN #23)

N/A

Accessories Found:

ORIG. 20" W. OAK NOW 41" DIA B. OAK WITH A FULLY HEALED SINGLE
BLAZE, TREE IS ROTTED IN CENTER ON NW SIDE SHOWS EVIDENCE OF
PREVIOUS AXE WORK, BEARS N 24 1/2° E, 295.7 FT (REC. N 22 1/4° E,
291.1 FT) NOTE; TREE IS OVER A RISE AND NOT VISIBLE FROM CORNER.

ORIG. 20" NOW 40" DIA 8 FT HIGH ROTTED OAK SNAG WITH A PREVIOUSLY
OPENED BLAZE, REVERSE SCRIBING VISIBLE "T S" BEARS N 50 1/2° W,
232.3 FT (AGREES WITH RECORD).

12" NOW 12" DIA. W. OAK WITH A FULLY HEALED DOUBLE BLAZE
BEARS N 22° W, 58.5 FT (AGREES WITH RECORD) FROM REN # 23

14" NOW 18" DIA. W. OAK WITH A FULLY HEALED DOUBLE BLAZE
BEARS N 84° E, 20.6 FT (RECORD N 81 1/2° E, 20.0 FT) FROM REN # 23

#111 T27-5 ✓

#184 T27-6 ✓

FILE NO. 6411-4 c

RENEWAL

Monument Set (Procedure and Description)

A 2 3/8" DIA DCSO BRASS CAP ON A 1 3/8" OD.
 BY 32 IN LONG IRON PIPE IS SET
 AT REFERENCED PLUMB POSITION OF REN#23
 3/4" DIA IRON BOLT. DCSO BC/IP PROTRUDES
 7 IN ABOVE GROUND.

3/4" DIA IRON BOLT FROM REN#23 MEASURES
 30" LONG IS SET ALONG NORTH SIDE OF
 DCSO BC/IP, PROTRUDES 5 IN. ABOVE
 GROUND.


Monument Detail

DOUGLAS COUNTY SURVEYORS
 T27S
 R6W | R5W
 S36 | S31
 T28S R6W
 S1
 1989

New Accessories

7" DIA W. OAK DOUBLE BLAZED AND SCRIBED "T27S R5W S31 CS BT"
 BEARS N 1 1/2° E 27.7 FT.

Sketch of Monument, Accessories, and General Area

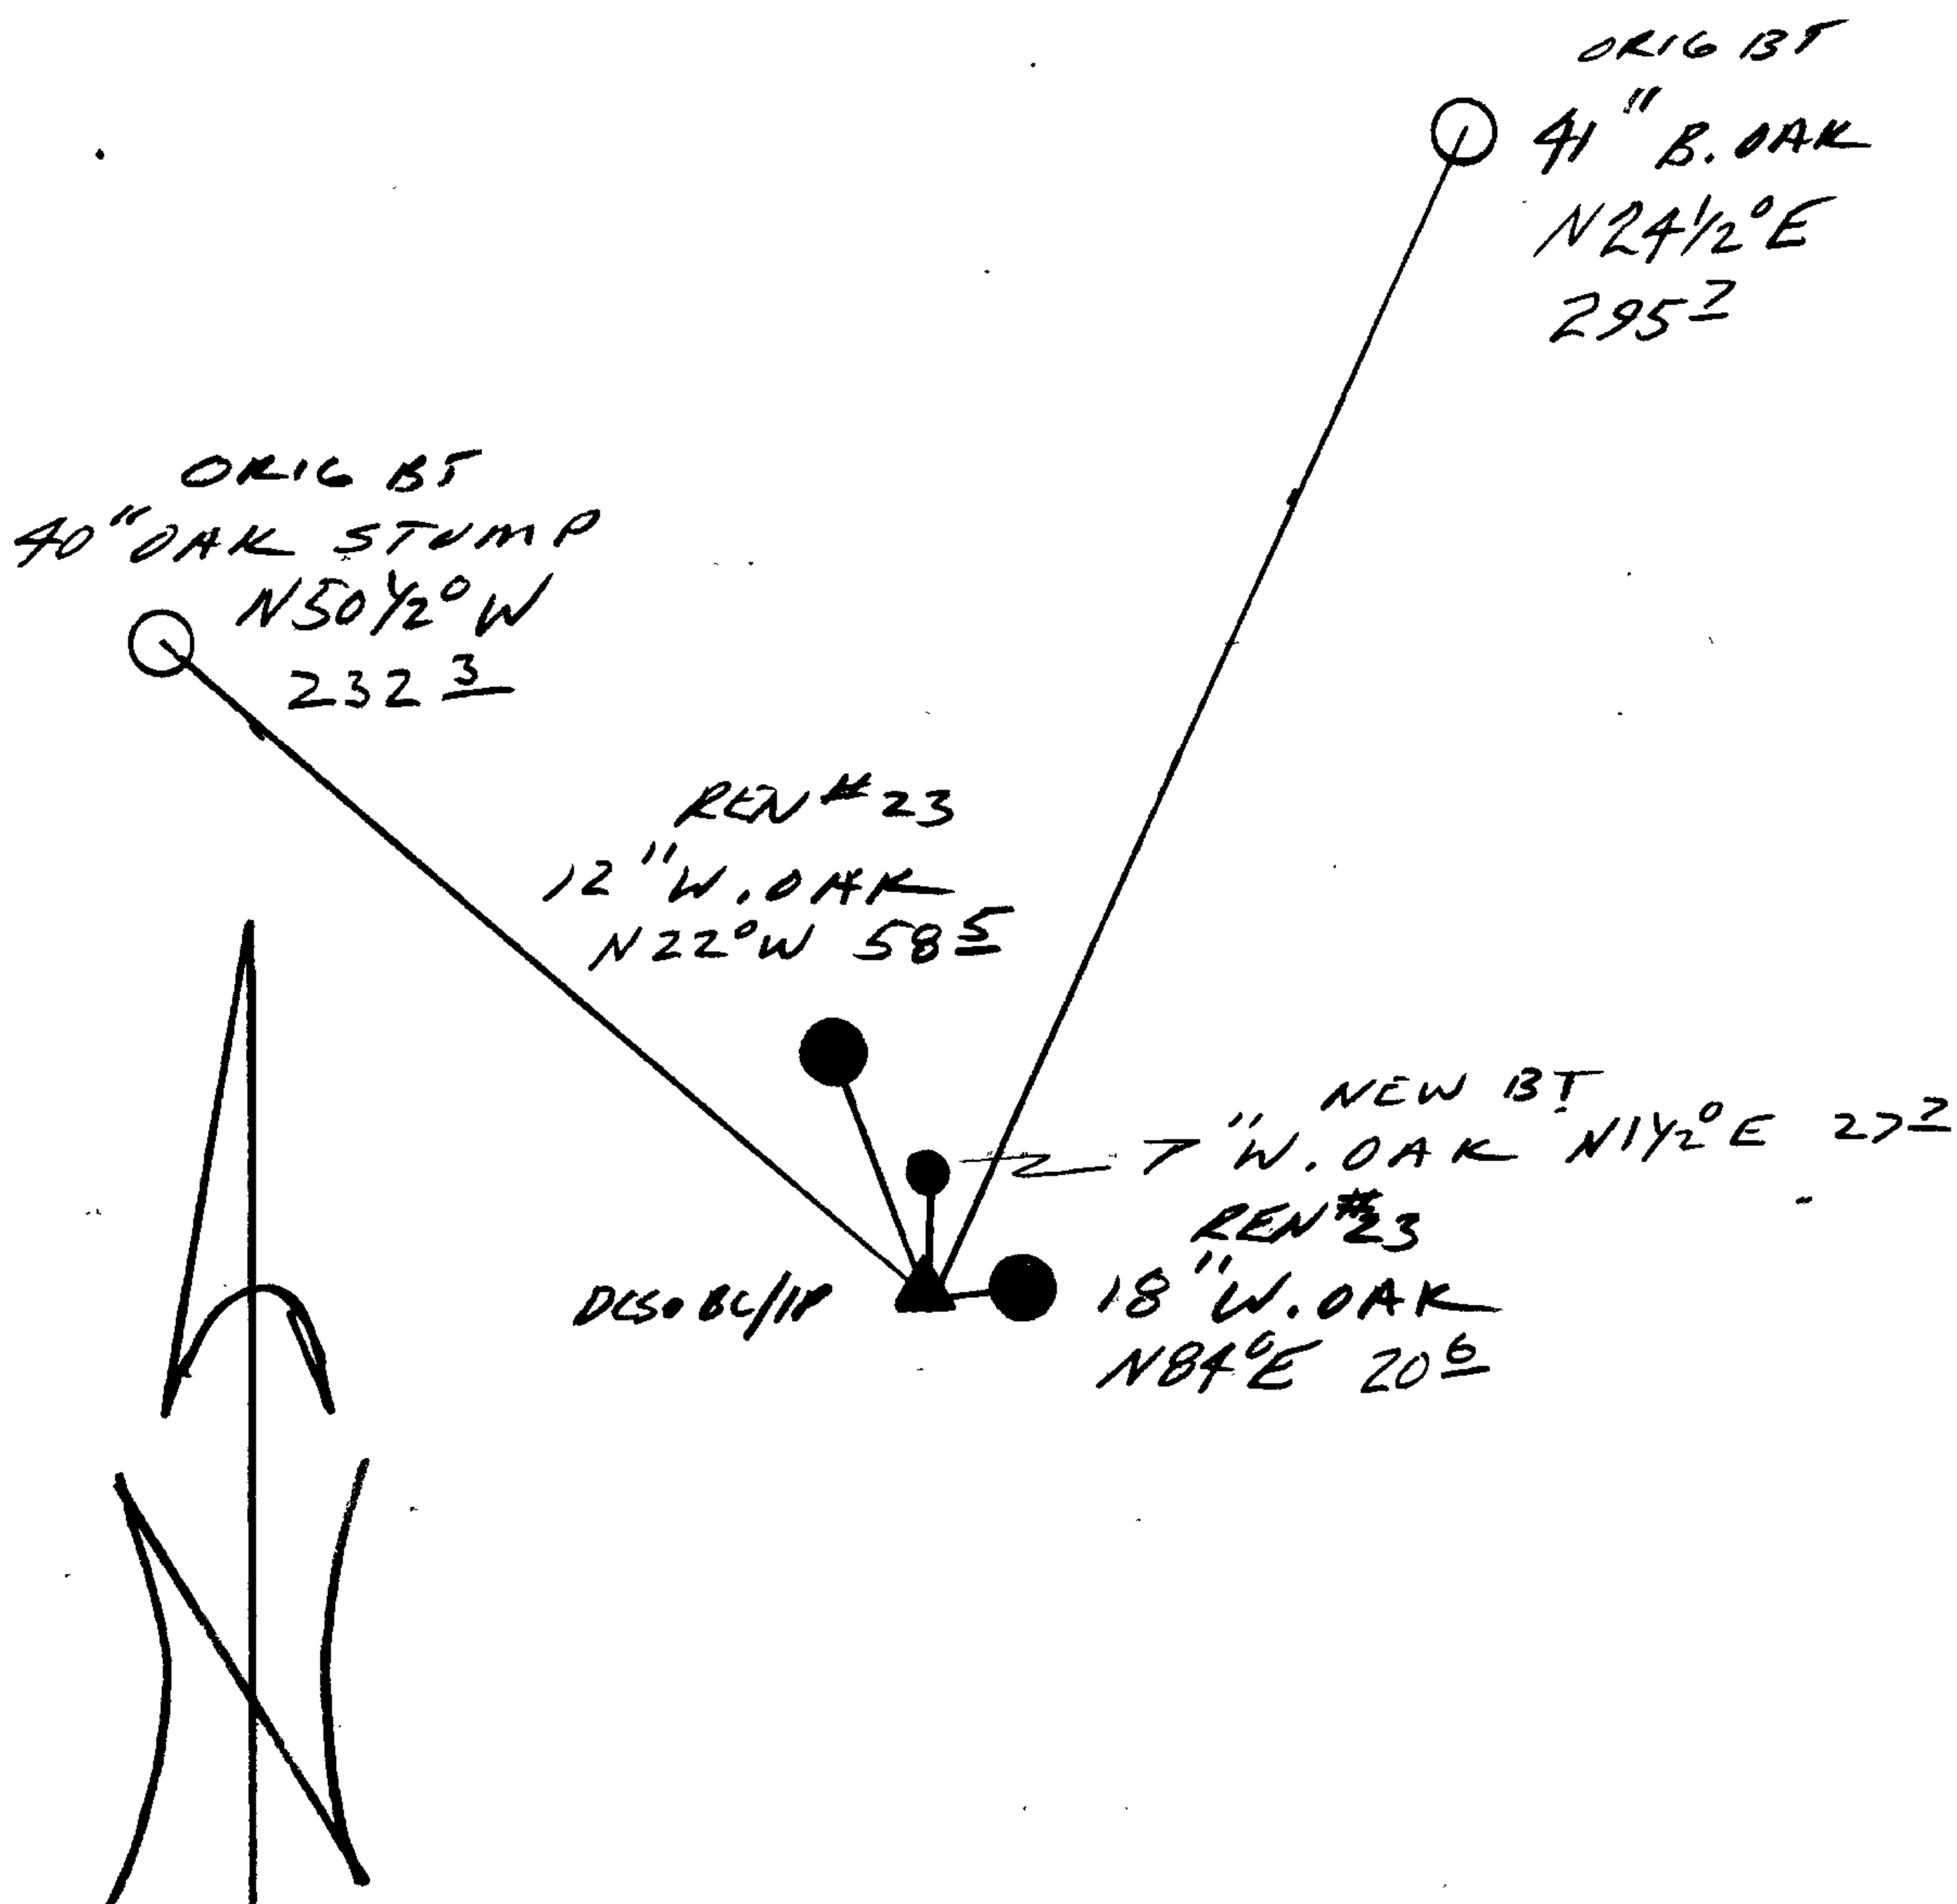

Location & Comments

Comp. Declin. 18° E
 Agency DCSO
 Party Chief RANDALL W SMITH
 Notekeeper Randall W Smith
 Witnesses STEPHEN J FLAUSE

Address

Surveyor's Seal

REGISTERED
 PROFESSIONAL
 LAND SURVEYOR

Larry E. Monrean
 OREGON
 JULY 13, 1979
 LARRY E. MONREAN
 #1830