

GOVERNMENT CORNER RESTORATION FORM

Township 28S Range 7W Sec. 19 County DOUGLAS

State OR Date 8/2/89 No. _____

Corner Designation

$\frac{1}{4}$ S19
S30

- _____ Condition Report Only
- _____ Not Found
- Renewed
- _____ Unrecorded
- _____ Surveyed In
- _____ Referenced Out

Previous Renewals 1924 RESURVEY, #178, #269

Monument(s) Found: (Condition and Source)

NONE FOUND.

MONUMENT DETAIL

N/A

Accessories Found:

- 8" NOW 10" DIA. W. OAK W/ OPEN SINGLE BLAZE AND FIND PARTIAL SCRIBING "S", BEARS N42¹/₄°W, 17.2 FT. (AGREES WITH RECORD) 1924 RESURVEY
- 8" NOW 36" DIA. D. FIR. WITH A FULLY HEALED SINGLE BLAZE BEARS S48°W, 8.6 FT (REC. S48°W, 9.6 FT FITS WITH NAIL FOUND IN CENTER OF TRUNK 5 FT ABOVE GROUND) REN#178) 1924 RESURVEY
- 7" NOW 7" DIA. 18 FT HIGH, DEAD OAK SNAG, WITH A PARTIALLY HEALED DOUBLE BLAZE, SCRIBING VISIBLE "YAS19CS BT". BEARS N2°W, 18.7 FT. (AGREES WITH RECORD) REN#178
- 18" NOW 21" DIA. D. FIR WITH NEWLY AXED OFF BARK ON FACE, BULKY WOOD SEEN, SCRIBING PROBABLY NOT AXED OUT. BEARS N55°E, 15.6 FT. (AGREES WITH RECORD) REN#178

#272 x

C.S. File No. 641-9C

RENEWAL

Monument Set (Procedure and Description)

A 2 3/8" DIA BRASS CAP ON A
1 3/8" O. D. BY 32" LONG I.P. PROTRUDES 15 IN
ABOVE GROUND. BC/IP IS SURROUNDED
BY A 2 1/2 FT DIA. MOUND OF STONE.


Monument Detail

DOUGLAS COUNTY SURVEYORS
T285
S19
1/4 ———
S30
R7W
1989

New Accessories

N/A

Sketch of Monument, Accessories, and General Area

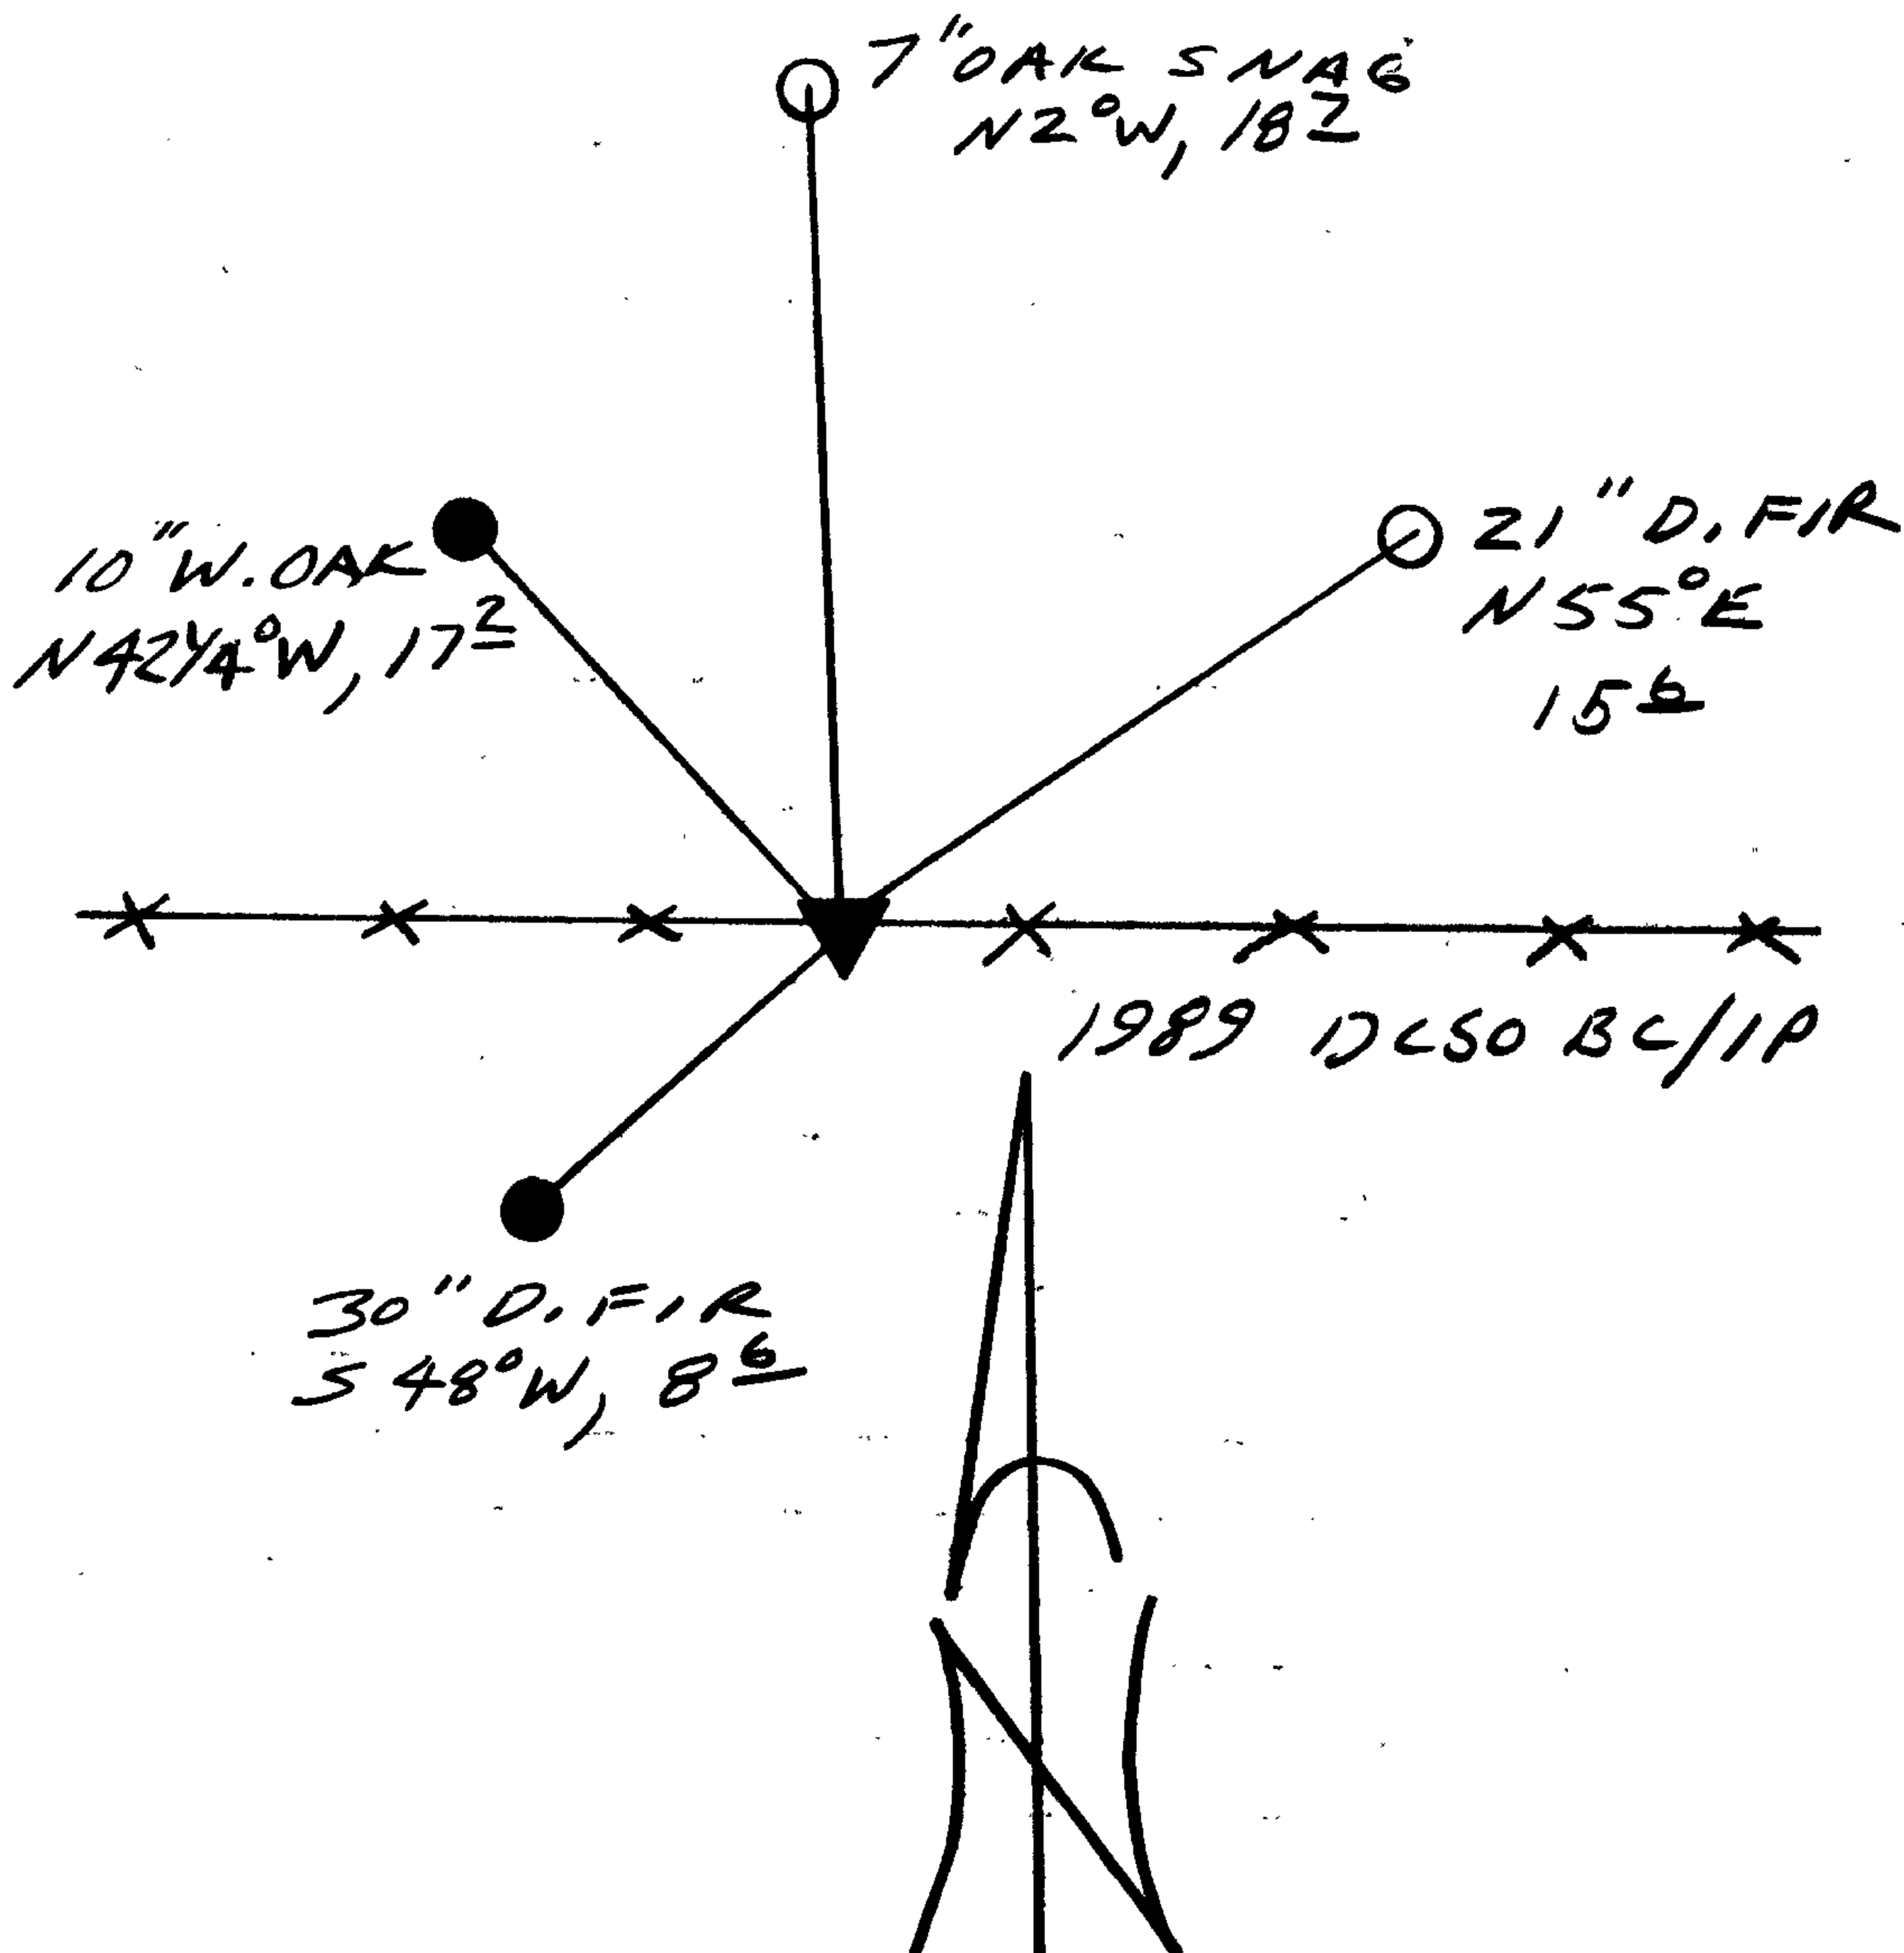

Location & Comments

Comp. Declin. 18° E
Agency DCSO
Party Chief RANDALL W SMITH
Notekeeper Randall W Smith
Witnesses STEPHEN J FLAUSE

Address

Surveyor's Seal

REGISTERED
PROFESSIONAL
LAND SURVEYOR

Larry E. Monream

OREGON
JULY 13, 1979
LARRY E. MONREAM
#11330