


GOVERNMENT CORNER RESTORATION FORM

Township 28S Range 7 1/2 W Sec. 30 County DOUGLAS

State OR Date 8/7/09 No. _____

Corner Designation

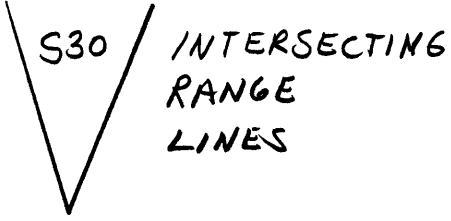


- Condition Report Only
- Not Found
- Renewed
- Unrecorded
- Surveyed In
- Referenced Out

Previous Renewals 1924 RESURVEY

Monument(s) Found: (Condition and Source)

A 1924 3 3/8" DIA. GLO BRASS
CAP ON A 3" O.D. IRON PIPE.
PROTRUDING 8" ABOVE BOTTOM OF A
10 FT DIA. BY 26" DEEP HOLE. RC/IP
IS 18 IN BELOW GROUND LEVEL.
(FROM 1924 GLO RESURVEY).

U.S. GENERAL LAND OFFICE SURVEY

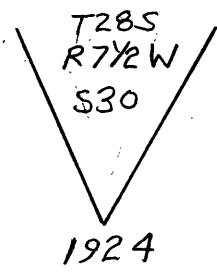

MONUMENT DETAIL

Accessories Found:

A GLO 2 1/2" DIA BRASS CAP ON A 1" O.D. IRON PIPE. BRASS CAP
STAMPED "APP TR 61 1924" (LEADING 0.5 FT SOUTH FROM PLUMB) SET FLUSH WITH BOTTOM
OF A 5 FT DIA. BY 18 IN DEEP HOLE. BEARS N 3° E
31.98 FT (REC. N 1 1/2° E 31.7 FT FROM 1924 M+B SURVEY
OF TRACT NO. 61 T28S R7W). HOLE IS TO BE FILLED UP
IN NEAR FUTURE BY PROPERTY OWNER.

#19 (in R7 1/2 W)

Resurvey of E. Bdy. T 28 S., R. 8 W.
(Hathorn Survey)

CHAINS

39.79

Intersect the point for cor.. of secs. 19, 24, 25, and 30,
located by record measurement from the original bearing
trees.

At the exact cor. point

Set an iron post, 3 ft. long, 2 ins. diam., 27 ins. in the
ground, for cor. of secs. 19, 24, 25, and 30, with
brass cap marked

T28S
R8W:R7 $\frac{1}{2}$ W
S24:S19
S25:S30
1924

from which (new bearing trees)

A fir, 10 ins. diam., bears N.46*E., 26 lks. dist.,
marked T 28 S R 7 $\frac{1}{2}$ W S 19 B T.

A fir, 20 ins. diam., bears S.54*E., 30 lks. dist.,
marked T 28 S R 7 $\frac{1}{2}$ W S 30 B T.

A fir, 12 ins. diam., bears S.37*W., 29 lks. dist.,
marked T 28 S R 8 W S 25 B T.

A fir, 14 ins. diam., bears N.14*W., 19 lks. dist.,
marked T 28 S R 8 W S 24 B T.

Original bearing tree, a black oak, 36 ins. diam., bears
N.58*E., 30 lks. dist., marks legible.

Original bearing tree, a black oak, 24 ins. diam., bears
S.72*E., 75 lks. dist., blazes plain.

Original bearing tree, a black oak, snag, bears S.65*W.
(not S.72*W.), 30 lks. dist., marks rotted away.

Original bearing tree, a black oak, rotted down, stump
hole shows position, bears N.11*W. (not N.18*W.), 38
lks. dist.

Land, mountainous.

Soil, rocky 4th rate.

Timber, fir, and oak.

Undergrowth, oak and fir.

S.0*32*W., along the E. bdy. of sec. 25.

Over mountainous land, through scattering timber and

County Surveyor's Record, Douglas County, Oregon

5819

Resurvey of E. Bdy. T. 28 S., R. 8 W.
(Hathorn Survey)

CHAINS

undergrowth.

Descend over SE. slope, 317 ft.

29.15 Draw, course SW.; ascend along W. slope, 51 ft.

33.85 Top of spur, slopes SW.; descend SE. slope, 44 ft.

39.22 Old fence, bears E. and W.

39.73 Intersect the point for $\frac{1}{4}$ sec. cor., located by record measurement from the original bearing trees.

At the exact cor. point

Set an iron post, 3 ft. long, 1 in. diam., 28 ins. in the ground, for $\frac{1}{4}$ sec. cor., with brass cap marked

$\frac{1}{4}$
S25 S30
R7 $\frac{1}{2}$
1924

from which

A black oak, 10 ins. diam., bears N.31 $\frac{1}{2}$ *E., 102 lks. dist., marked $\frac{1}{4}$ S 30 BT (by county survey).

A black oak, 18 ins. diam., bears N.81 $\frac{1}{2}$ *W., 111 lks. dist., marked $\frac{1}{4}$ S 25 B T (by county survey).

I mark

A black oak, 10 ins. diam., bears N.13*E., 50 lks. dist., marked $\frac{1}{4}$ S 30 R 7 $\frac{1}{2}$ B T.

Original bearing tree, a black oak stump, bears N.35*W., 164 lks. dist.

Original bearing tree, a black oak stump, bears N.30*E. (not N.23*E.), 207 lks. dist.

From this cor. the NE. cor. of the A.E.Lathrop D.L.C. No. 37 bears S.35*15'W., 12.56 chs. dist.

Thence from the $\frac{1}{4}$ sec cor.

S.0*24'E., along the E. bdy. of sec. 25.

descend gradual SE. slope, 145 ft. to sec. cor.

2.45 Enter grain field, bears NE. and W.

9.89 Intersect the range line bet. Tps. 28 S., Rs. 7 and 8 W., as established by Ford, at 13.53 chs. N.1*30'E. from Ford's cor. of secs. 25, 30, 31, and 36, hereafter described.

At the point of intersection

C.S. File No. 6411

County Surveyor's Record, Douglas County, Oregon

Resurvey of E. Bdy. T. 28 S., R. 8 W.
(Hathorn Survey)


X
N-S LINE

CHAINS
PROT
AIRBOUR
3 3/8" BC
DES 50/812
BO2
353 1/4 E
96.77

Set an iron post, 3 ft. long, 3 ins. diam., 27 ins. in the ground, for cor. of T. 28 S., R. 7 1/2 W., with brass cap marked

U.S. GENERAL LAND OFFICE SURVEY

BO1
101.37

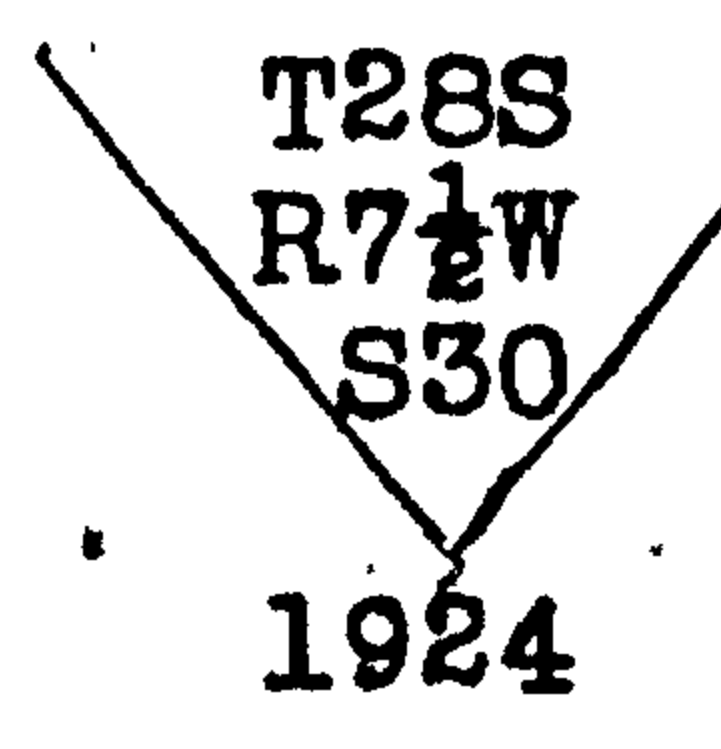

3 3/8" BC
3" I.P.
PROTRUDES
8" OUT OF HOLE
WILL BE APPROX

In cultivated field, no accessories available. 1/2 FT BELOW SURFACE IN GROUND

- 17.50 Small draw, course SE.
- 19.25 NW. cor. of a barn.
- 21.40 Board fence, bears NW. and SE.; leave grain field.
- 21.70 Road, bears NW, and SE.
- 22.95 Fence, bears NW. and SE.; enter grain field.
- 23.42 Intersect the line bet. secs. 30 and 31, T. 28 S., R. 7 W., S. 88° 23' E., 45 lks. from the Ford cor. of secs. 25, 30, 31, and 36, hereafter described.


NE COR DCC 37
494.74 FT

AP.
31.98

10 FT DIA
BY 26" DEEP HOLE

At the point of intersection

Set an iron post, 3 ft. long, 2 in. diam., 27 ins. in the ground, for resurvey cor. of secs. 30 and 31, T. 28 S., R. 7 W., with brass cap marked

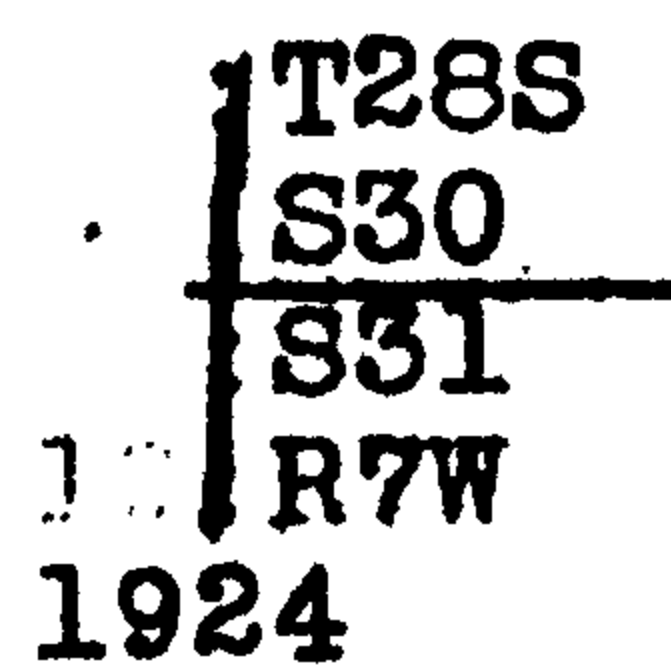

from which (trees marked by county surveyor)

A white oak, 36 ins. diam., bears N. 82 1/2° E., 976 lks. dist., marked C S T 28 S R 7 W S 30 B T.

A white oak, 24 ins. diam., bears S. 70° E., 811 lks. dist., marked C S T 28 S R 7 W S 31 B T.

No nearer trees available.

- 40.00 Enter bed of Ten Mile Creek, course NE.
- 40.19 Intersect true point for Hathorn's cor. of secs. 25, 30, 31, and 36, now in bed of Ten Mile Creek, old cor. and all bearing trees washed out, point identified by county surveyor, who states as follows in recorded field notes:

C.S. File No. 641

US GENERAL LAND OFFICE SURVEY

AP 2
TR 61

1924

2 1/2" BC

1" OD I.P.

1/2 FT BELOW GND
SURFACE

A ~~11~~ 5 FT DIA. ~~1 1/2~~ FT 18" DEEP
DEEP HOLE