

GOVERNMENT CORNER RESTORATION FORM

FILED

Township 315 Range 9W Sec. 28 County DOUGLAS

JAN 3 1990

State OREGON Date OCT 24, 1989 No. \_\_\_\_\_

Corner Designation \_\_\_\_\_

NOV 14, 1989

COUNTY SURVEYOR  
DOUGLAS COUNTY, ORE.

- Condition Report Only
- Not Found
- Renewed
- Unrecorded
- Surveyed In
- Referenced Out

1/4 S 29 | S 28

Previous Renewals NONE

MONUMENT DETAIL

Monument(s) Found: (Condition and Source)

A 4" x 4" WOODEN POST ROTTED AT BASE AND UNSTABLE PROTRUDES APPROX 20" FROM SOIL. NO RECORD OF POST IS FOUND FILED AT DC SO. AT BASE OF POST 2 STONES ARE FOUND ONE MEASURING APPROX. 12 x 10 x 5 INCHES THE OTHER APPROX. 8 x 6 x 5 INCHES. THIS CREW WAS NOT ABLE TO DISCERN MAN-MADE MARKS ON EITHER STONE. (THE ORIGINAL STONE WAS 12 x 10 x 5 INCHES AND WAS MARKED 1/4 ON WEST SIDE - A SURVEY CREW WORKING FOR GERALD D. RILEY FELT THE SMALLER STONE SHOWED EVIDENCE OF HAVING BEEN MARKED "1/4". THIS CREW WAS NOT ABLE TO DISCERN SUCH EVIDENCE)

MEASUREMENTS BELOW TAKEN FROM CENTER OF POST.

Accessories Found:

A 14" DBH DOUGLAS FIR WITH AN ILLEGIBLE, COMPOUND-LETTER, CRUISERS MARK (AT HEAD HEIGHT), TWO BLAZE MARKS FACING NORTH AND SOUTH (AT BREST HEIGHT) AND A CRUISERS MARK "I" (SET LOW ON NORTH SIDE OF TREE). BLAZE FACING NORTH TOWARD ABOVE FOUND MONUMENTS IS OPENED NO SCRIBING FOUND ON FACE. THIS TREE BEARS S 5 1/2° W, 15 2 FT. DIST. NO RECORD OF THIS TREE IS FOUND FILED AT DC SO.

A YEW WITH A DOUBLE TRUNK THE NORTHERLY TRUNK MEASURING 18" D.B.H. AND THE SOUTHERLY TRUNK MEASURING 8" D.B.H., HAS BLAZE-LIKE SCARS WITH OPENINGS TO HEARTWOOD; NO SCRIBING OR AXE MARKS ARE FOUND (THESE SCARS ARE POSSIBLY CAUSED BY OLD BURN IN THIS AREA). NORTHERLY TRUNK HAS WHAT APPEARS TO BE A REMNANT OF A CRUISERS MARK SET HIGH ON TREE. SCARS ON SOUTHERLY TRUNK ARE OPENED; NO EVIDENCE OF A BLAZE IS FOUND. THIS TREE HAS AN UNDATED ALUMINUM TAG SHOWING THE CORNER DESIGNATION AND A BEARING AND DISTANCE OF S 34° W 23 3/4 FT. ALSO THE NOTE "PER HINKSON 1946". FROM THE ABOVE FOUND MONUMENTS THIS TREE BEARS N 32° E, 23 1/2 FT. DIST (AN ORIGINAL 12" YEW WAS RECORDED AS BEARING N 38° E, 24 1/4 FT DIST. NO RECORD OF A HINKSON 1946 SURVEY WAS FOUND FILED AT DC SO.


THE ORIGINAL SOUTHWEST BT IS SEARCHED FOR BUT NOT FOUND. ORIGINAL CALL TO CREEK 1 LINK WIDE SOUTH ON SECTION LINE FROM QUARTER CORNER WAS A DISTANCE OF 113 5 FEET. MEASURING FROM ABOVE FOUND MONUMENTS A SMALL CREEK IS FOUND 133 3/4 FT. SOUTH.



- RENEWAL INDICATES BLAZED AND SCRIBED
- RENEWED CORNERS MAY OR MAY NOT BE BLAZED

RENEWED CORNERS  
 WITH BARK SCRIBING  
 NOTED IN RENEWAL  
 NOTES

T 31 S R 9 W

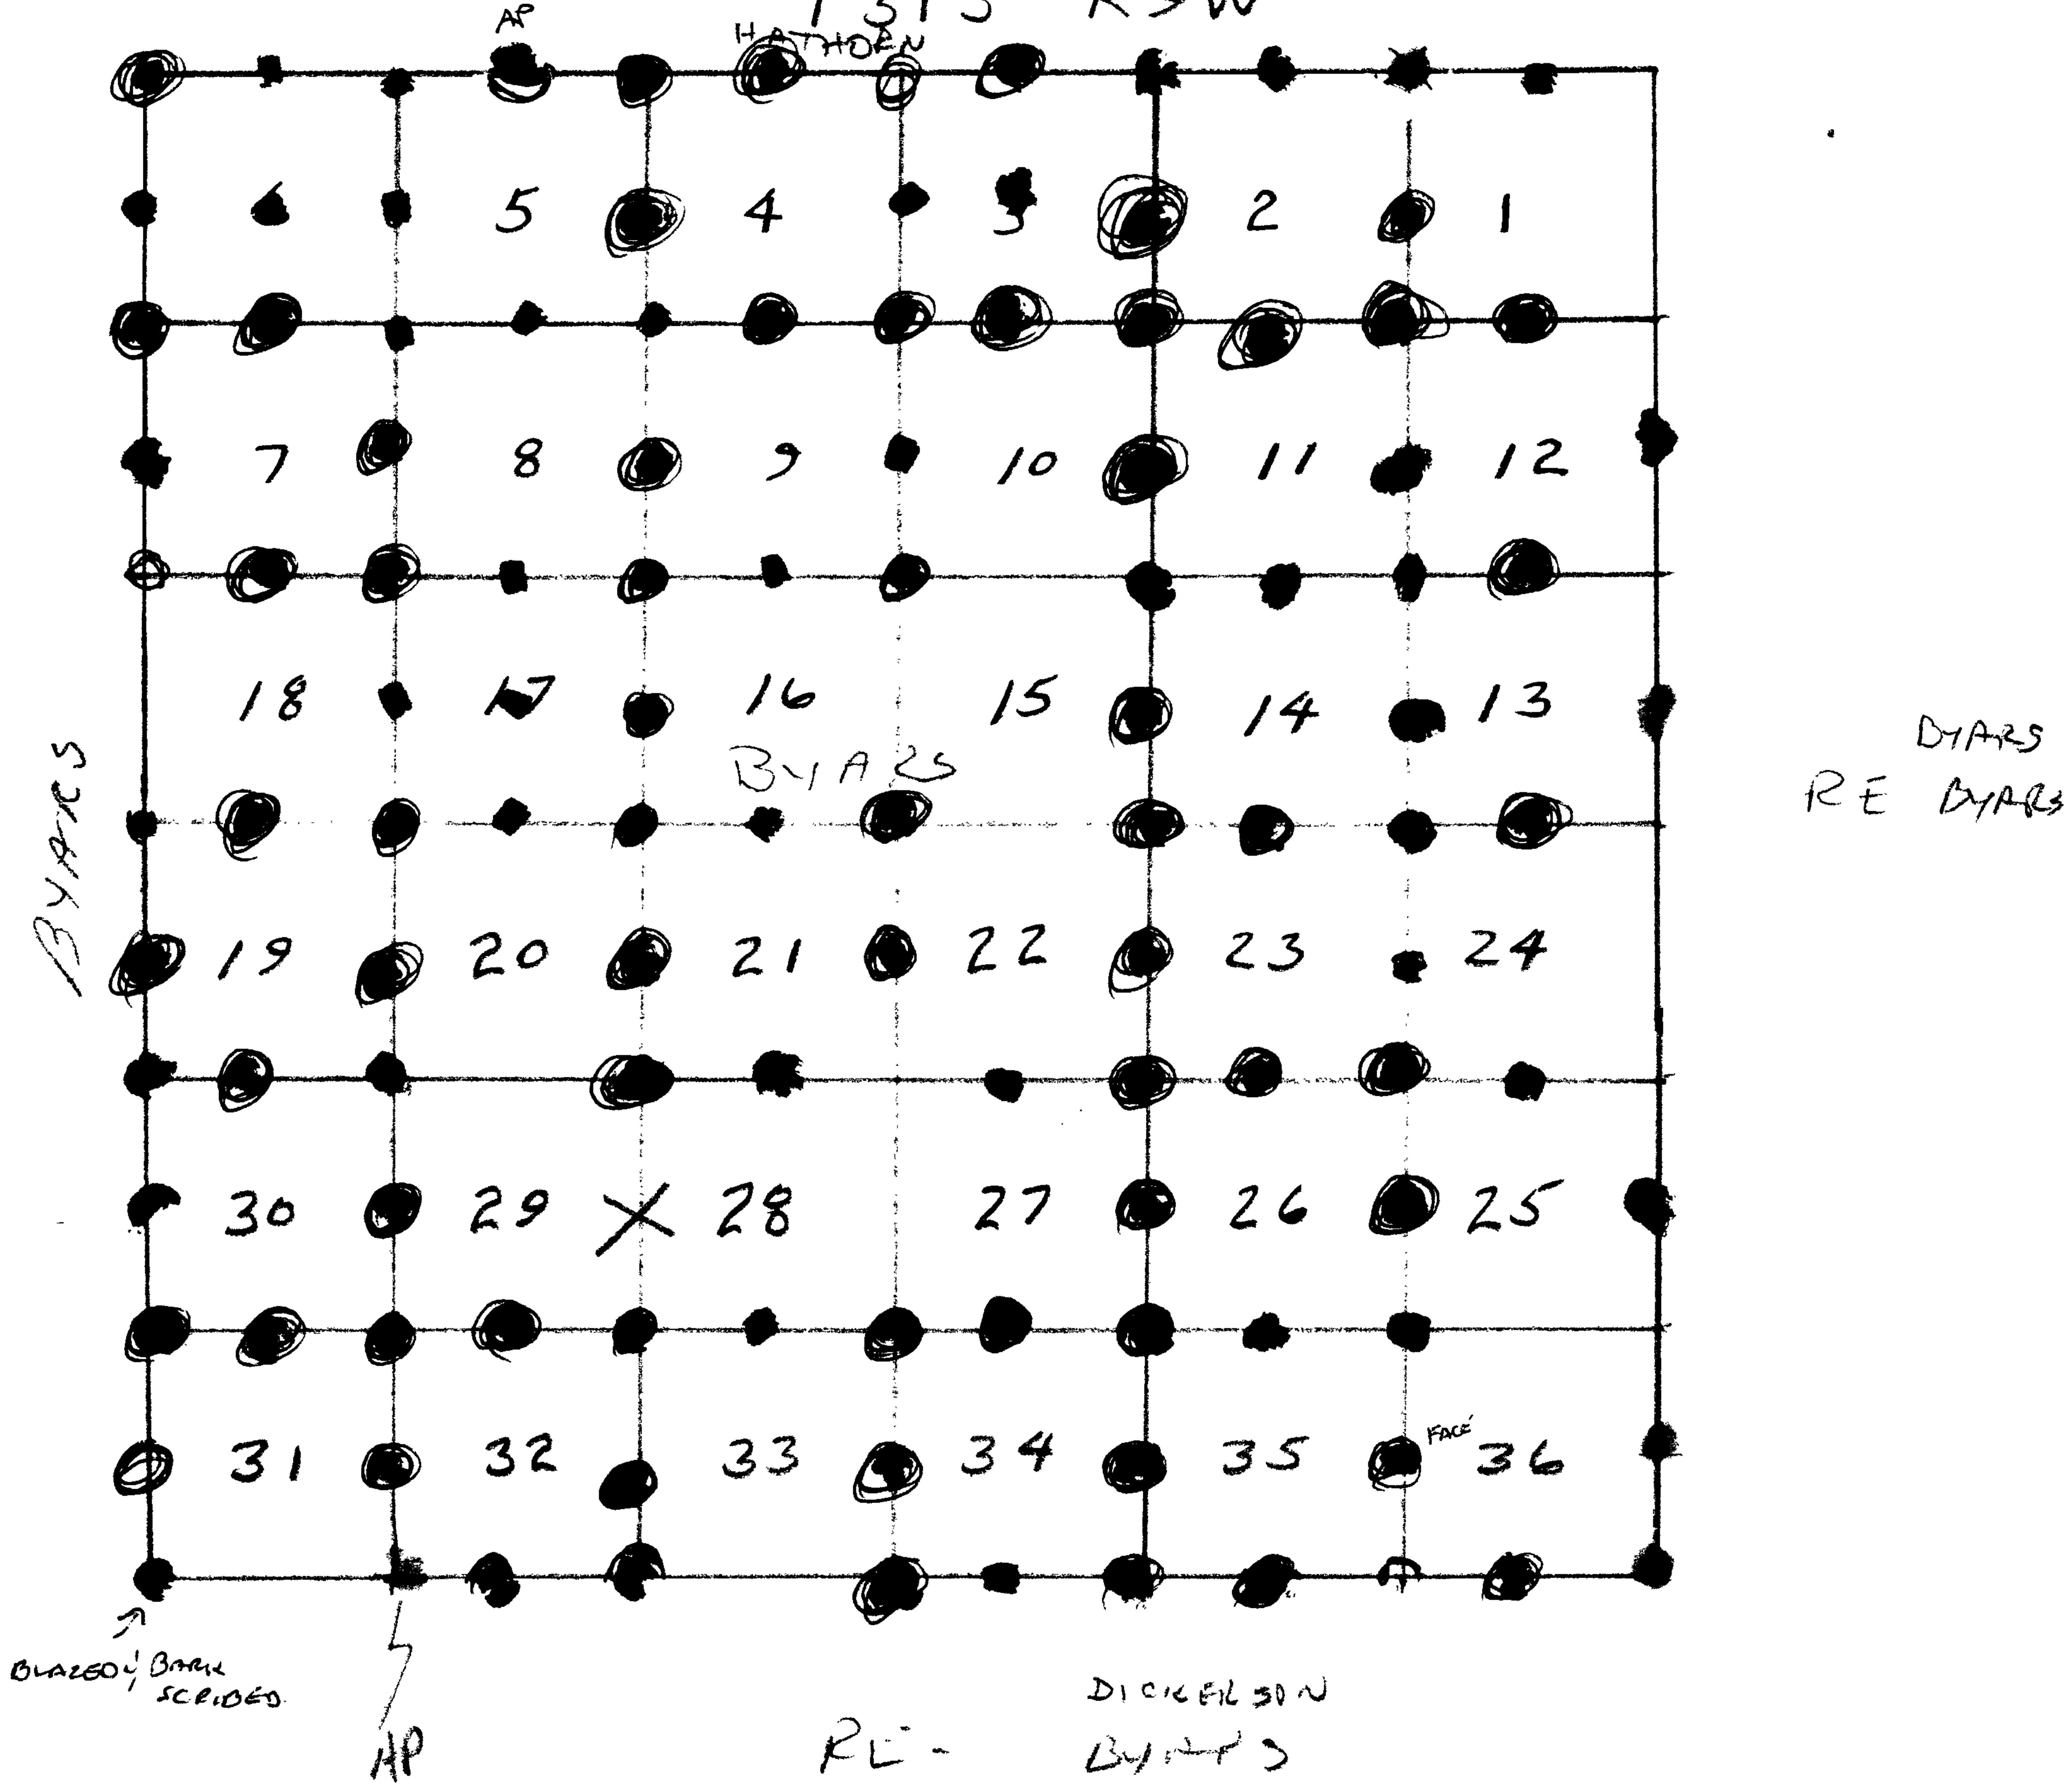

START