

GOVERNMENT CORNER RESTORATION FORM

FILED

Township 27S Range 5W* Sec. 30 County DOUGLAS

State OR Date 1/24/90 No. _____

JAN 31 1990

Corner Designation _____

COUNTY SURVEYOR
DOUGLAS COUNTY, ORE.

- _____ Condition Report Only
- _____ Not Found
- Renewed
- _____ Unrecorded
- _____ Surveyed In
- _____ Referenced Out

1/4 530
531

Previous Renewals #30 #78

Monument(s) Found: (Condition and Source)

A 3/4" I.D. IRON PIPE PROTRUDING
3" ABOVE GROUND. (SOURCE UNKNOWN)

N/A

Accessories Found:

11" NOW 26" DIA. W. OAK WITH A PREVIOUSLY OPENED NOW REHEALED
SCAR, BEARS N6Y4°E, 299.6 FT. (AGREES WITH REC.) ORIG. BT

15" IN REN #78 NOW 18" DIA. W. OAK WITH A FULLY HEALED
DOUBLE BLAZE, BEARS N6°W, 68.7 FT (AGREES WITH REC)
SOURCE UNKNOWN

8" W. OAK, S2°W 189.3 FT FROM REN #78 IS GONE

N-S FENCE NOTED IN REN #78 AS BEING 15 FT EAST IS GONE.

#173

C.S. File No. 64/5-6

RENEWAL

Monument Set (Procedure and Description)

FOUND 3/4" O.D. IRON PIPE IS REFERENCED.
3/4" I.P. IS DUG OUT AND MEASURED 24"
LONG. A 2 3/8" DIA. BRASS CAP ON A 1 3/8" O.D.
BY 31" LONG IRON PIPE IS SET AT REFER-
ENCED POSITION AND PROTRUDES 5" ABOVE
GROUND. 3/4" I.P. IS SET ALONG NORTH SIDE
OF BC/IP AND PROTRUDES 9" ABOVE GROUND.

Monument Detail

DOUGLAS COUNTY SURVEYORS

T 2 7 S


1/4 S 30 R
S 31 5 W

1990

New Accessories

9" W. OAK DOUBLE BLAZED AND SCRIBED " 1/4 S 31 CS BT "
BEARS S 30 1/4° E, 183.0 FT.
7" W. OAK DOUBLE BLAZED AND SCRIBED " 1/4 S 31 CS BT "
BEARS S 35° W, 230.0 FT.
15" W. OAK DOUBLE BLAZED AND SCRIBED " 1/4 S 30 CS BT "
BEARS N 24° W, 97.7 FT.

Sketch of Monument, Accessories, and General Area

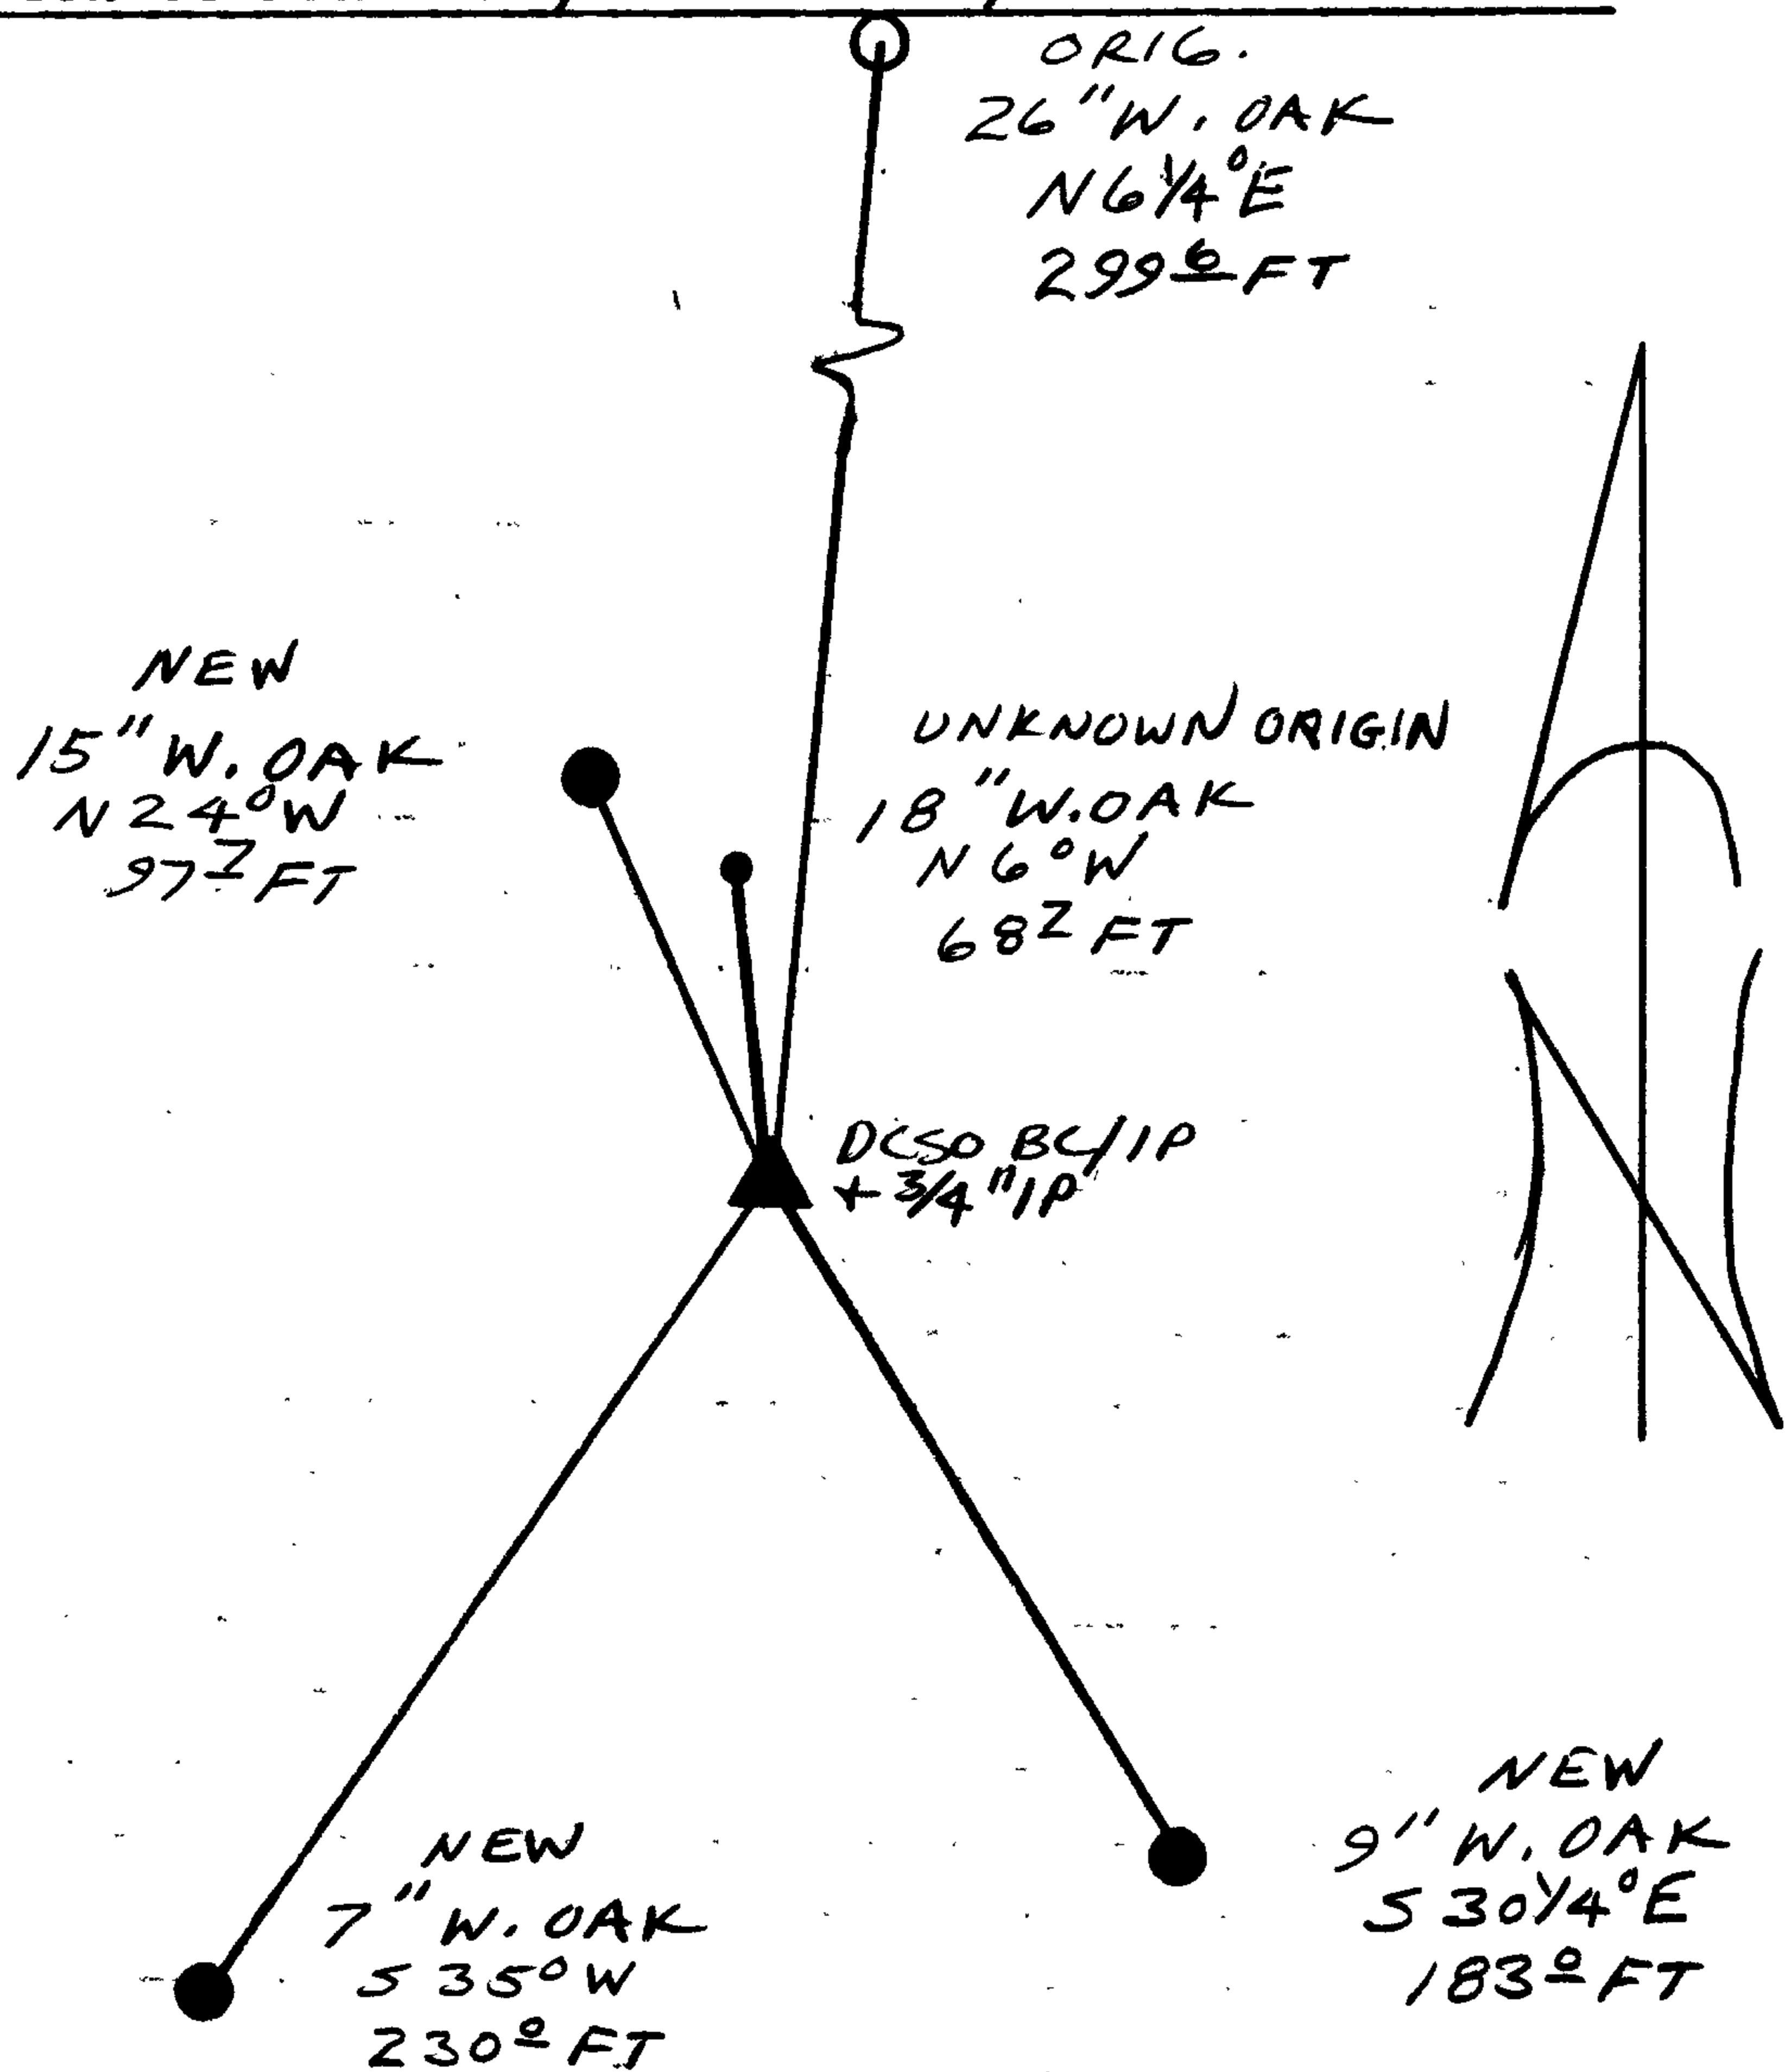

Location & Comments

CORNER LIES APPROX 250 FT
EASTERLY OF A GRAVEL ROAD
ON AN OPEN HILLY PASTURE.

Comp. Declin. 18° E
Agency DCSO
Party Chief RANDALL W SMITH
Notekeeper Randall W Smith
Witnesses STEPHEN J FLAUSE

Address

Surveyor's Seal

REGISTERED
PROFESSIONAL
LAND SURVEYOR

Larry E. Monrean

OREGON
JULY 13, 1979
LARRY E. MONREAN
#1830