



RENEWAL

Monument Set (Procedure and Description)

NONE


Monument Detail

N/A

New Accessories

- 5" MADRONE BARK SCRIBED "CN 1/16 S15 CS BT"
- BEARS N 9 1/2° E, 6.7 FT
- 5" PINE DOUBLE BLAZED "CN 1/16 S15 CS BT"
- BEARS S 3° E, 8.4 FT
- 5" D. FIR DOUBLE BLAZED "CN 1/16 S15 CS BT"
- BEARS S 88° W, 26.6 FT

Sketch of Monument, Accessories, and General Area

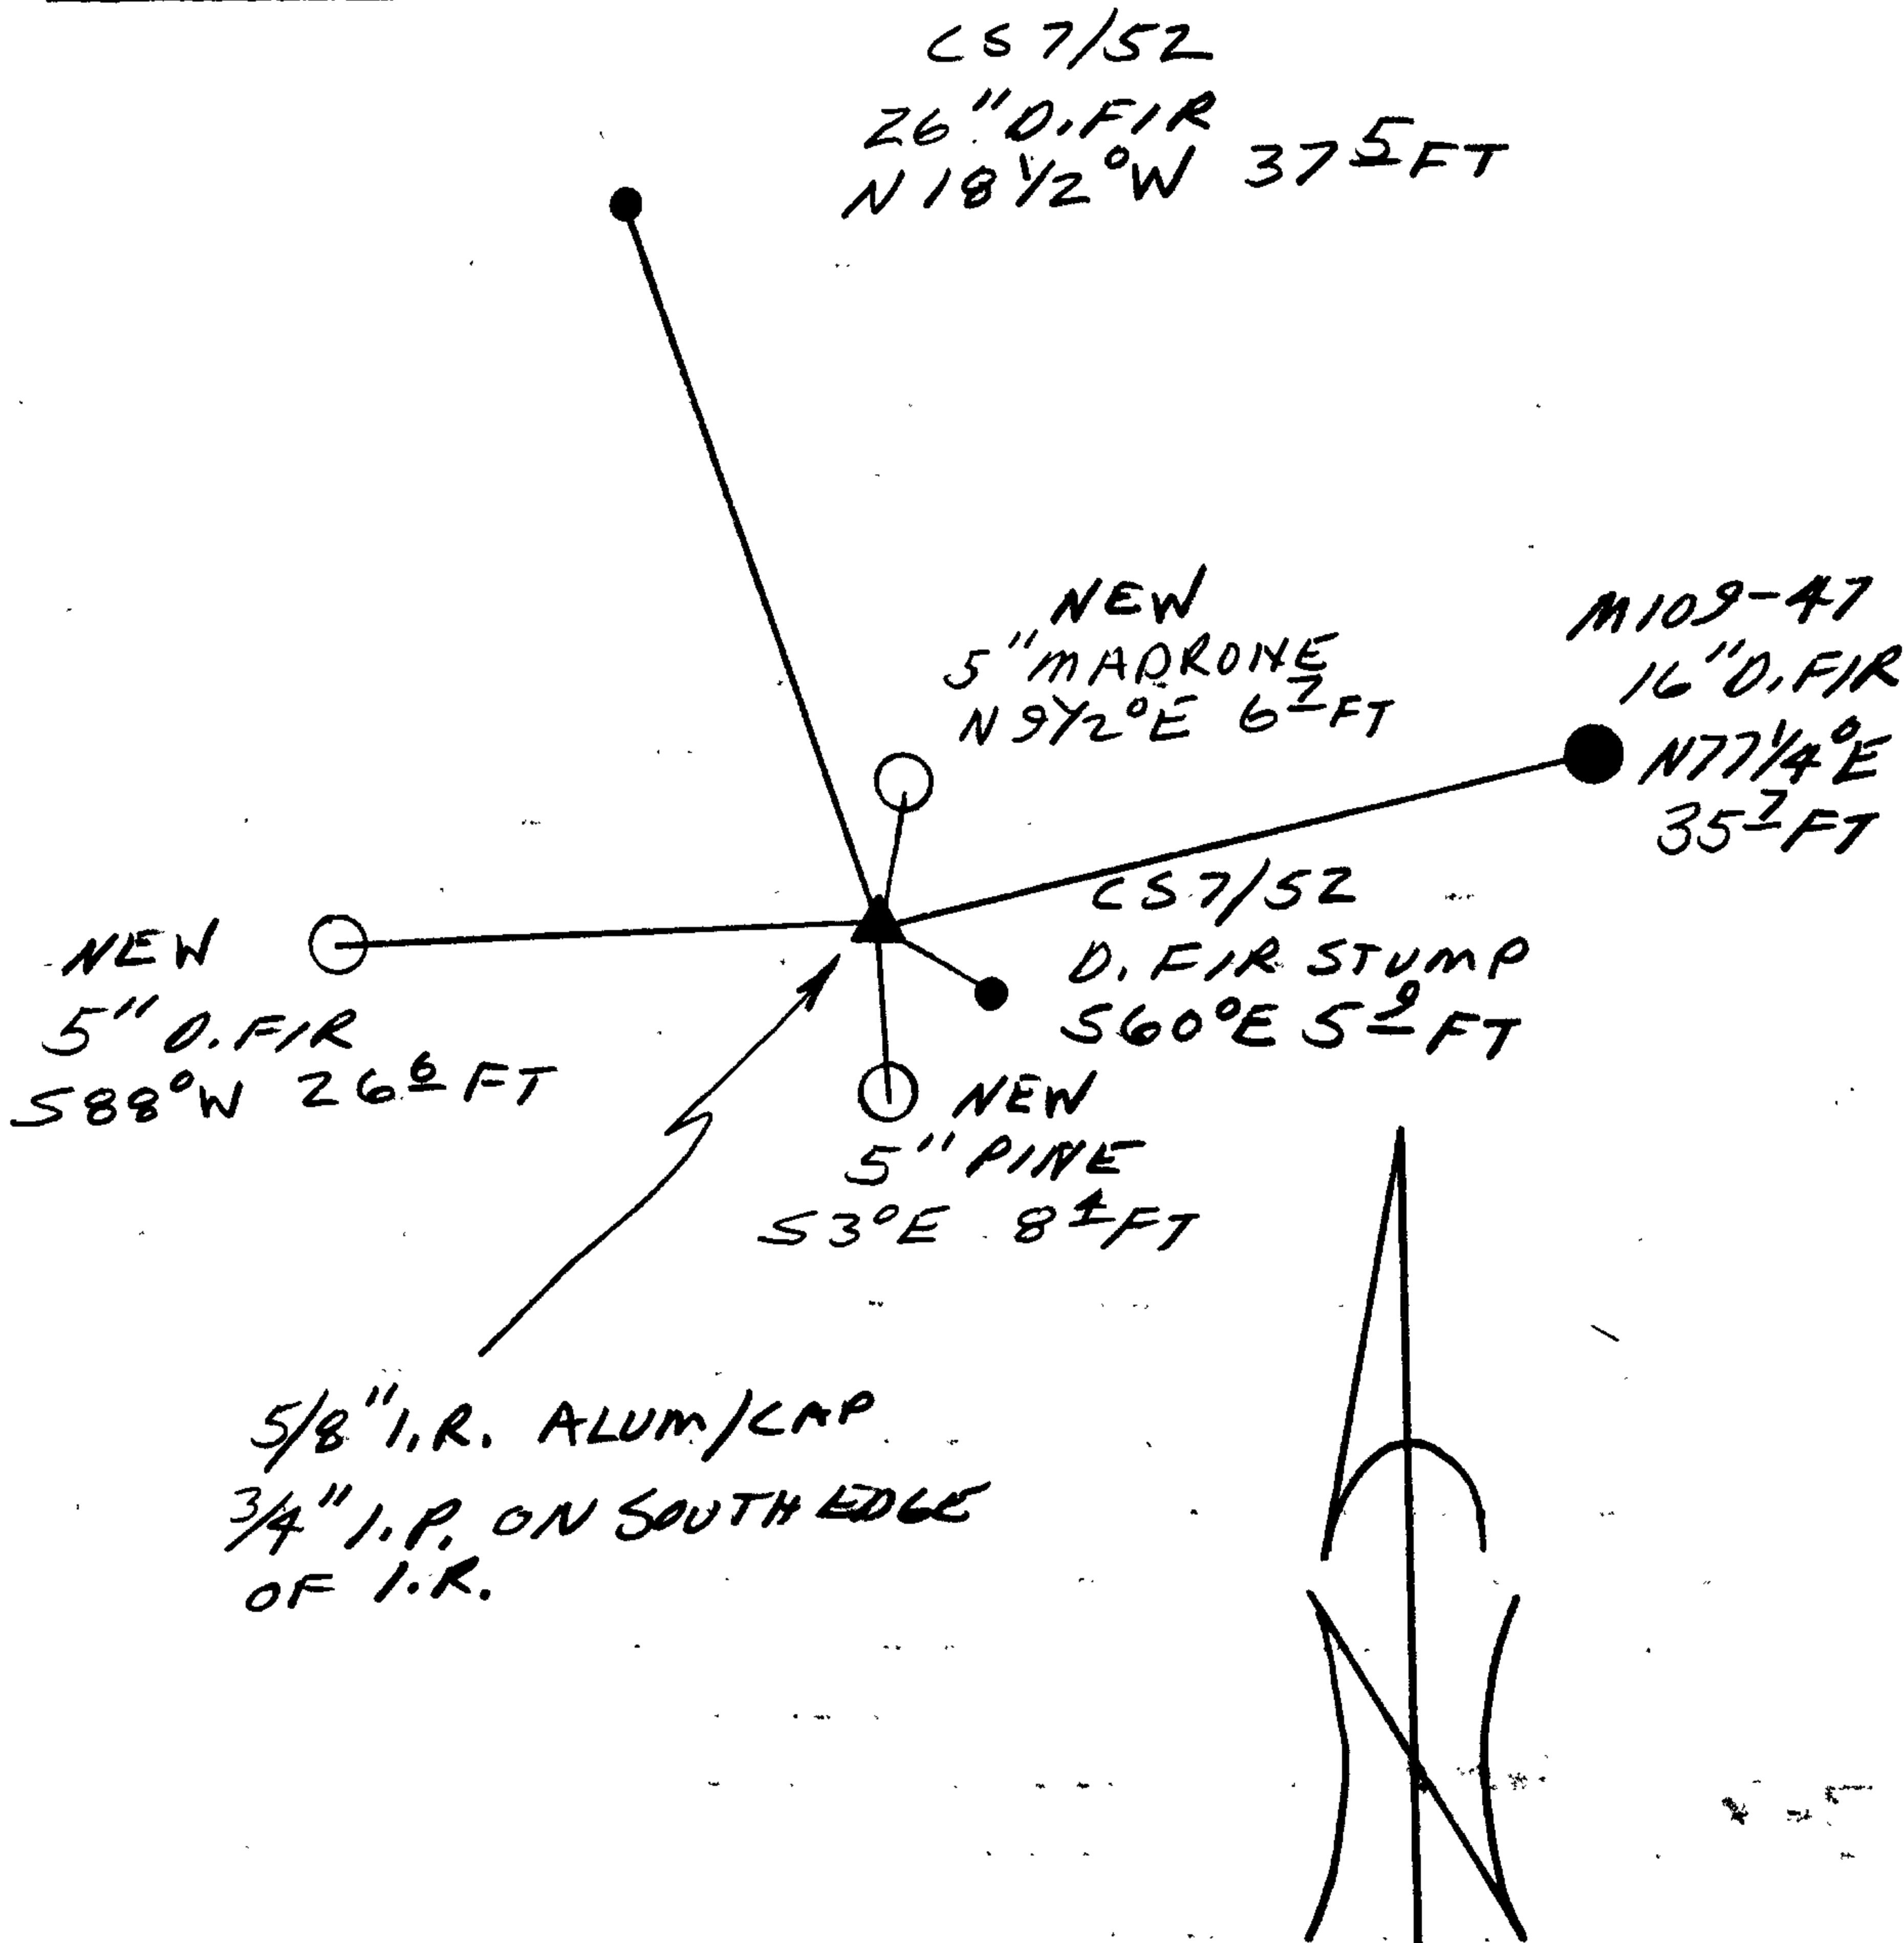

Location & Comments

Comp. Declin. 18° E  
 Agency DCSO  
 Party Chief RANDALL W. SMITH  
 Notekeeper *Randall W. Smith*  
 Witnesses STEPHEN J. FLAISE

Address

Surveyor's Seal

REGISTERED  
PROFESSIONAL  
LAND SURVEYOR

*Larry E. Monrean*

OREGON  
JULY 13, 1979  
LARRY E. MONREAN  
#1830