



RENEWAL

Monument Set (Procedure and Description)

Monument Detail

NONE

N/A


New Accessories

2 1/2" DIA. APPLE BARK SCRIBED "T265 R6W S13 CS BT"  
BEARS S 1 3/4° E, 138.2 FT

1 1/2" DIA. ASH DOUBLE BLAZED AND SCRIBED "T265 R6W S11 CS BT"  
BEARS N 1 3/4° W, 97.0 FT

Sketch of Monument, Accessories, and General Area

Location & Comments

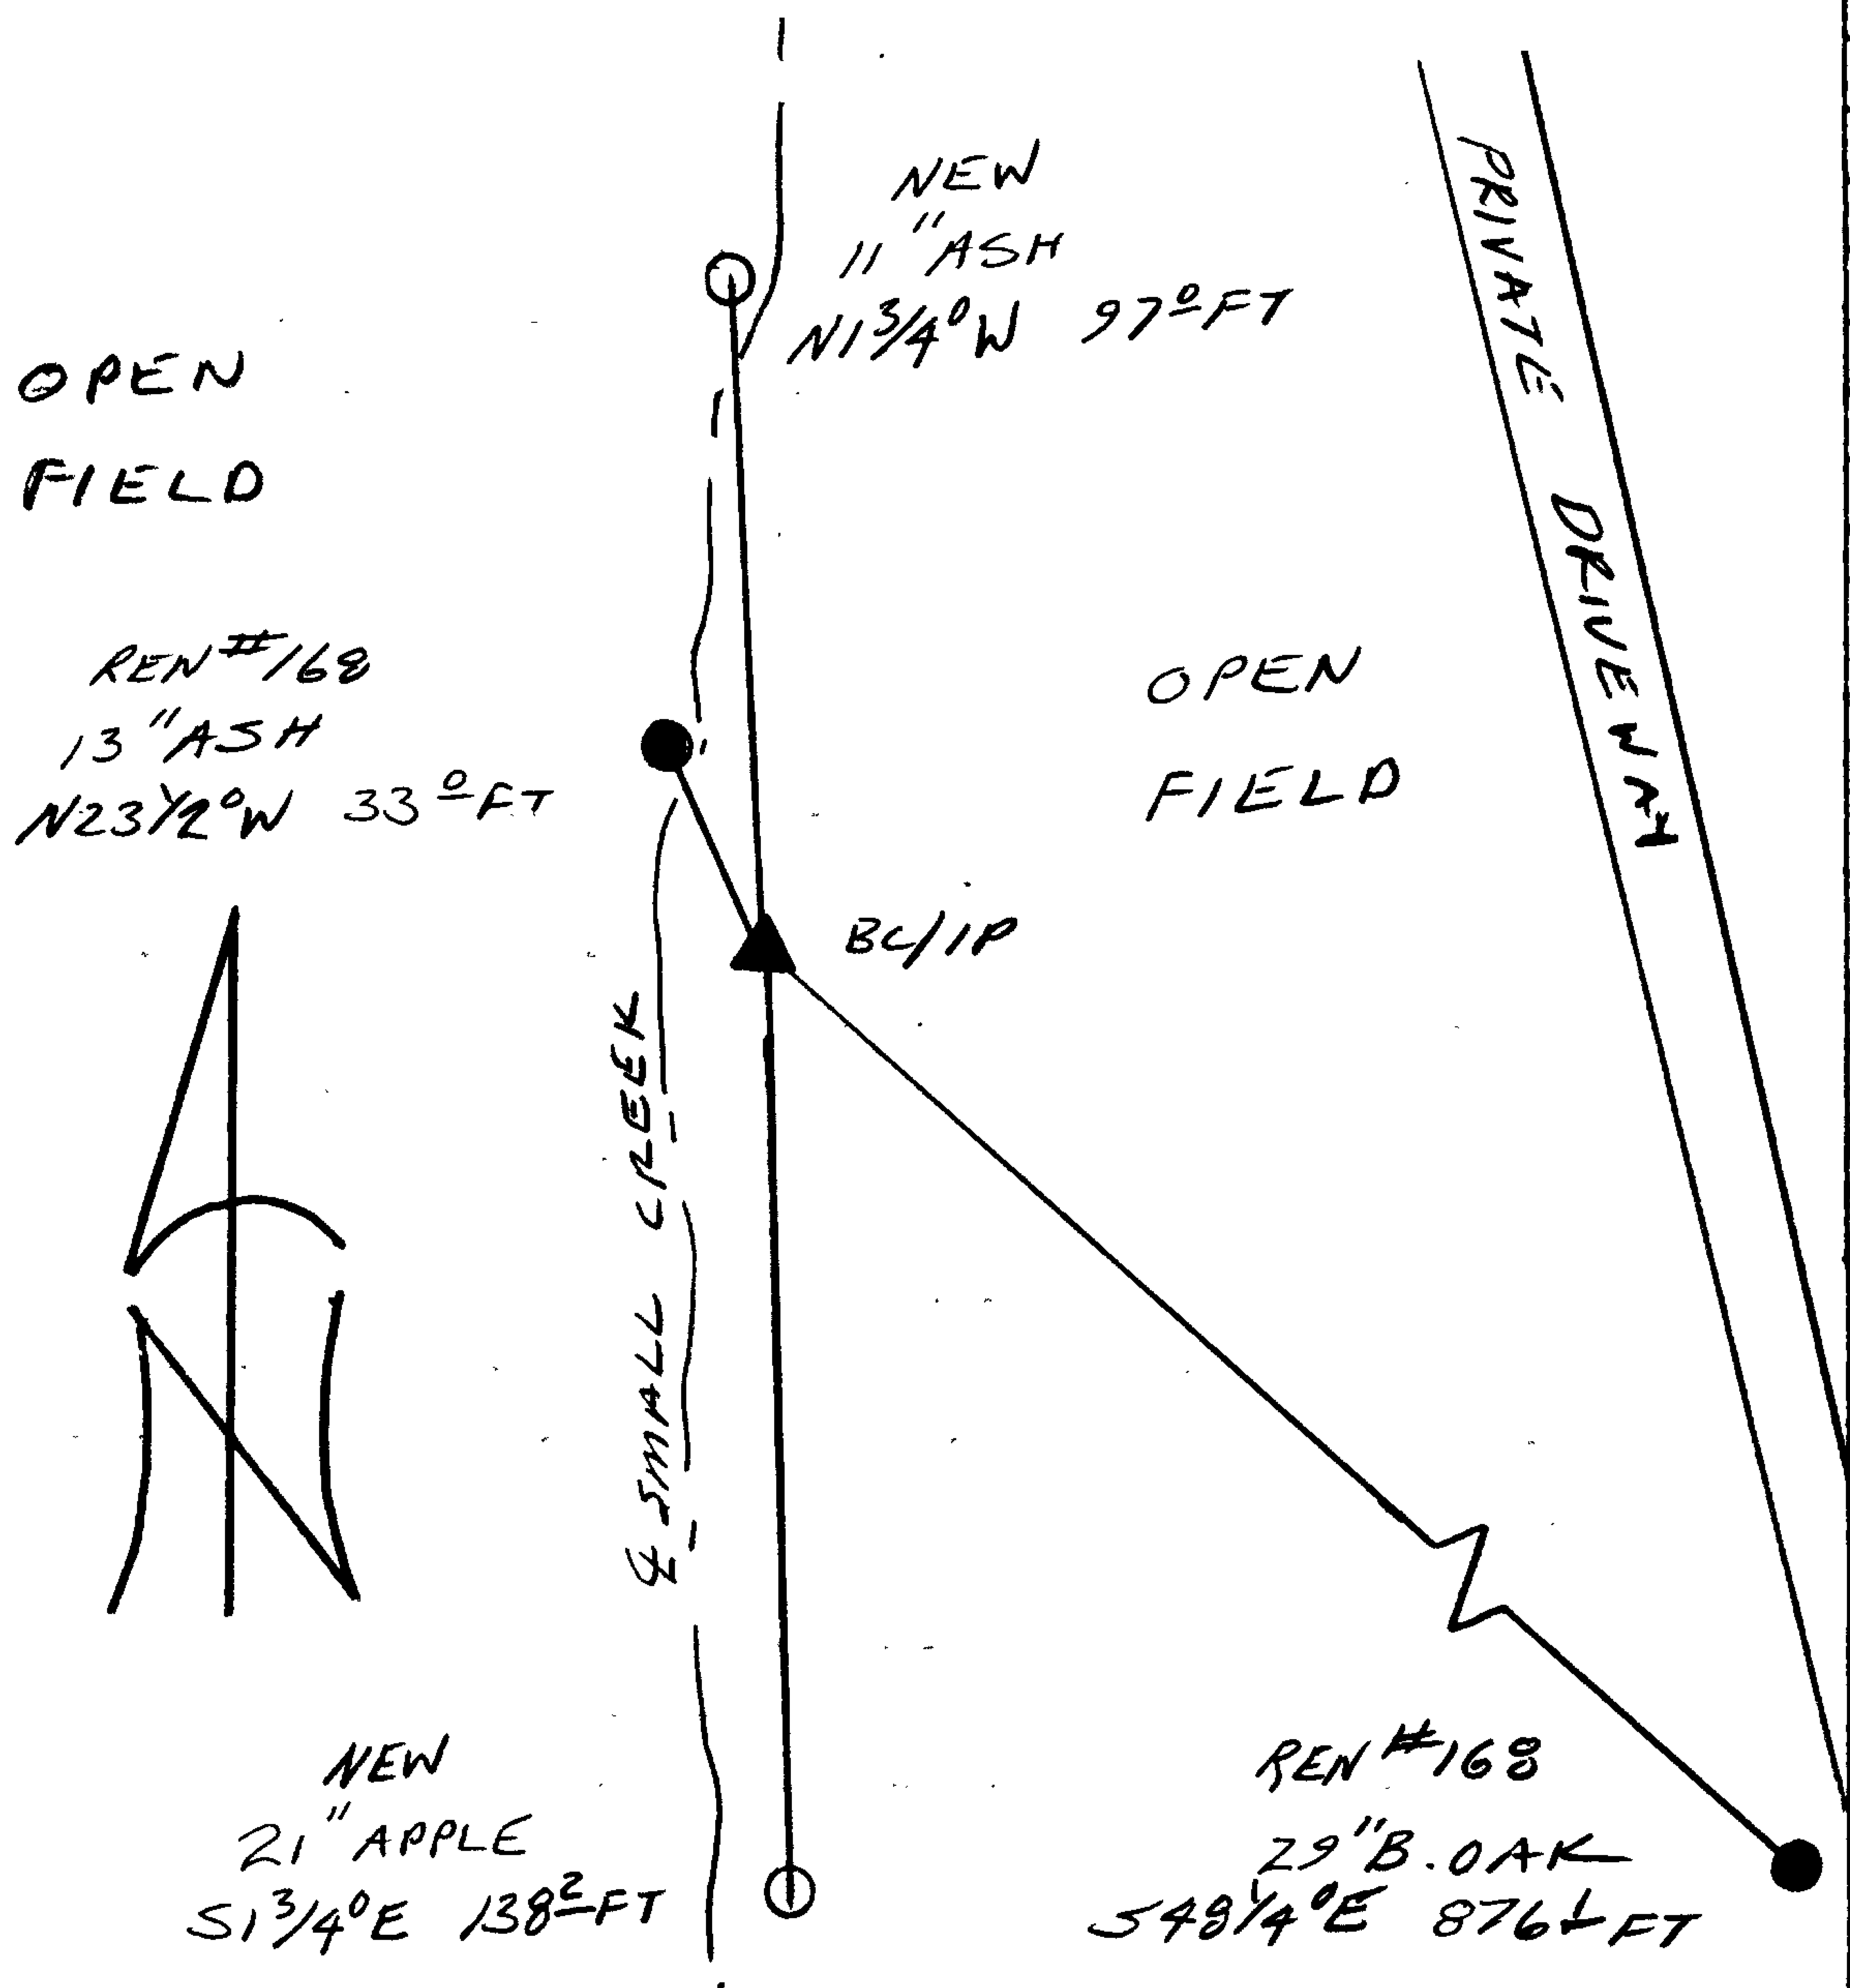

\_\_\_\_\_  
 \_\_\_\_\_  
Comp. Declin. 18° E  
 Agency DCSO  
 Party Chief RANDALL W SMITH  
 Notekeeper Randall W Smith  
 Witnesses STEPHEN J FLAKE

Address \_\_\_\_\_  
 \_\_\_\_\_

Surveyor's Seal  
 REGISTERED  
 PROFESSIONAL  
 LAND SURVEYOR

*Larry E. Monrean*

OREGON  
 JULY 13, 1979  
 LARRY E. MONREAN  
 #1830