

GOVERNMENT CORNER RESTORATION FORM

FILED

Township 25S Range 4W Sec. 30 County DOUGLAS

JUN 15 1990

State OR Date 6/7/9 No. _____

Corner Designation

COUNTY SURVEYOR
DOUGLAS COUNTY, ORE.

S25 | S30
S36 | S31

- Condition Report Only
- Not Found
- Renewed
- Unrecorded
- Surveyed In
- Referenced Out

Previous Renewals 1957 BLM, M33-71

Monument(s) Found: (Condition and Source)

A 3 3/4" DIA. BLM BRASS CAP ON A 2 1/2" O.D. IRON PIPE PROTRUDING 2 IN ABOVE GROUND.

U.S. CADASTRAL SURVEY

T 25S

R5W R4W

S25 | S30

S36 | S31

1957

BUREAU OF LAND MANAGEMENT

Accessories Found:

24" NOW 45" DIA. D. FIR, WITH SCRIBE MARKS "S25" VISIBLE ON A PREVIOUSLY OPENED BLAZE, BEARS N75°W, 37.2 FT (REC. N75°W, 39.6 FT) ORIG. BT

11" NOW 31" DIA. 40 FT HIGH D. FIR SNAG FULLY HEALED SINGLE BLAZE, BEARS N63°E, 22.8 FT (REC. N63°E, 21.1 FT) ORIG. BT

14" NOW 35" DIA. 4 FT HIGH D. FIR STUMP WITH A PREVIOUSLY OPENED BLAZE, NO SCRIBE MARKS VISIBLE, BEARS S40°E, 23.1 (REC. S40°E, 22.4 FT) ORIG. BT

12" NOW 23" DIA. 2 FT HIGH D. FIR STUMP NO BLAZE VISIBLE BEARS S2°W, 27.9 FT (REC. S7°W, 28.4 FT) STUMP WAS TAGGED ORIG. BT?

20" NOW 26" DIA. D. FIR A YOUNG D. FIR IS GROWING UP ALONG NW EDGE OF BT WILL LOOK LIKE DOUBLE TRUNKED TREE IN FUTURE, BEARS N36 1/2°E, 84.3 FT TO CENTER OF BLAZED SE TRUNK. (REC. N36 1/2°E, 87.1 FT) 1957 BLM

10" NOW 15" DIA. I CEDAR WITH A FULLY HEALED SINGLE BLAZE, BEARS N42 1/2°W, 46.0 FT. (REC N42 1/2°W, 46.2 FT) 1957 BLM

6" NOW 18" DIA. I CEDAR WITH A FULLY HEALED DOUBLE BLAZE, BEARS S65 1/2°W, 42.2 FT (REC. S65 1/2°W, 42.9 FT) 1957 BLM

23" NOW 24" DIA. 2 FT HIGH DOUBLE TRUNKED D. FIR STUMP BEARS S25 1/2°E, 143.9 FT TO CENTER OF HEALED SINGLE BLAZED NORTH TRUNK (AGREES WITH REC) 1957 BLM

#146 T25-4
#150 T25-5

G.S. FILE NO. 67/9-10

RENEWAL

Monument Set (Procedure and Description)

NONE


Monument Detail

N/A

New Accessories

NONE

Sketch of Monument, Accessories, and General Area

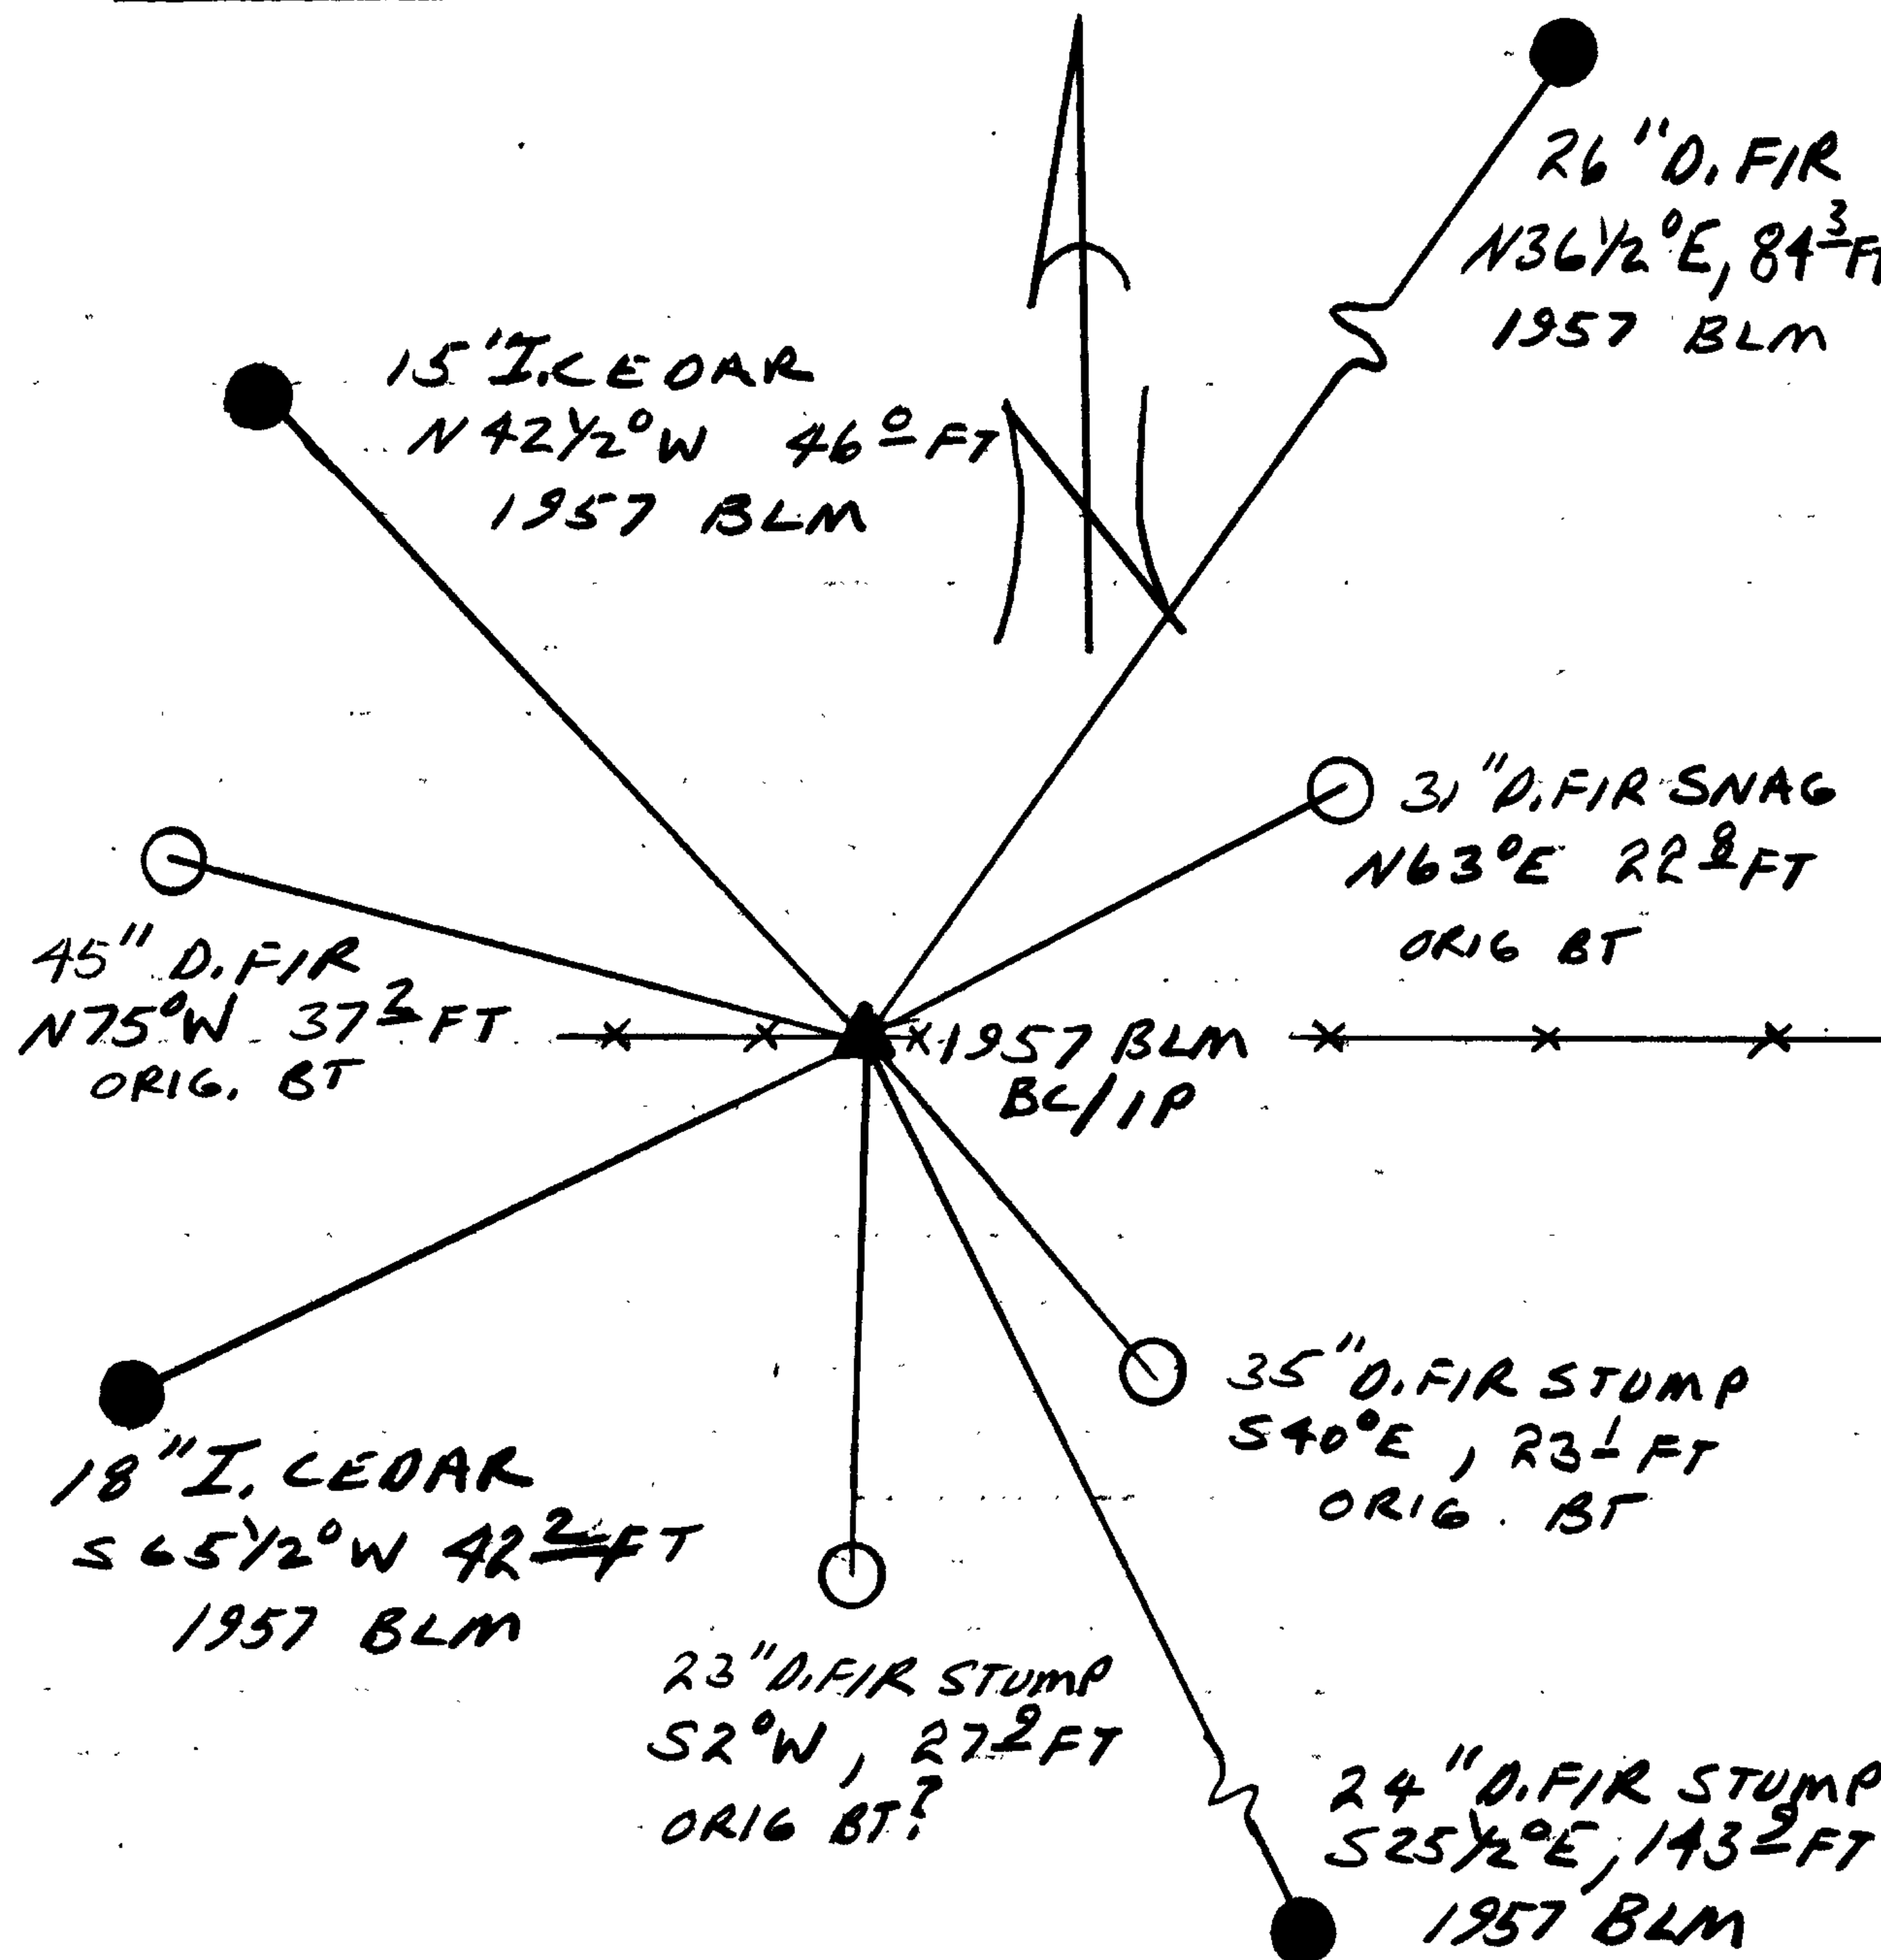

Location & Comments

CORNER LIES IN A EAST-WEST FENCE LINE ON A SOUTH SLOPE.

Comp. Declin. 18° E
 Agency DCSO
 Party Chief RANDALL W SMITH
 Notekeeper Randall W Smith
 Witnesses STEPHEN J FLAUSÉ

Address

Surveyor's Seal

REGISTERED
 PROFESSIONAL
 LAND SURVEYOR

Larry E. Monrean

OREGON
 JULY 13, 1979
 LARRY E. MONREAN
 #1830