

GOVERNMENT CORNER RESTORATION FORM

FILED

Township 26S Range 6W Sec. 17 County DOUGLAS

JUL 9 1990

State OR Date 6/25/90 No. \_\_\_\_\_

Corner Designation \_\_\_\_\_

COUNTY SURVEYOR  
DOUGLAS COUNTY, ORE

$\frac{1}{4} \frac{S17}{S20}$

- \_\_\_\_\_ Condition Report Only
- \_\_\_\_\_ Not Found
- Renewed
- \_\_\_\_\_ Unrecorded
- \_\_\_\_\_ Surveyed In
- \_\_\_\_\_ Referenced Out

Previous Renewals #9 #92

Monument(s) Found: (Condition and Source)

A 2 1/2" DIA. DCSO BRASS CAP ON A  
1 1/4" O.D. BY 36" LONG IRON PIPE  
IS FOUND OUT OF GROUND.

COUNTY SURVEYORS OFFICE  
T26S R6W

$\frac{1}{4} \frac{S17}{S20}$   
1961

Accessories Found:

13" NOW 24" DIA. 8 FT HIGH B. OAK SNAG WITH A  
PARTIALLY HEALED BLAZE, BEARS S57°E, 9.9 FT  
(AGREE'S WITH RECORD) ORIG. BT

ORIG. NE BT IS GONE

14" NOW 13" DIA. MADRONE WITH A PARTIALLY HEALED DOUBLE  
BLAZE, ILLEGIBLE SCRIBE MARKS VISIBLE, BEARS S24°W,  
20.6 FT (REC. S24°W, 21.0 FT DISTANCE FITS CENTER AT  
BLAZE HEIGHT). REN#92

15" NOW 17" DIA. MADRONE WITH A PARTIALLY HEALED DOUBLE  
BLAZE, ILLEGIBLE SCRIBE MARKS VISIBLE, BEARS N55°W,  
18.7 FT (AGREE'S WITH REC.) REN#92

#1994

C.S. File No. 64/9-12

RENEWAL

Monument Set (Procedure and Description)

DCSO BC/IP IS RESET AT A POINT ESTABLISHED FROM BEARING TREE'S. THE STAMPING "RESET 1990 IS ADDED TO BRASS CAP. BC/IP NOW PROTRUDES 9 IN ABOVE GROUND.

Monument Detail

COUNTY SURVEYORS OFFICE T26S R6W


1/4 S 17 S 20 RESET 1990 1961

New Accessories

12" DIA. MADRONE DOUBLE BLAZED AND SCRIBED "1/4 S20 CS BT" BEARS S23°E, 2.3 FT.

5" DIA. D. FIR DOUBLE BLAZED AND SCRIBED "1/4 S17 CS BT" BEARS N82Y2°W, 35.2 FT.

Sketch of Monument, Accessories, and General Area

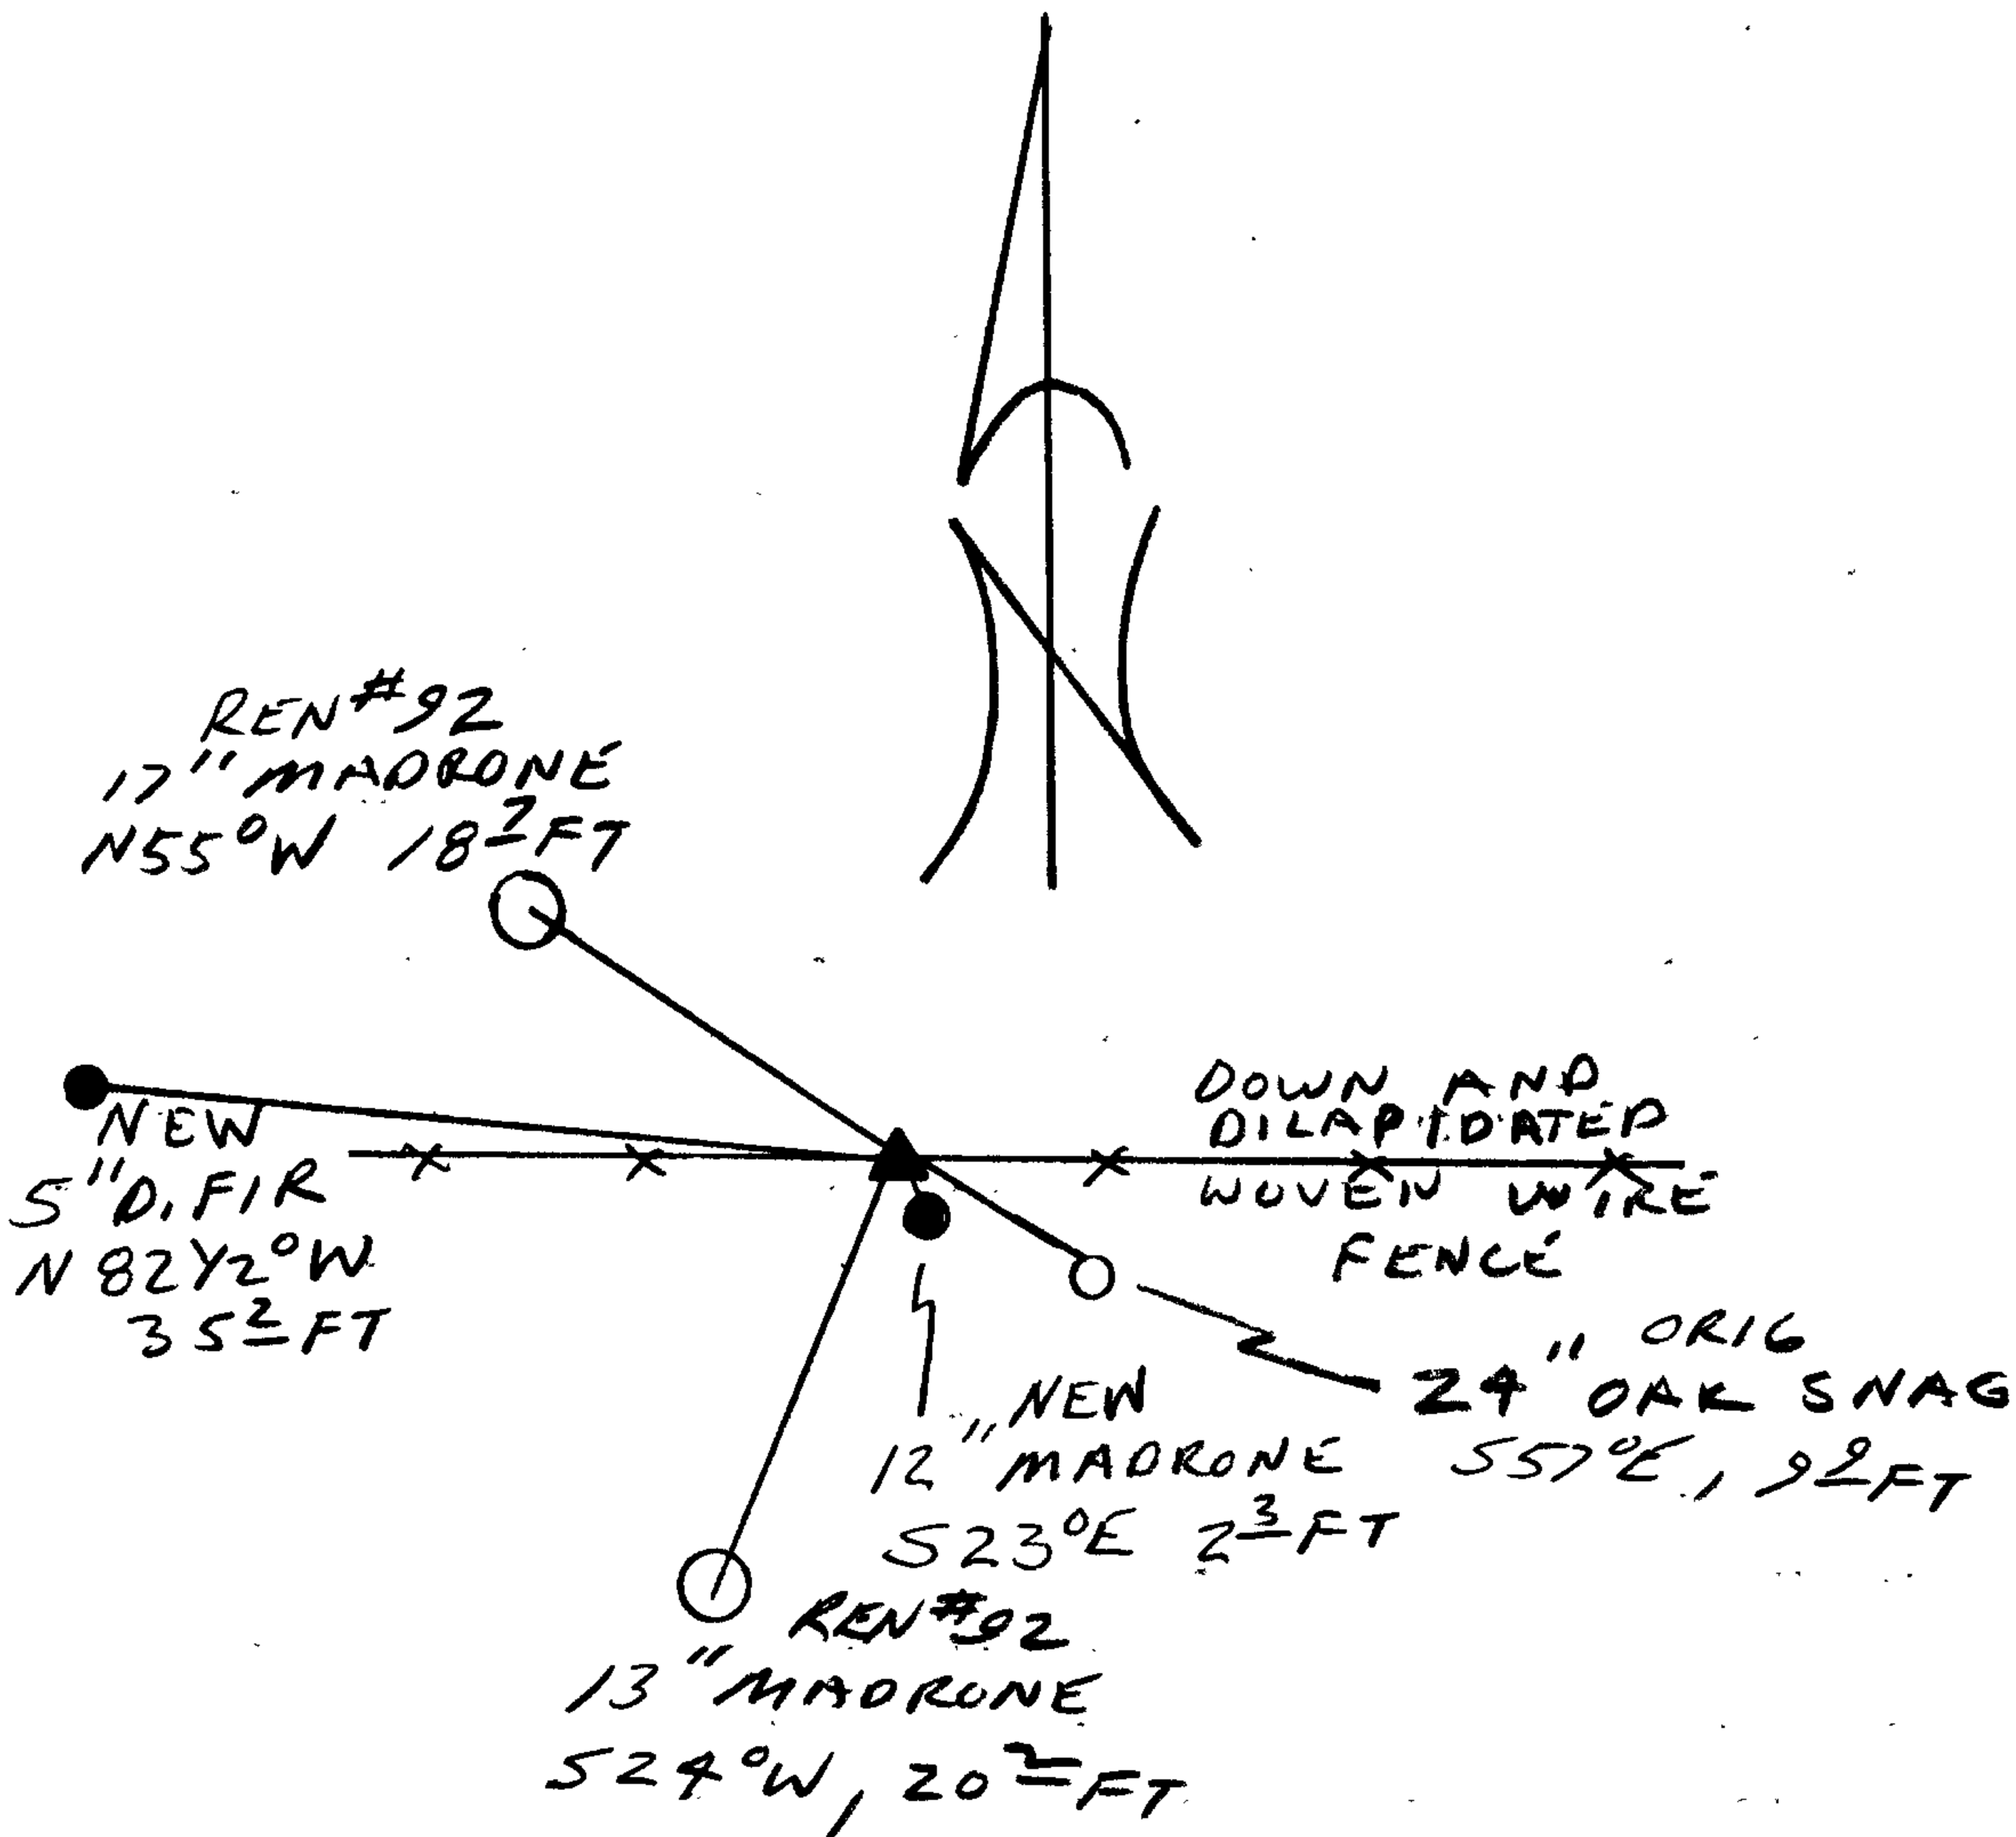

Location & Comments

Comp. Declin. 18°E Agency DCSO Party Chief RANDALL W SMITH Notekeeper Randall W Smith Witnesses STEPHEN J FLAUSE TERRIE FRANSSSEN

Address

Surveyor's Seal

REGISTERED PROFESSIONAL LAND SURVEYOR

Larry E. Monrean

OREGON JULY 13, 1979 LARRY E. MONREAN #1830