

RENEWAL

Monument Set (Procedure and Description)

NONE

Monument Detail

N/A


New Accessories

7" DIA. D.FIR DOUBLE BLAZED AND SCRIBED "CW 1/16 S 25 CS 13T"
BEARS S 42° E, 15.4 FT.

5/8" BY 31" LONG IRON ROD WITH A DCSO ALUM. CAP STAMPED
"B01 1990", IS SET. IT PROTRUDES 5 IN. ABOVE GROUND,
BEARS SOUTH, 100 FT.

Sketch of Monument, Accessories, and General Area

GRAVEL ROAD (24-4-25.0)

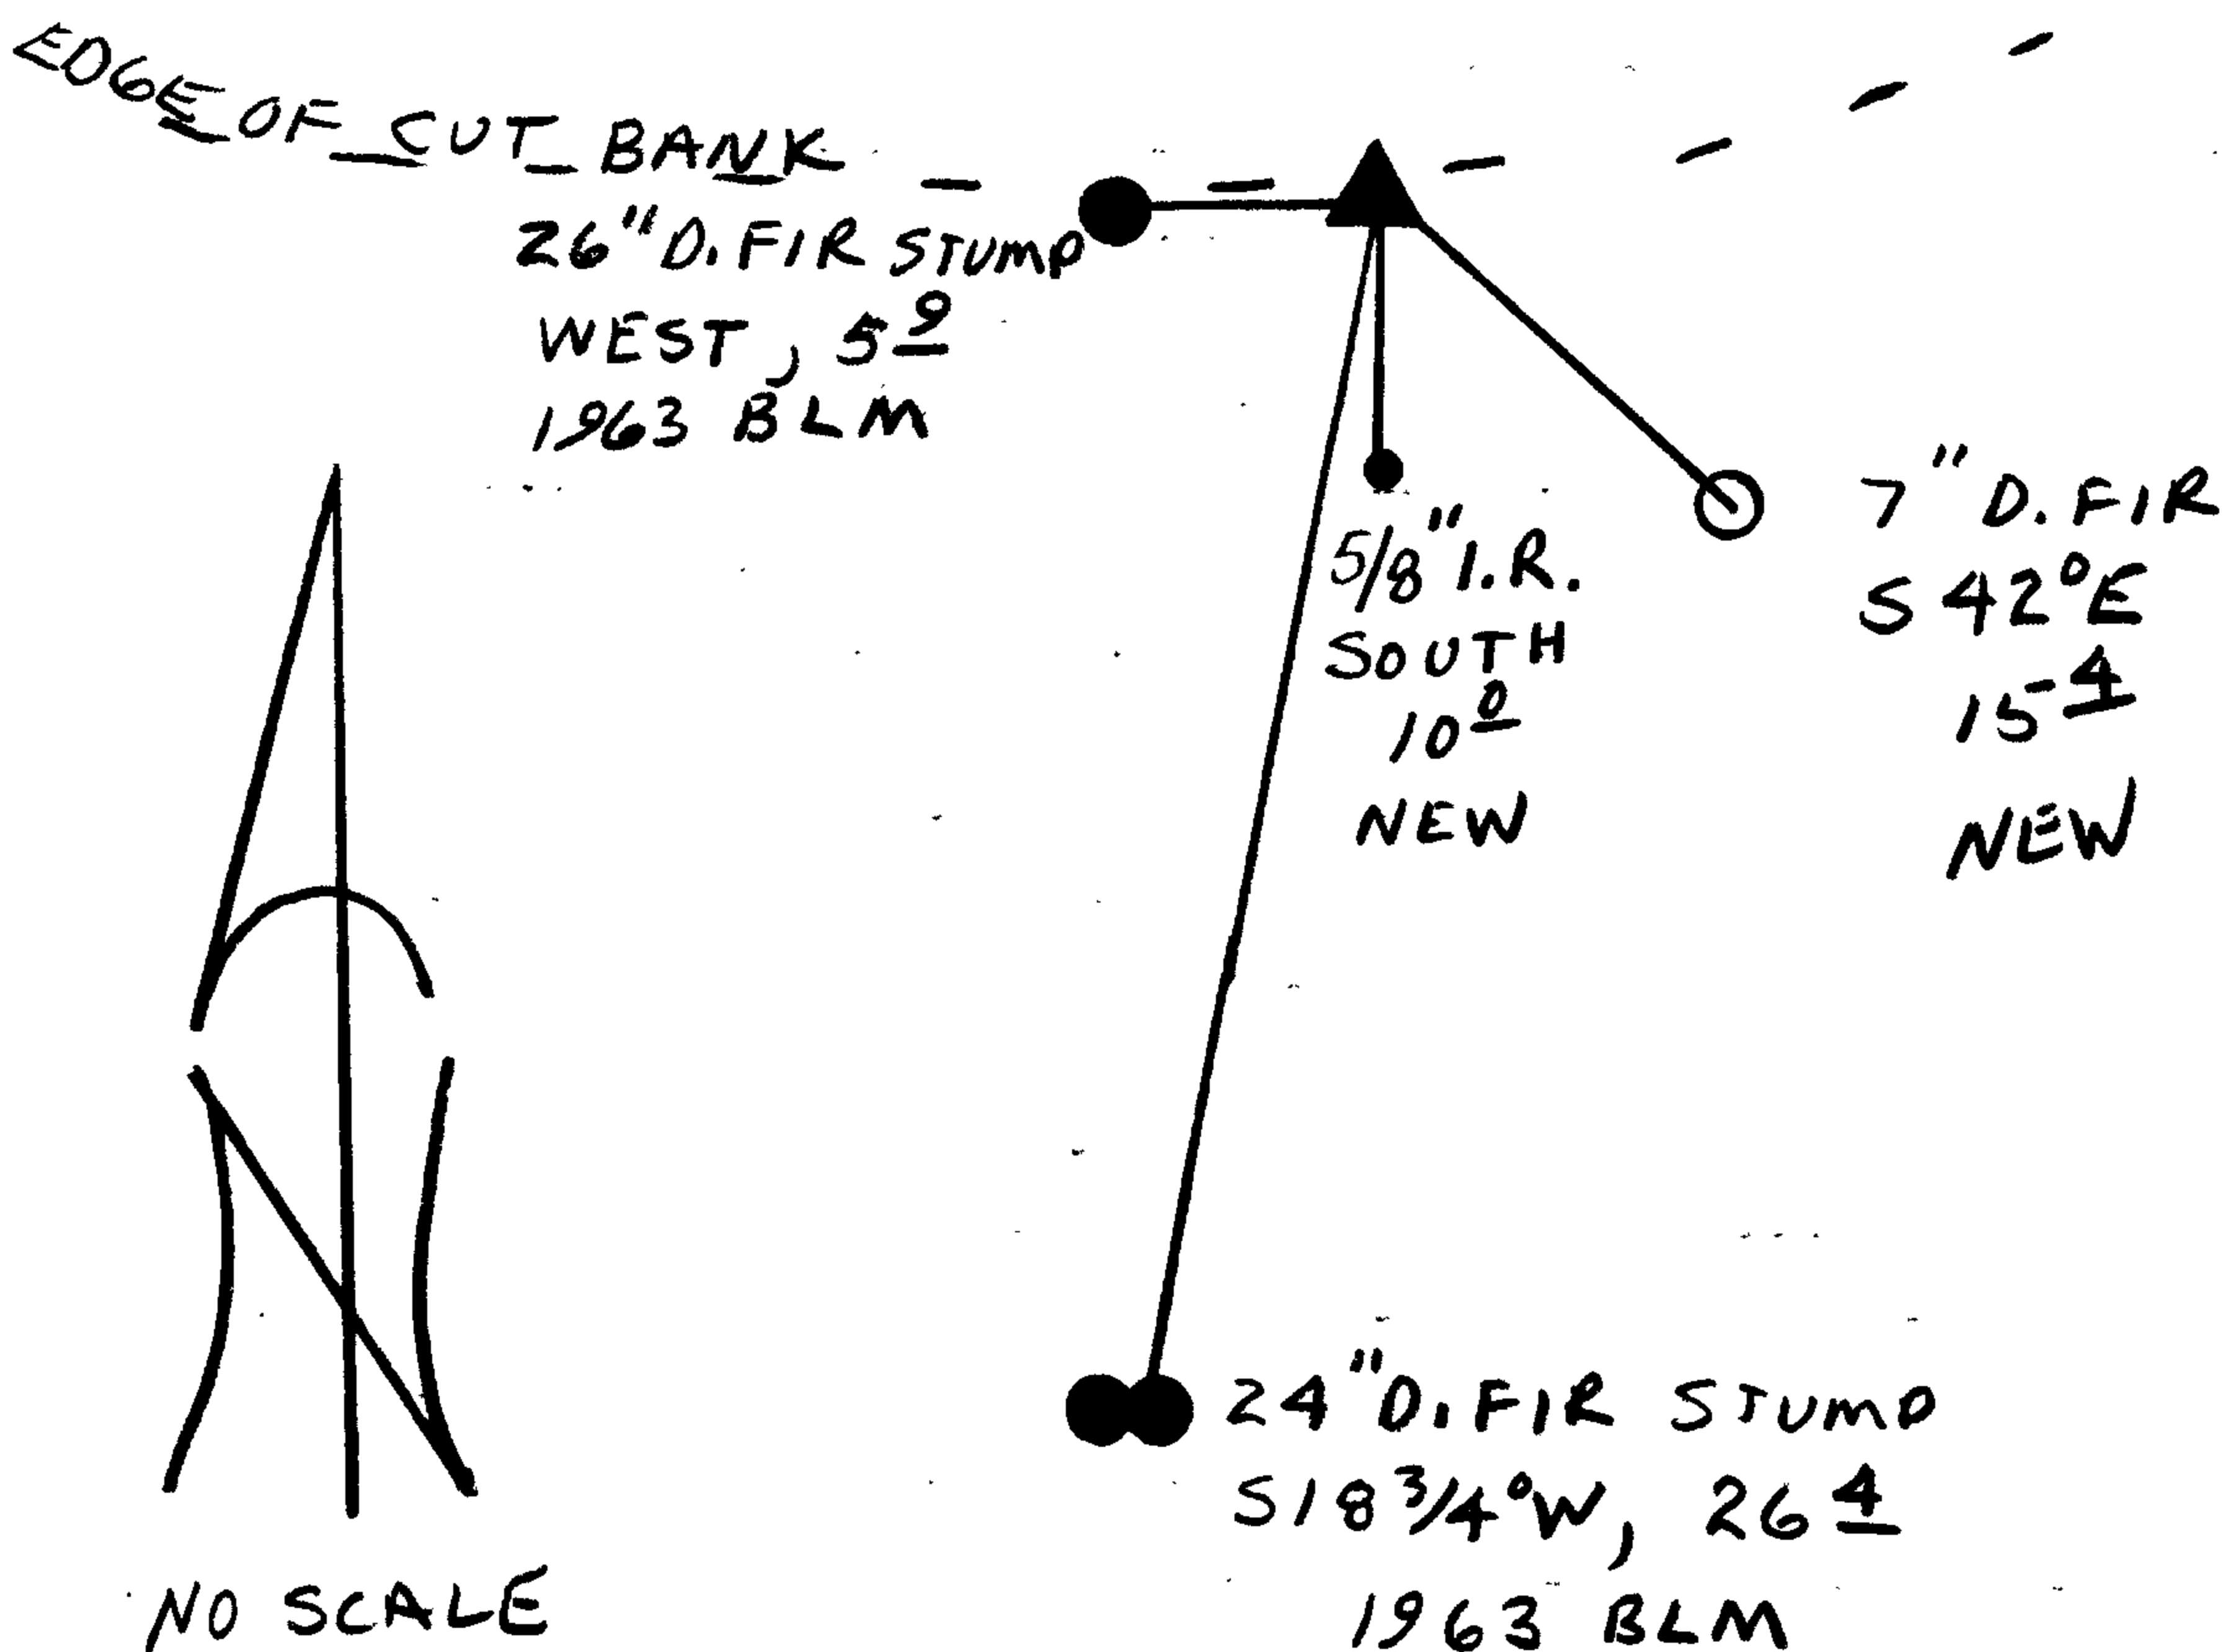

Location & Comments

CORNER LIES AT EDGE ON TOP OF
A STEEP CUT BANK ON
SOUTH SIDE OF ROAD. APPROX
300 FT FROM END OF
ROAD

Comp. Declin. 18° E
Agency DCSO
Party Chief RANDALL W SMITH
Notekeeper Randall W Smith
Witnesses STEPHEN J. FLAUSE

Address

Surveyor's Seal

REGISTERED
PROFESSIONAL
LAND SURVEYOR

Randall W Smith

OREGON
JULY 26, 1990
RANDALL W. SMITH
2469