

GOVERNMENT CORNER RESTORATION FORM

FILED

Township 255 Range 7W Sec. 21 County DOUGLAS

JAN 30 1991

State OREGON Date 1/18/91 No. _____

COUNTY SURVEYOR
DOUGLAS COUNTY, ORE.

Corner Designation

S21 | S22

S28 | S27

- Condition Report Only
- Not Found
- Renewed ¹⁴⁴
- Unrecorded
- Surveyed In
- Referenced Out

Previous Renewals #88, 1968 DEPENDENT RESURV.

MONUMENT DETAIL

Monument(s) Found: (Condition and Source)

A DCSO 2 1/2" DIAM. BRASS CAP (MARKED AS AT RIGHT) ON A 1 3/8" OD. IRON PIPE FIRMLY SET AND PROTRUDING 10 INCHES ABOVE GROUND SURFACE. (REN #88)

COUNTY SURVEYORS OFFICE

T255

S21 | S22

S28 | S27

RTW

1968

Accessories Found:

- EVIDENCE OF FOUR ORIGINAL BEARING TREES: - A FIR, 12 INS DIAM. NOW A 19 INCH D.B.H., 90 FOOT TALL ROTTEN FIR SNAG WITH THE SCRIBE MARKS "T255 RTW S28 CS BT" VISIBLE ON OPEN UPPER AND LOWER BLAZES BEARS S46°W, 15 1/2 FEET DISTANT (AS PER RECORD).
- A FIR, 15 INS. DIAM. NOW A SHATTERED, FALLEN AND ROTTEN FIR STUMP WITH NO VISIBLE SCRIBE MARKS BEARS S20 1/2°E, 21 1/2 FEET DISTANT (RECORD S22°E, 21 1/2 FEET).
 - A FIR, 20 INS. DIAM. NOW A 37 INCH D.B.H. DOUGLAS FIR WITH A HEALED LOWER BLAZE AND THE BARK SCRIBING "T255 RTW S21" VISIBLE ABOVE. BEARS N52°W, 21 1/2 FEET DISTANT (RECORD N52°W, 19 1/2 FT. DIST. APPEARS TO BE A FACE MEASUREMENT)
 - A FIR, 12 INS. DIAM. NOW A 19 INCH D.B.H. DOUGLAS FIR WITH A FULLY HEALED DOUBLE BLAZE BEARS N20°E, 16 1/2 FEET DISTANT (ORIGINAL RECORD N20°E, 23 1/2 FT DIST).
- FROM RENEWAL #88 EVIDENCE OF THE RENEWAL ACCESSORY FOUND
- AN 11" D. FIR NOW AN 11 INCH DBH. 10 FOOT TALL FIR SNAG WITH THE SCRIBING "T255 RTW S27 CS BT" VISIBLE IN A PARTIALLY HEALED SINGLE BLAZE. BEARS S21°W, 24 1/2 FEET DISTANT (AS PER REN #88 RECORD)

Monument Set (Procedure and Description)

Monument Detail



NA

N/A

New BT's Accessories

A 21 INCH D.B.H. CEDAR WITH 2 SQUARE BLAZE SCARS (TREE IS TAGGED BUT OTHERWISE UNRECORDED) BEARS N81 1/2° E, 17 1/2 FEET DISTANT.
A 4 INCH D.B.H. DOUGLAS FIR DOUBLE BLAZED AND SCRIBED "X BT" BEARS S58° E, 19 3 FEET DISTANT.

Sketch of Monument, Accessories, and General Area

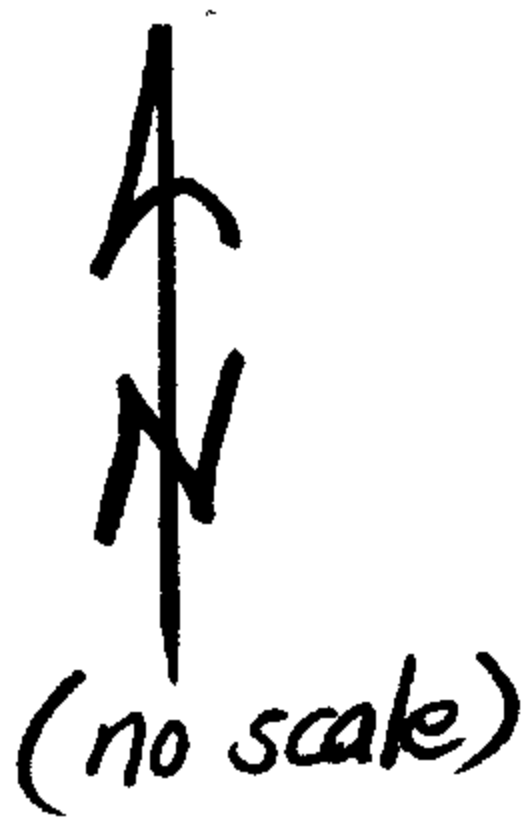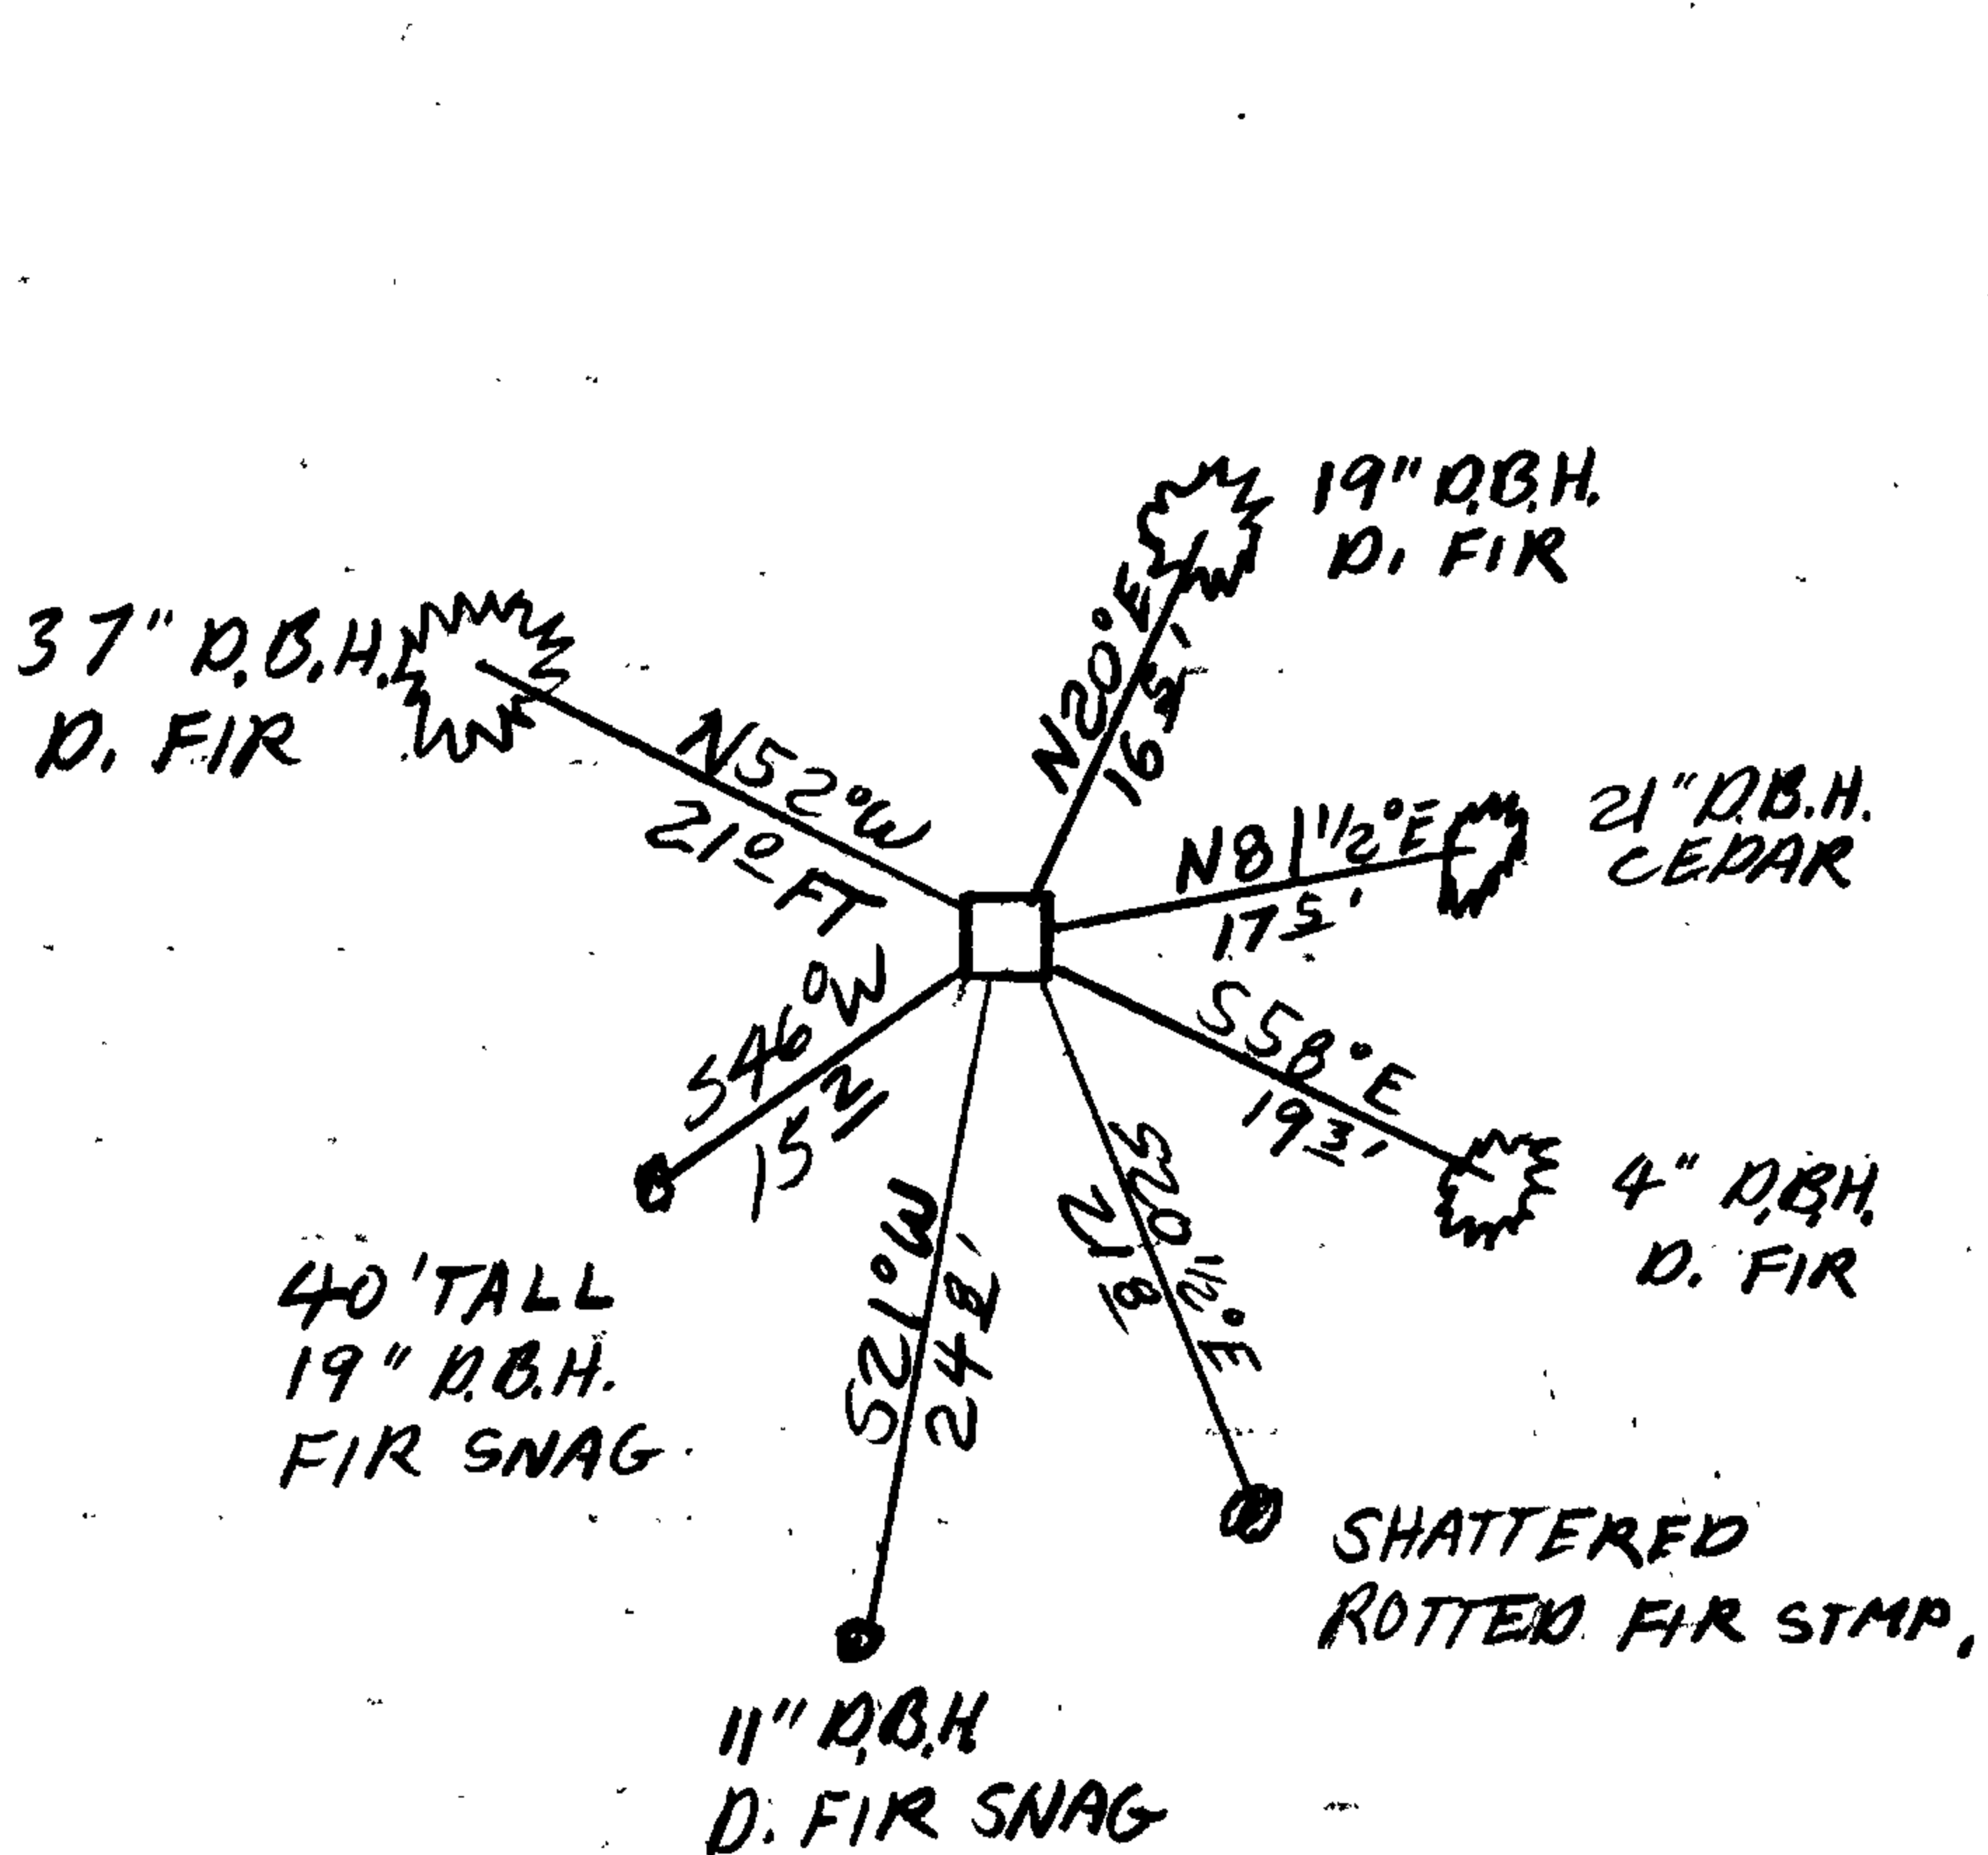

Location & Comments

LOCATED APPROXIMATELY 400' EAST FROM LOGGING ROAD TURN-OUT. CORNER IS IN OLD GROWTH TIMBER JUST EAST OF NORTH SOUTH CUTTING LINE.

Comp. Declin. 10° E
Agency DCSD
Party Chief Stephen John Flause
Notekeeper S.J. FLAUSE
Witnesses T. FRANISSEN

Address

Surveyor's Seal

REGISTERED PROFESSIONAL LAND SURVEYOR

Larry E. Monrean

OREGON JULY 13, 1979 LARRY E. MONREAN #1830