

RENEWAL

Monument Set (Procedure and Description)

NONE

Monument Detail


N/A

New Accessories

5" DIA. OAK DOUBLE BLAZED AND SCRIBED "X BT"
BEARS N23 1/2° E, 10.2 FT

14" DIA. D. FIR DOUBLE BLAZED AND SCRIBED "Y 45 15 CS BT"
BEARS S46° E, 49.1 FT

Sketch of Monument, Accessories, and General Area

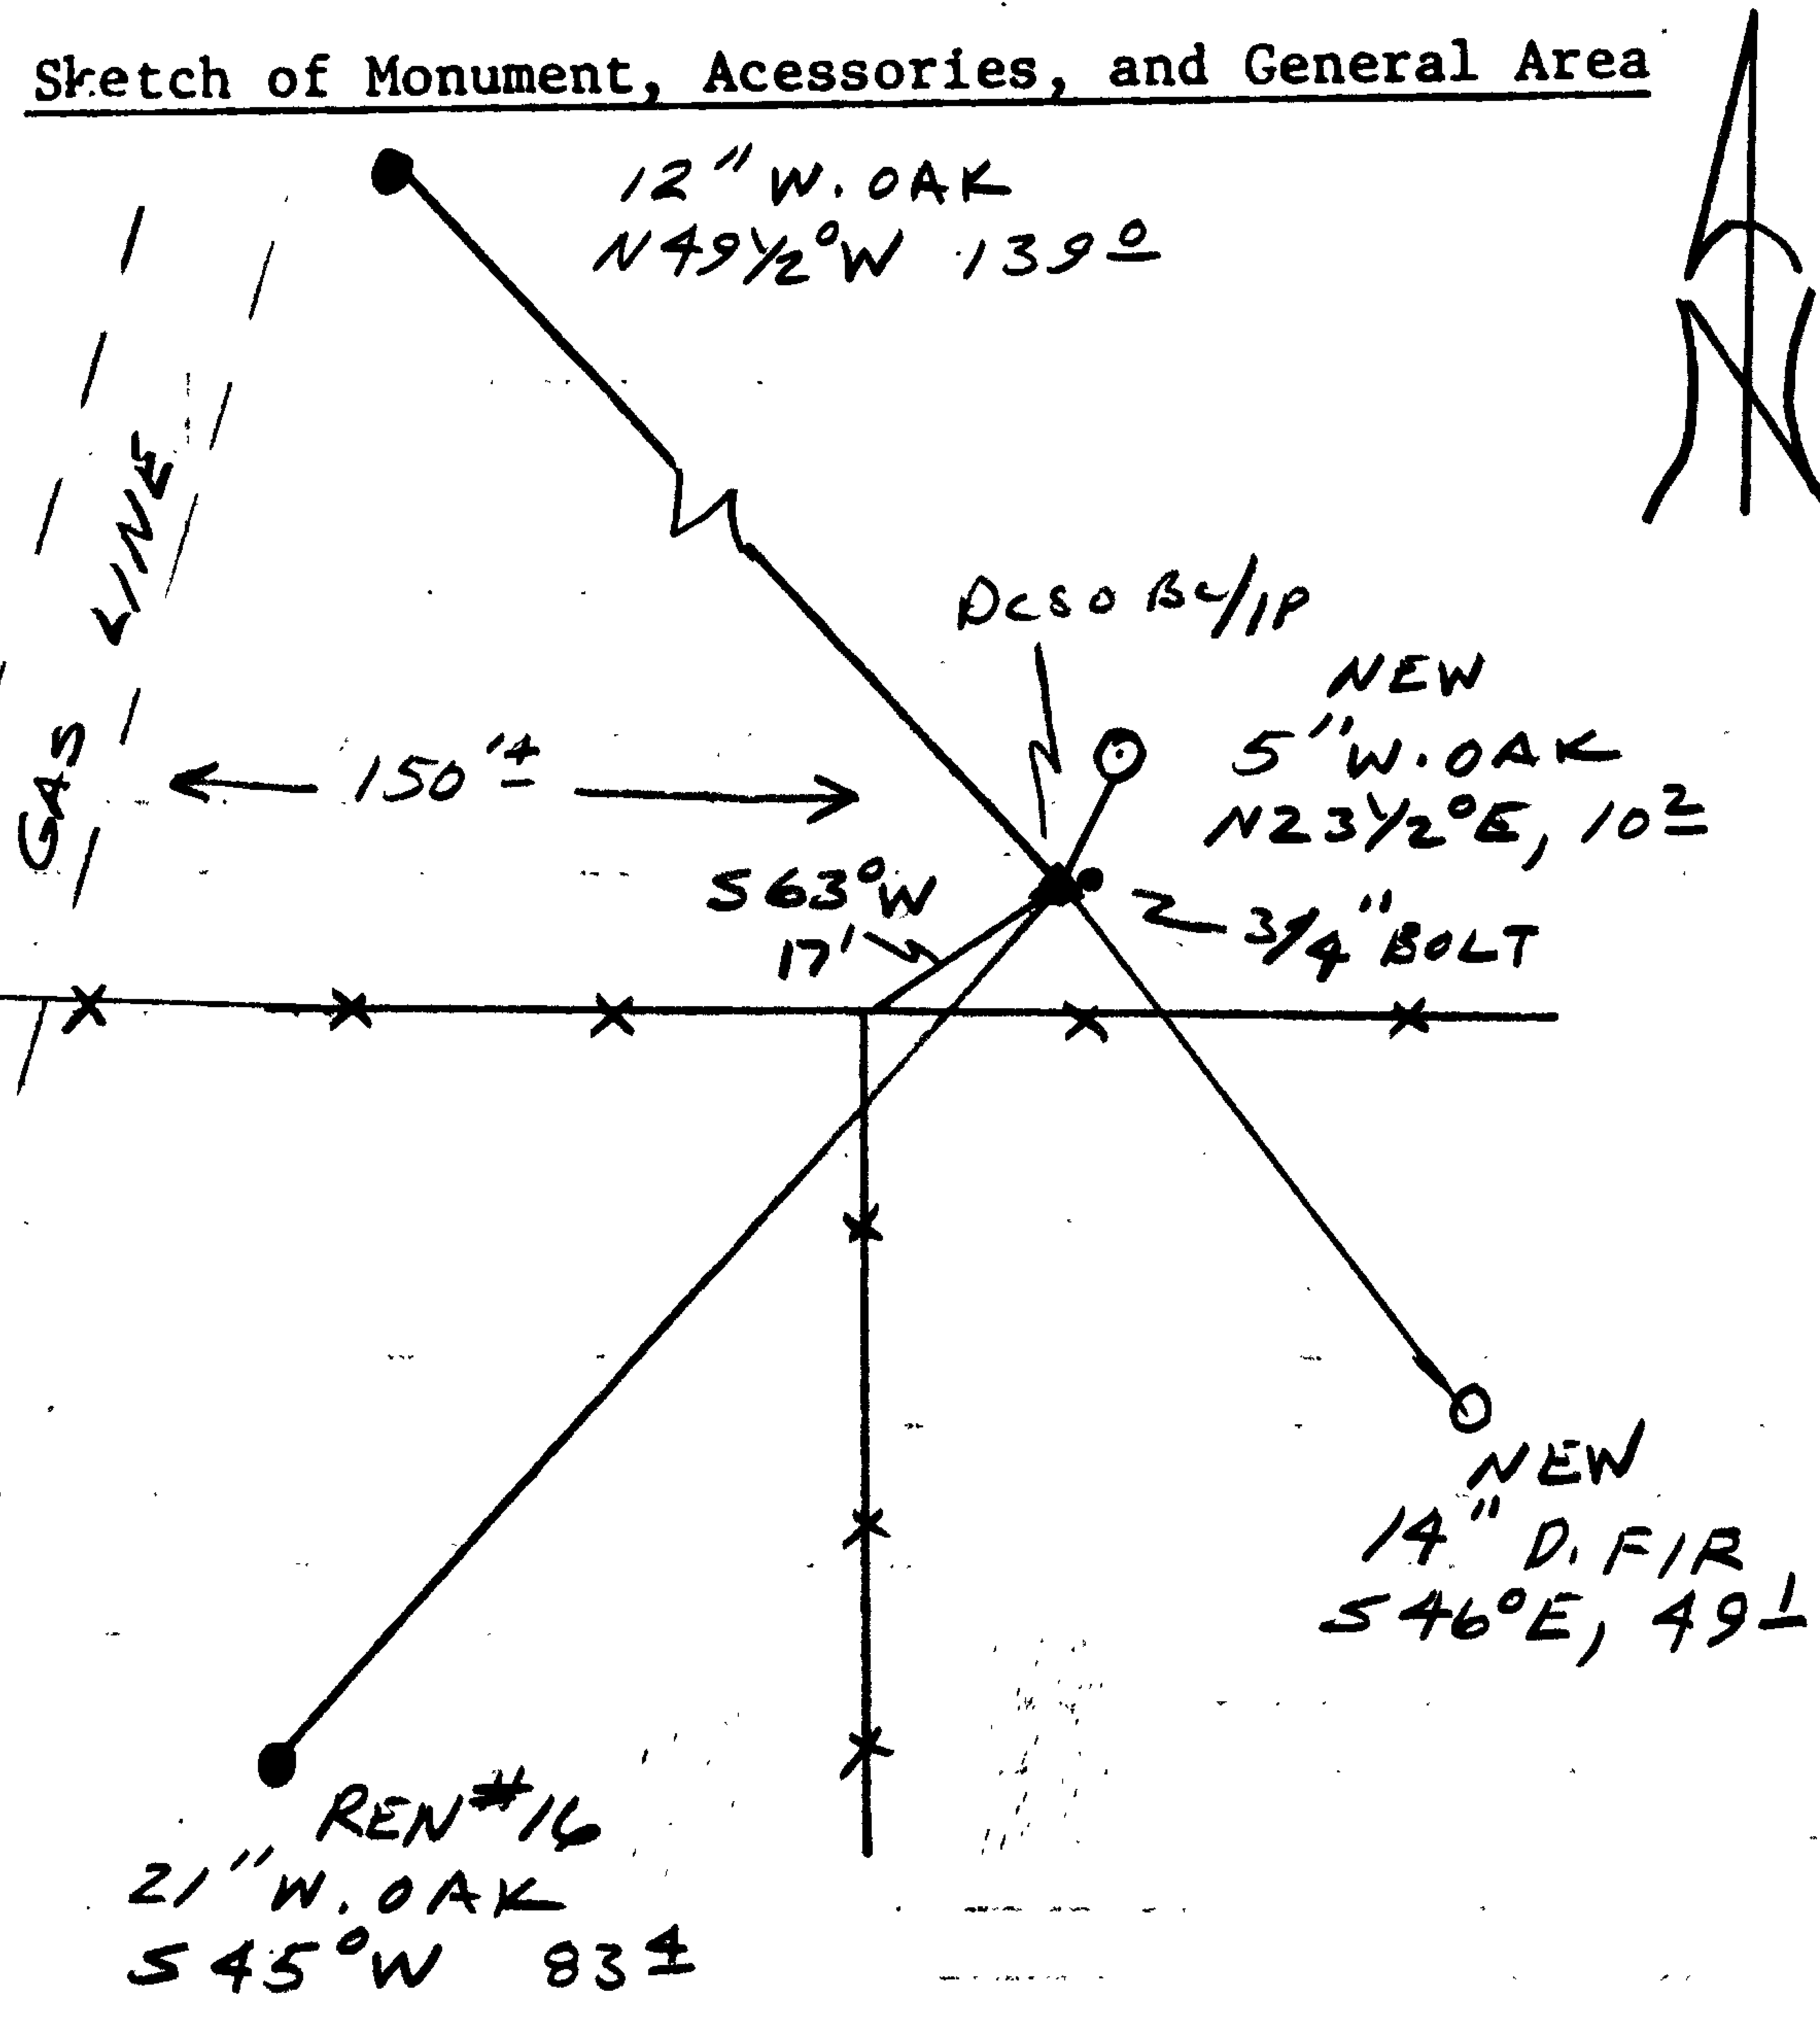

Location & Comments

CORNER IS APPROX. 150 FT
EAST OF GAS LINE NEAR
THE INTERSECTION OF AN
EAST - WEST AND SOUTH
RUNNING FENCE LINE.

Comp. Declin. 18° E
Agency DCSO
Party Chief RANDALL V SMITH
Notekeeper Randall W Smith
Witnesses STEPHEN J FLAUSE
TERRIE FRANSEN

Address

Surveyor's Seal
REGISTERED
PROFESSIONAL
LAND SURVEYOR

Randall W Smith

OREGON
JULY 25, 1990
RANDALL W. SMITH
2469