

GOVERNMENT CORNER RESTORATION FORM

FILED

Township 30 S Range 2 W Sec. 16 County DOUGLAS

sh
MAR 27 1991

State OR Date 3/22/91 No. _____

COUNTY SURVEYOR
DOUGLAS COUNTY, ORE.

Corner Designation _____

S20 | 516
 | 521

- _____ Condition Report Only
- _____ Not Found
- Renewed
- _____ Unrecorded
- _____ Surveyed In
- _____ Referenced Out

Previous Renewals # 167 # 251

MONUMENT DETAIL

Monument(s) Found: (Condition and Source)

2 1/2" DIA. DCSO BRASS CAP ON A 1 1/4"
O.D. IRON PIPE PROTRUDING 13"
ABOVE GROUND REN # 167

ORIG 16" X 10" X 8" STONE WITH FAINT
MARKS "CC" ON SOUTH FACE FOUND
LOOSE - ON TOP OF GROUND ALONG
NORTH SIDE OF DCSO BC/IP.

COUNTY SURVEYORS OFFICE

T30S R5W
S20 | 516 C.
 | 521 C.
1968

Accessories Found:

30" NOW 32" DIA 6 FT HIGH BURNT AND ROTTED D. FIR SNAG
NO BLAZES OR SCRIBING VISIBLE, BEARS N21°E, 25.1 FT
(REC. N25°E, 25.1 FT) ORIG.

24" NOW 30" DIA 4 FT HIGH BURNT AND ROTTED D. FIR STUMP
WITH A HEALED BLAZE, BEARS S72°E, 12.5 FT. (AGREES
WITH REC) ORIG.

12" NOW 13" DIA W. FIR WITH A PARTIALLY HEALED SINGLE
BLAZE, SCRIBING VISIBLE "S16 BT" BEARS N29°E, 37.8 FT
(REC. N31°E, 37.8 FT.) REN #251

6" NOW 6" DIA. 18" HIGH BURNT CEDAR STUMP WITH SCRIBE
MARKS "BT" VISIBLE ON BURNT BLAZE, BEARS S24°E,
28.0 FT. (AGREES WITH REC) REN #251

C.S. File No. 64113-10

#2754

RENEWAL

Monument Set (Procedure and Description)

Monument Detail

NONE

N/A

DCSO BC/1P T30S R2W SW COR SEC 17
BEARS NORTH 100 FT

36" DIA. 3 FT HIGH D. FIR STUMP WITH AN
8" LONG BOAT SPIKE SET
NEAR CENTER OF STUMP, B.S.
IS STAMPED "B02", BS BEARS S31°E,
20.4 FT


New Accessories

8" DIA. CEDAR DOUBLE BLAZED AND SCRIBED "T30S R2W S16 CC CS BT"
BEARS N72°E, 24.8 FT

32" DIA 2 FT HIGH D. FIR STUMP WITH AN 8" LONG BOAT SPIKE SET
THROUGH BT TAG NEAR CENTER OF STUMP, B.S. IS STAMPED "B01"
B.S. BEARS S84°E, 15.1 FT

Sketch of Monument, Accessories, and General Area

Location & Comments

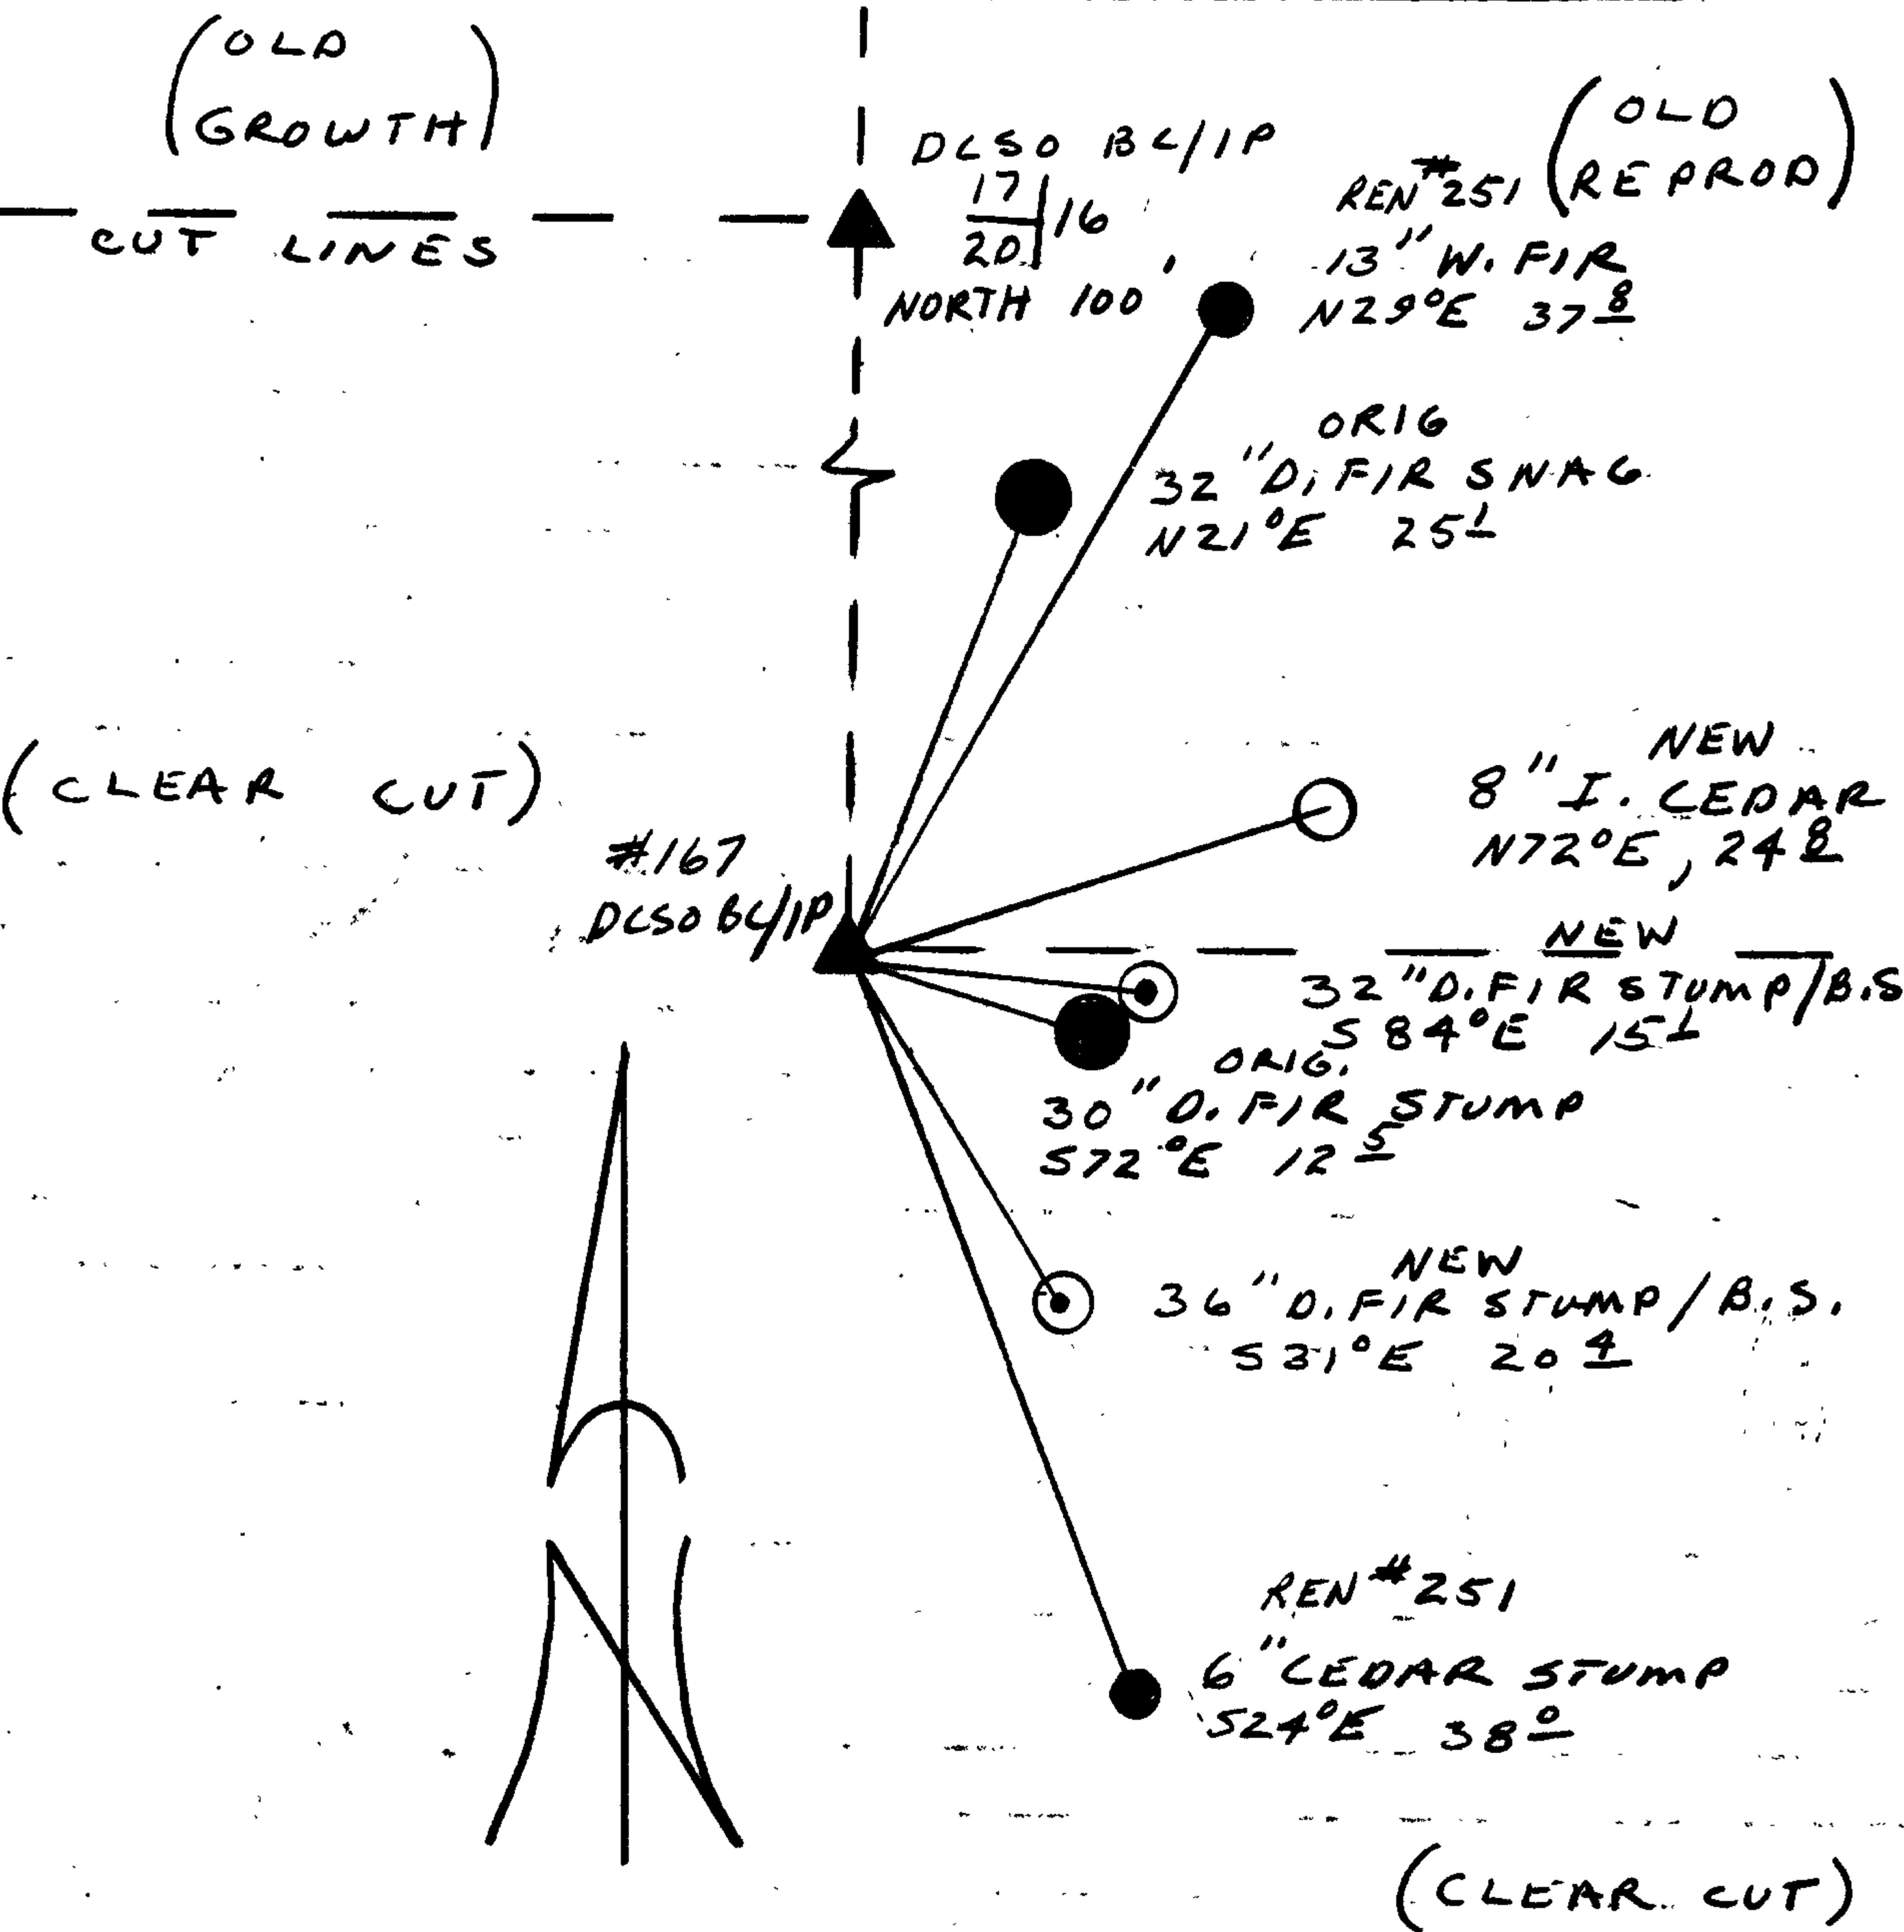

Location & Comments

Comp. Declin. 18°
Agency DCSO
Party Chief RANDALL W SMITH
Notekeeper Randall W Smith
Witnesses STEPHEN J FLAUSE
TERRIE FRANSSEN

Address

Surveyor's Seal
REGISTERED
PROFESSIONAL
LAND SURVEYOR

Randall W Smith

OREGON
JULY 25, 1990
RANDALL W. SMITH
2488