

GOVERNMENT CORNER RESTORATION FORM

FILED

Township 30S Range ZW Sec. 17 County DOUGLAS

JK
MAR 27 1991

State OR Date 3/22/91 No. _____

COUNTY SURVEYOR
DOUGLAS COUNTY, OR

Corner Designation _____

S17 | S16
S20

- _____ Condition Report Only
- _____ Not Found
- Renewed
- _____ Unrecorded
- _____ Surveyed In
- _____ Referenced Out

Previous Renewals #168 #252

MONUMENT DETAIL

Monument(s) Found: (Condition and Source)

1 1/4" DIA. DCSO BRASS CAP ON A
1 1/4" O.D. IRON PIPE PROTRUDES
11" ABOVE GROUND. (REN #168)

COUNTY SURVEYORS OFFICE

T30S R2W

S17 | S16
S20

1968

Accessories Found:

20" NOW 26" DIA. 6 FT HIGH D. FIR STUMP WITH A PREVIOUSLY
OPENED BLAZE, SCRIBING VISIBLE "T" BEARS S54°W, 15.8 FT
(AGREES WITH REC) ORIG. BT

40" NOW 44" DIA D. FIR WITH A FULLY HEALED SINGLE BLAZE
BEARS N35°W, 33.7 FT (AGREES WITH REC) ORIG. BT

6" NOW 6" DIA 5 FT HIGH FIR STUMP WITH AN UNHEALED SINGLE
BLAZE SCRIBING VISIBLE "S20 SC. BT" BEARS S35°W, 25.2 FT
(AGREES WITH REC) REN #252

#2 of 4

RENEWAL

Monument Set (Procedure and Description)

NONE

Monument Detail

N/A

New Accessories


15" DIA. W. FIR DOUBLE BLAZED AND SCRIBED "T30SRZWS17CS BT"
BEARS N78°W, 20.3 FT.

4" DIA W. FIR DOUBLE BLAZED AND SCRIBED " X BT"
BEARS S75 1/2°W, 22.8 FT

DCSO BC/IP T30SRZW SW C.C.S 16 BEARS SOUTH 100 FT

Sketch of Monument, Accessories, and General Area

(OLD GROWTH)

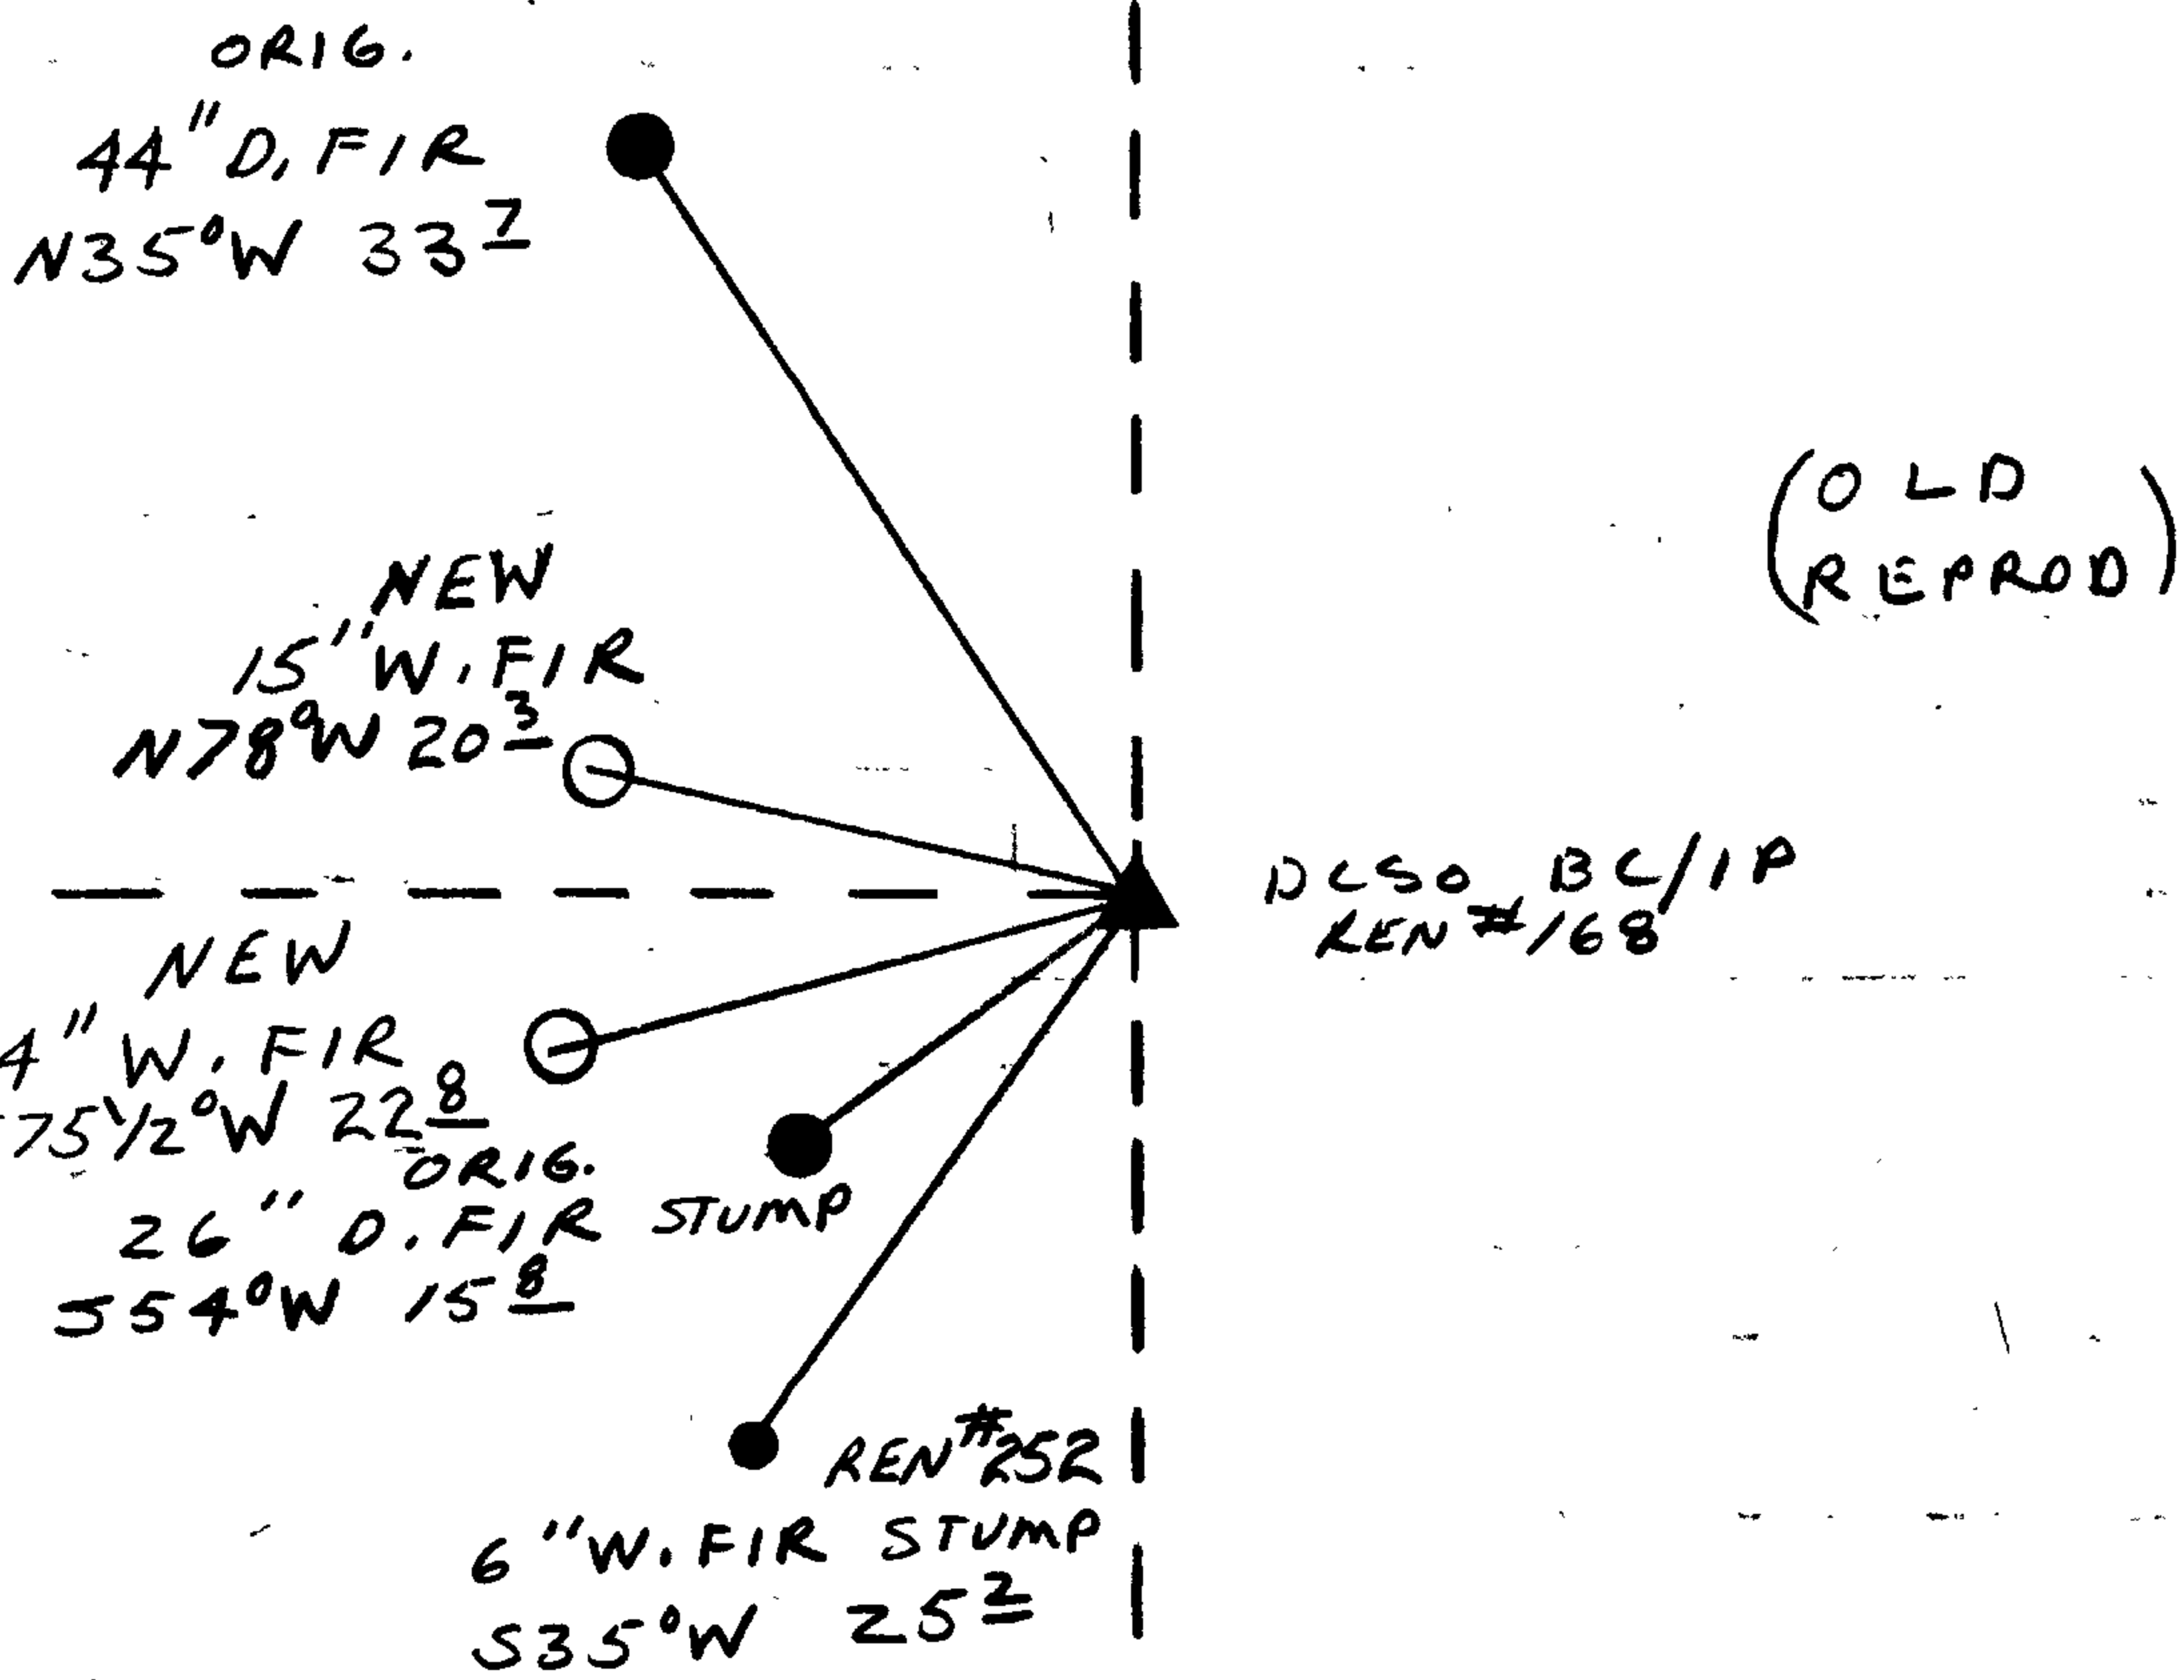

(OLD REPROD)

Location & Comments

Comp. Declin. 18° E
 Agency DCSO
 Party Chief RANDALL W. SMITH
 Notekeeper Randall W. Smith
 Witnesses STEPHEN J. FLAUSE
TERRIE FRANSSON

Address

Surveyor's Seal

REGISTERED
 PROFESSIONAL
 LAND SURVEYOR

Randall W. Smith

OREGON
 JULY 25, 1990
 RANDALL W. SMITH
 2469

DCSO BC/IP
 20 | 16 C.
 21 | 21 C.
 SOUTH 100'

(CLEAR CUT)