

GOVERNMENT CORNER RESTORATION FORM

FILED

Township 26 S Range 1 W Sec. 1

County DOUGLAS

State OR Date 4/5/91

No. \_\_\_\_\_

APR 8 1991

Corner Designation

COUNTY SURVEYOR  
DOUGLAS COUNTY, OREGON

$\frac{1}{4} \frac{S1}{S12}$

- Condition Report Only
- Not Found
- Renewed
- Unrecorded
- Surveyed In
- Referenced Out

Previous Renewals NONE

MONUMENT DETAIL

Monument(s) Found: (Condition and Source)

ORIG. STONE, TOP MEASURES  
10" X 5", PROTRUDING 5" ABOVE GROUND,  
CHISELED "1/4" ON NORTH SIDE.

N/A

Accessories Found:

36" NOW 38" DIA. TIPPED OUT OF GROUND BURNT CEDAR, NO SCRIBING  
OR BLAZES FOUND, ROOT HOLE BEARS S37°W, 31.7 FT (AGREES  
WITH REC.) ORIG. BT

ORIG. NW BT NOT FOUND

RENEWAL

Monument Set (Procedure and Description)

ORIG. STONE IS REFERENCED, STONE MEASURES 10" X 5" X 9" WITH SMALLER FRACTURED PIECES NEAR. (REC. 12" X 10" X 8") A 2 3/8" DIA. DCSO BRASS CAP ON A 1 3/8" O.D. BY 32" LONG IRON PIPE IS SET AT REFERENCED POSITION. BRASS CAP/IRON PIPE PROTRUDES 12" ABOVE GROUND. A 2 FT DIA. MOUND OF STONES IS PLACED AROUND BASE OF BC/IP WITH MARKED ORIGINAL STONE ALONG NORTH EDGE OF BC/IP, "1/4" FACES NORTH. BRASS CAP/IRON PIPE PROTRUDES 5" ABOVE MOUND OF STONE.


Monument Detail

DOUGLAS COUNTY SURVEYORS  
T265  
1/4 51 R  
512 I  
W  
1991  
OFFICE

New Accessories

- 5" DIA. D. FIR, DOUBLE BLAZED AND SCRIBED "1/4 512 CS BT", BEARS S4°E, 13.3 FT.
- 28" DIA. SUGAR PINE, DOUBLE BLAZED AND SCRIBED "1/4 512 CS BT", BEARS S68°E, 18.5 FT.
- 5" DIA. CHINQUAPIN, DOUBLE BLAZED AND SCRIBED "1/4 51 CS BT", BEARS NB66 1/2°E, 13.9 FT.
- 17" DIA. D. FIR DOUBLE BLAZED AND SCRIBED "1/4 51 CS BT", BEARS N44 1/2°W, 18.4 FT.

Sketch of Monument, Accessories, and General Area

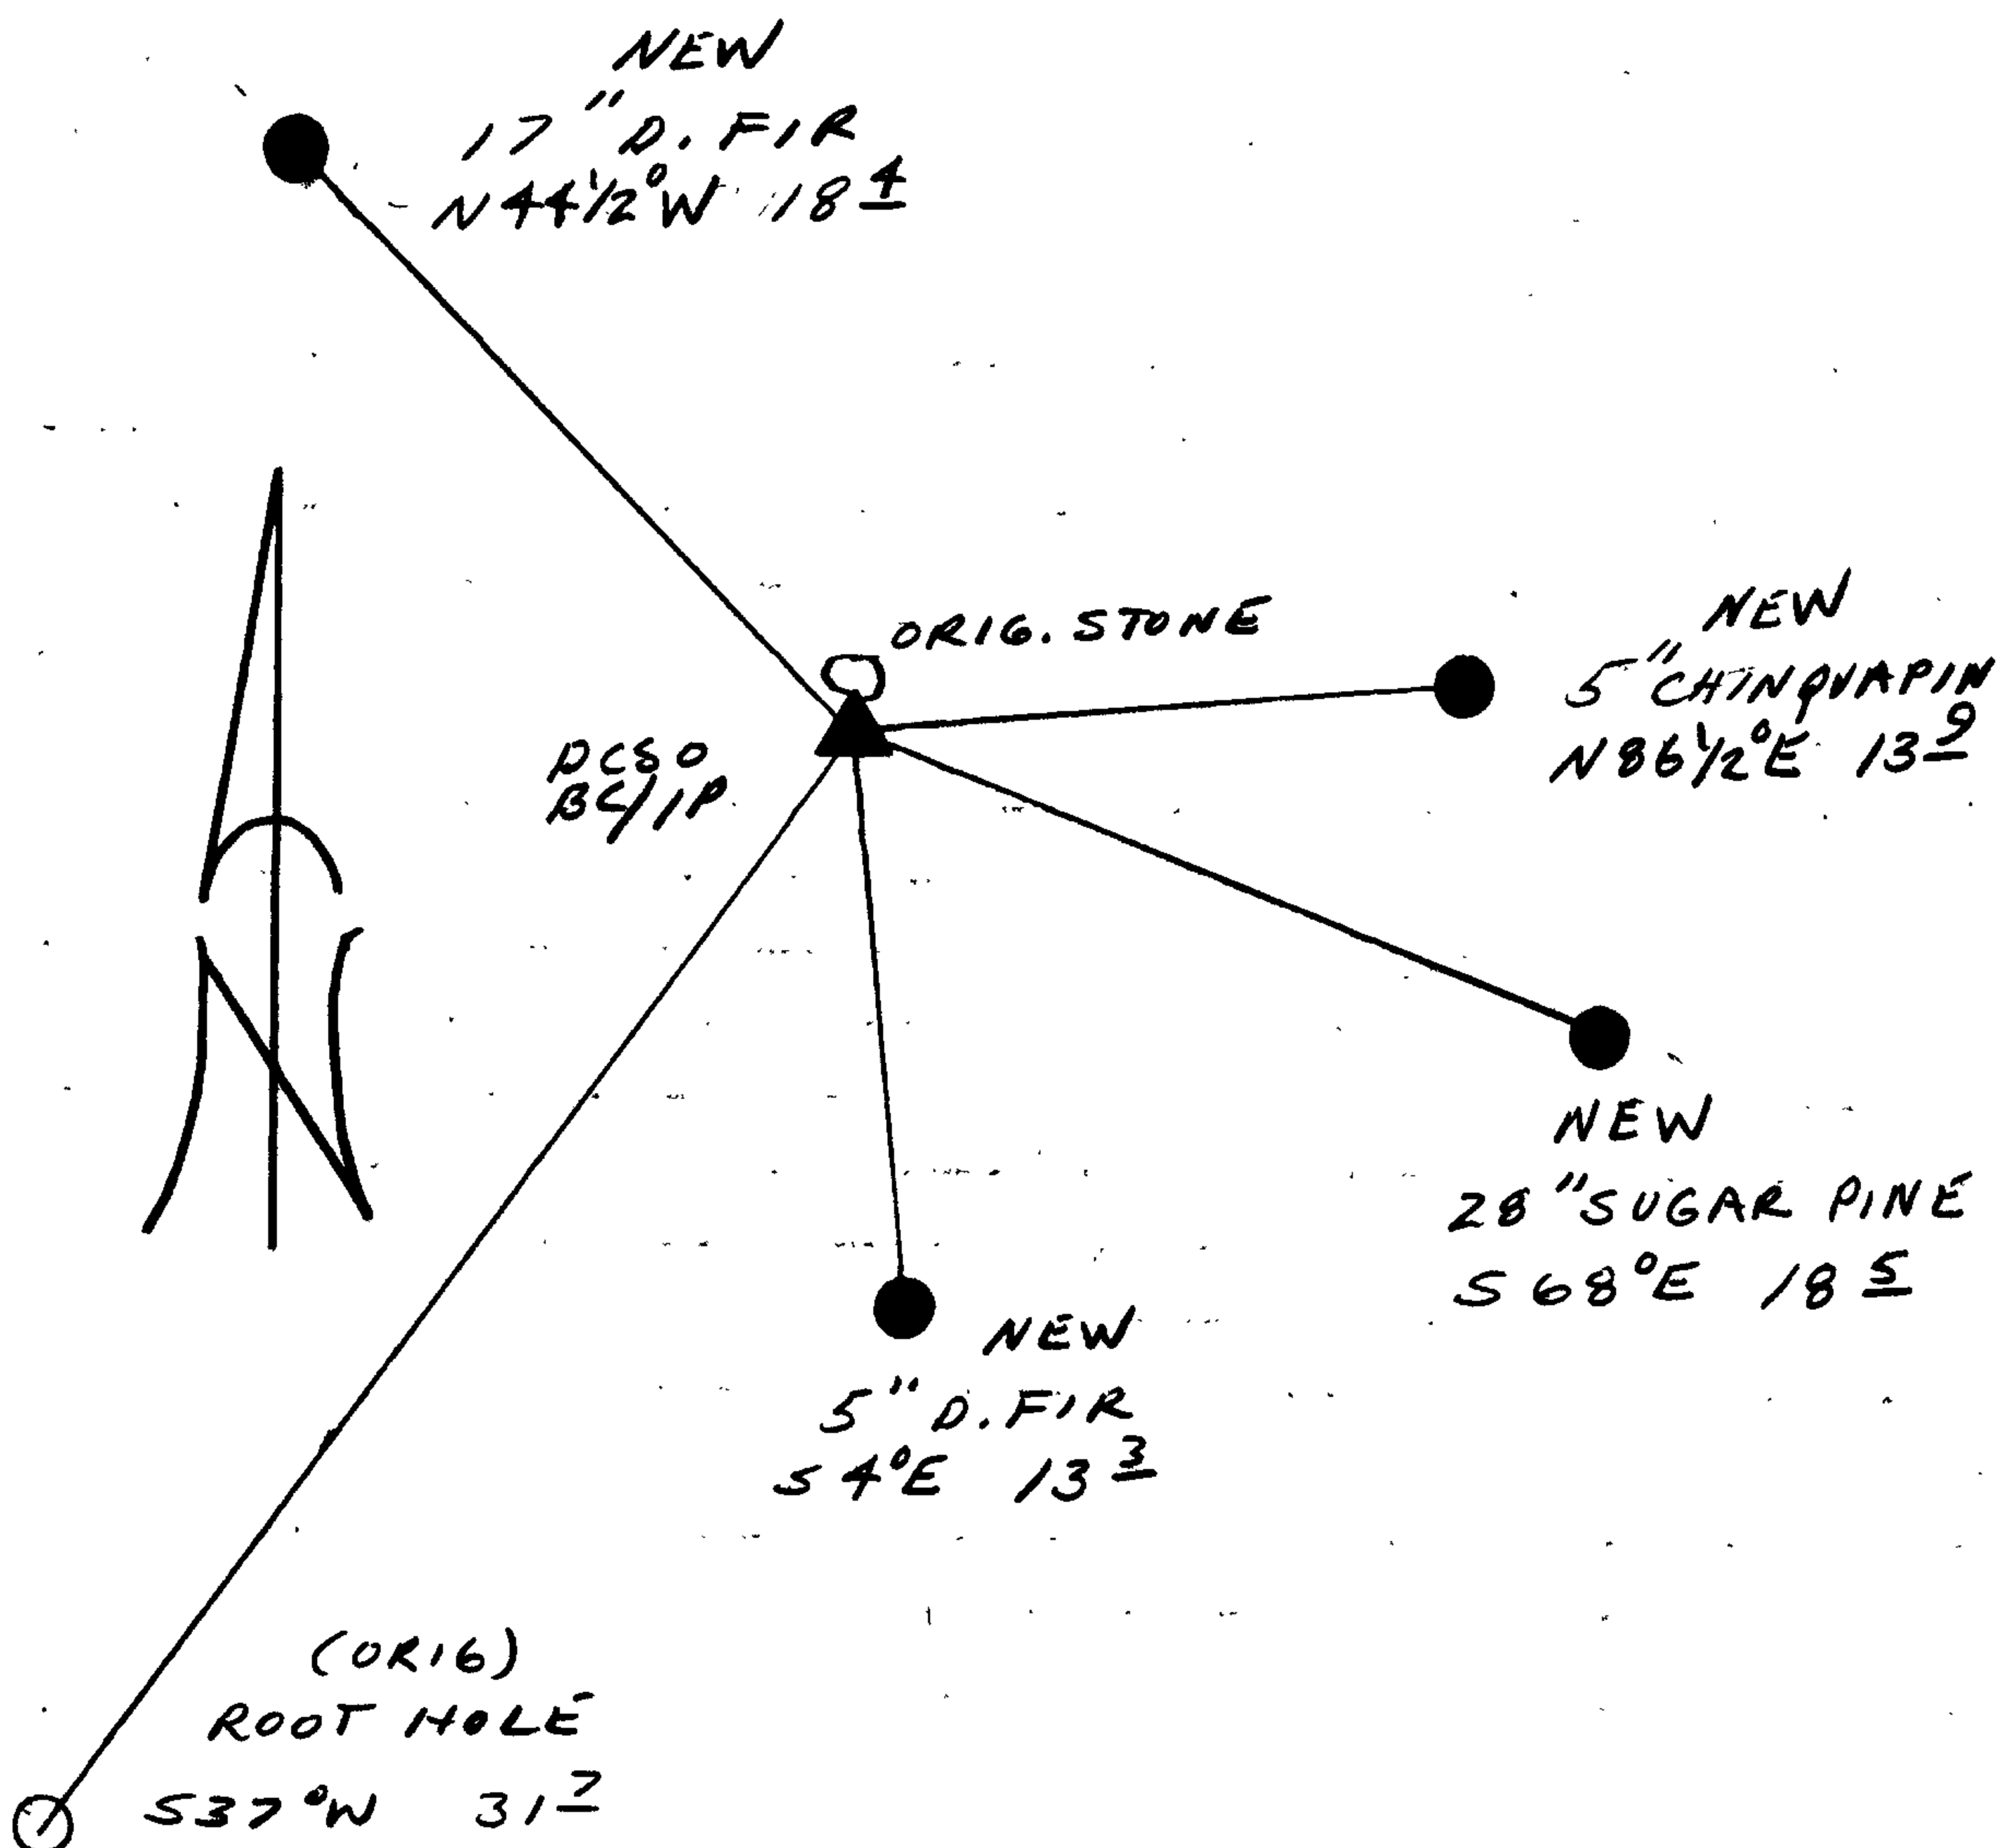

Location & Comments

Comp. Declin. 18°E  
Agency DCSO  
Party Chief RANDALL W. SMITH  
Notekeeper Randall W. Smith  
Witnesses STEPHEN J. FLAYSE

Address

Surveyor's Seal

REGISTERED  
PROFESSIONAL  
LAND SURVEYOR

*Randall W. Smith*

OREGON  
JULY 25, 1990  
RANDALL W. SMITH  
2488