

FILED

GOVERNMENT CORNER RESTORATION FORM

Handwritten initials

Township 26S Range 1E Sec. 7

County DOUGLAS APR 8 1991

State OR Date 4/4/91

No. _____ COUNTY SURVEYOR
DOUGLAS COUNTY, ORE.

Corner Designation

1/4
S7
ONLY

- Condition Report Only
- Not Found
- Renewed
- Unrecorded
- Surveyed In
- Referenced Out

Previous Renewals

MONUMENT DETAIL

Monument(s) Found: (Condition and Source)

2 1/2" DIA. GLO BRASS CAP ON A 1"
O. D. IRON PIPE PROTRUDING 11"
ABOVE GROUND. A 2 FT DIA.
MOUND OF STONE IS FOUND
ALONG EAST EDGE OF BC/IP
(REC. RAISED MOUND OF STONE 3 FT,
2 FT HIGH E. OF COR.)
(ORIG. COR)

U.S. GENERAL LAND OFFICE SURVEY

1/4
S7

1928

Accessories Found:

20" NW 39" DIA. D. FIR WITH A FULLY HEALED SINGLE BLAZE,
BEARS N 56° E, 19.1 FT (REC. N 60° E, 19.1 FT) ORIG BT

~~26-1E #55~~ X

~~26-1W #117~~ X

RENEWAL

Monument Set (Procedure and Description)

NONE


Monument Detail

N/A

New Accessories

- 14" DIA. D. FIR DOUBLE BLAZED AND SCRIBED "1/4 S7 CS BT"
BEARS S28°E, 4.6 FT
- 15" DIA. D. FIR DOUBLE BLAZED AND SCRIBED "1/4 S7 CS BT"
BEARS S2°E, 34.8 FT
- 8" DIA. D. FIR DOUBLE BLAZED AND SCRIBED "1/4 S7 CS BT"
BEARS N71°E, 32.7 FT

Sketch of Monument, Accessories, and General Area

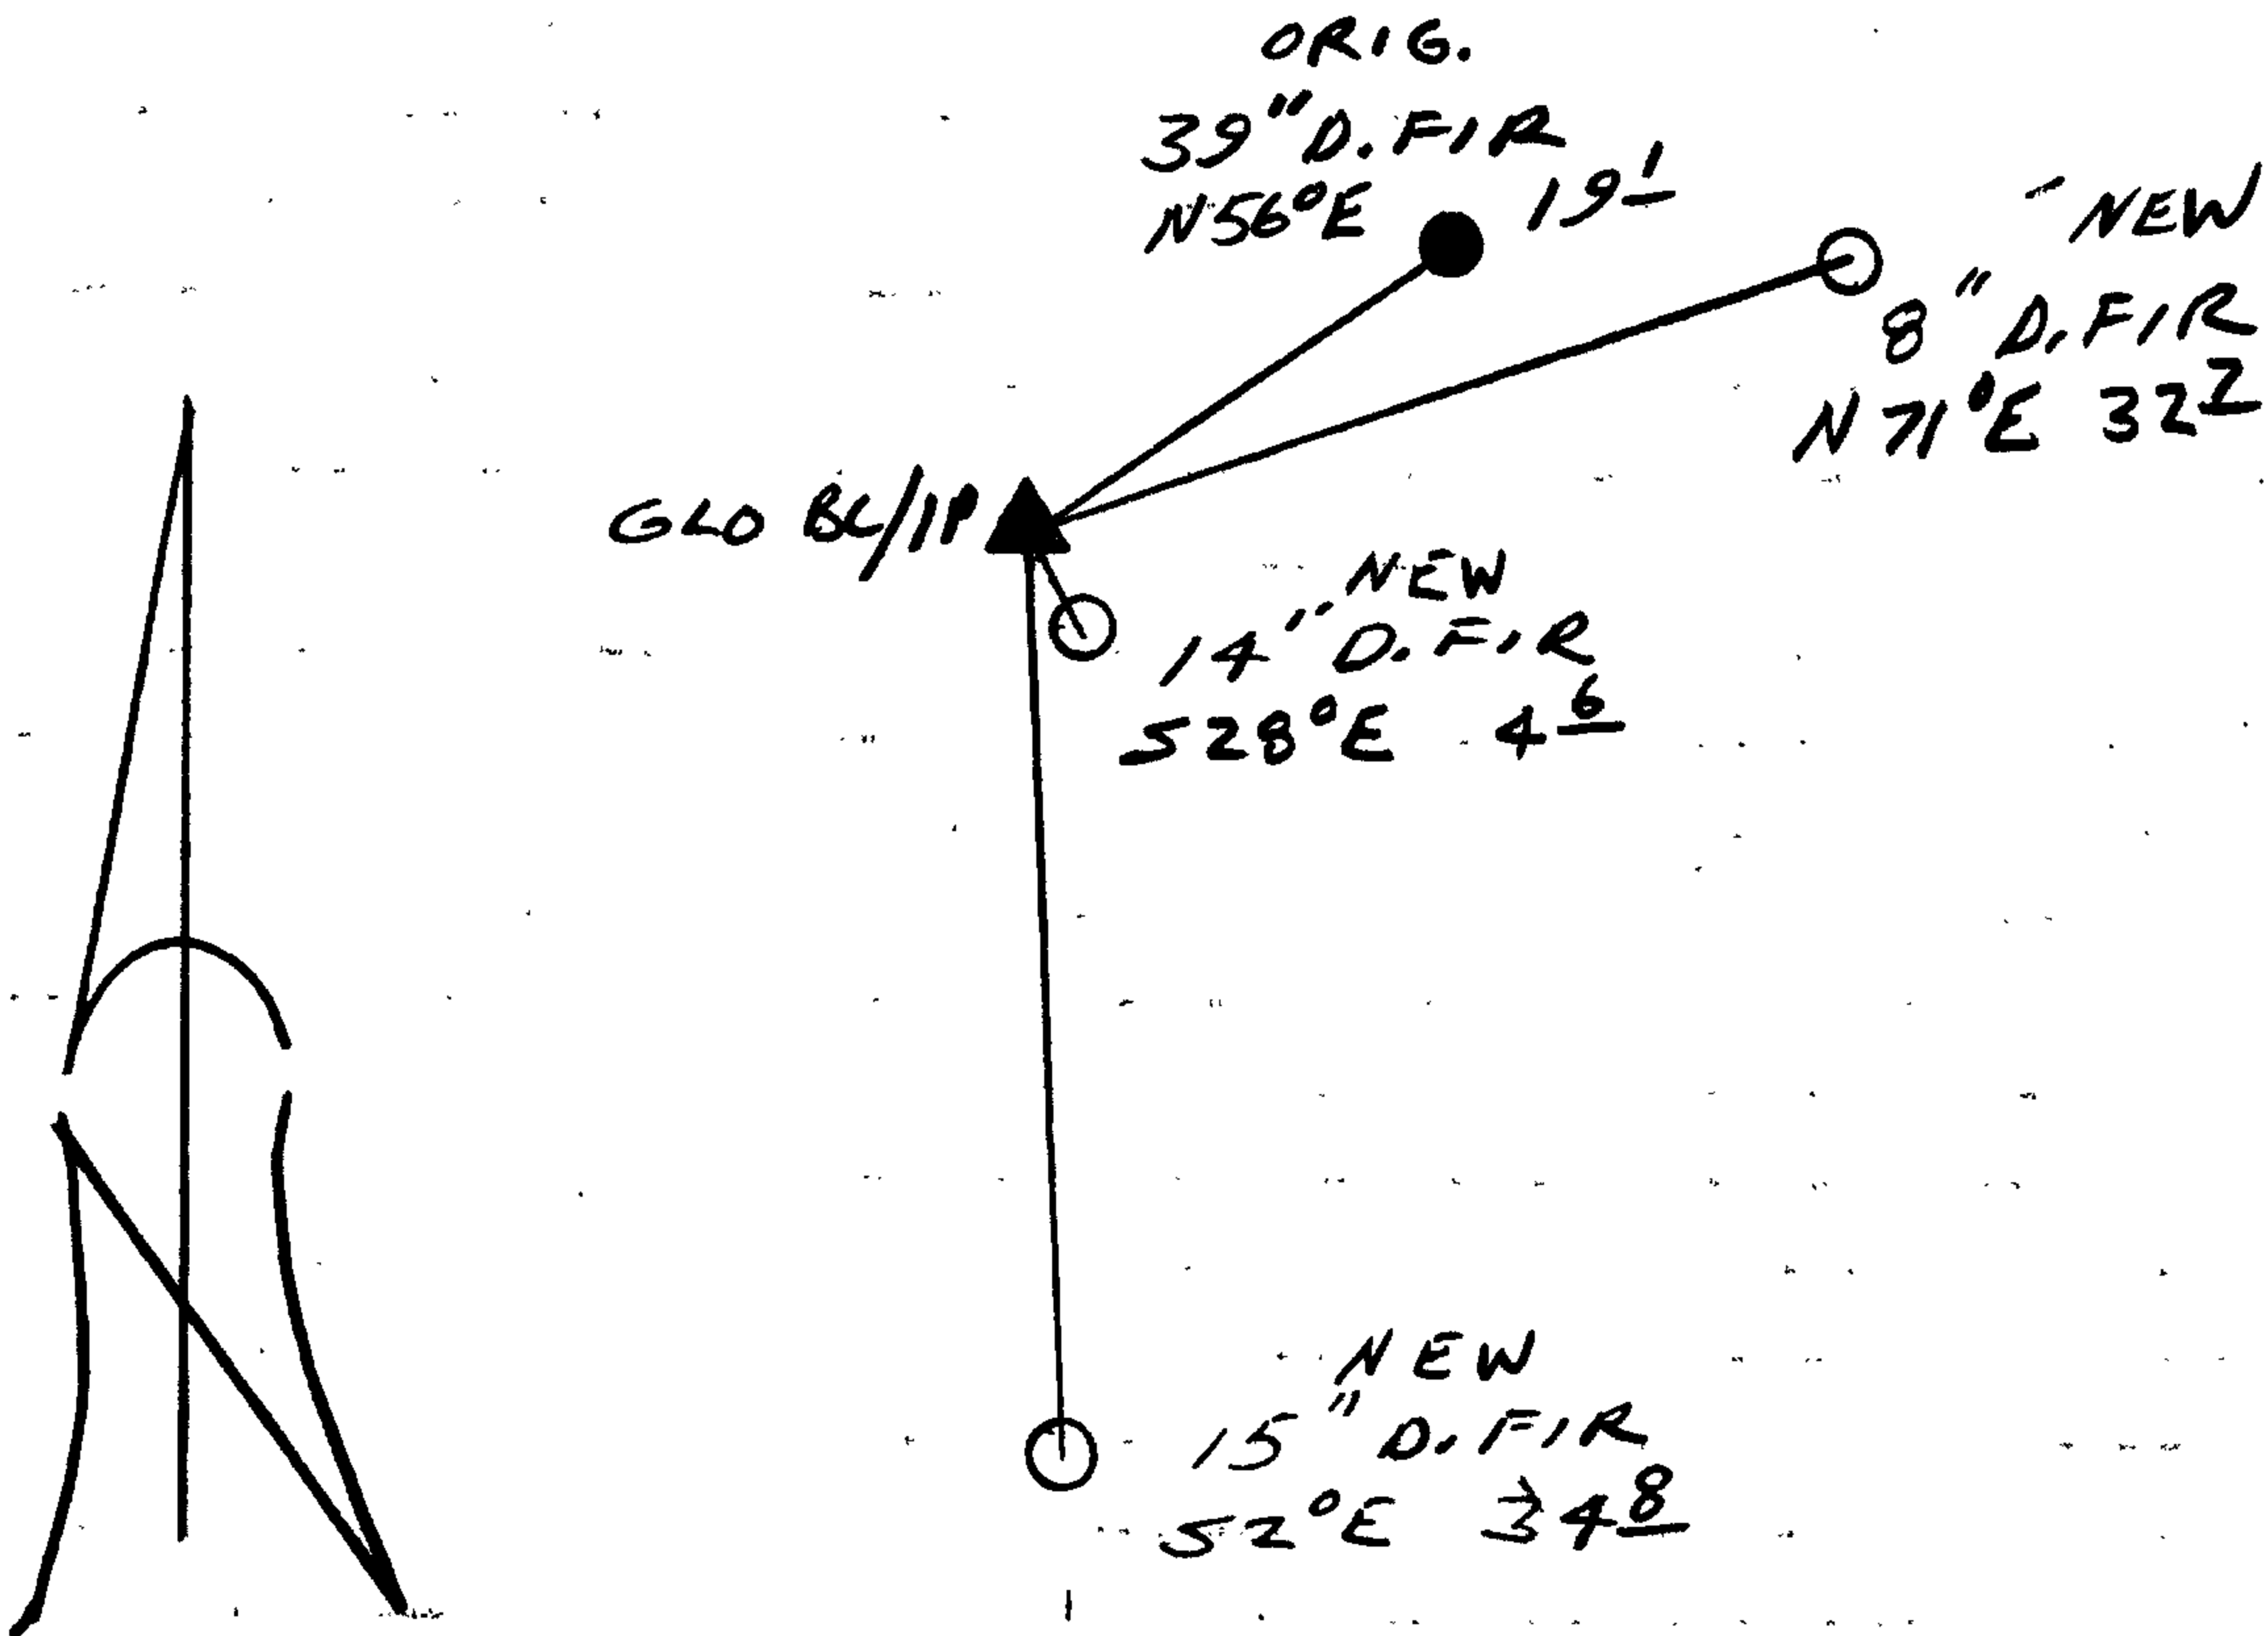

Location & Comments

CORNER LIES ON A WESTERLY SLOPE

Comp. Declin. 18°E
 Agency DCSO
 Party Chief RANDALL W. SMITH
 Notekeeper [Signature]
 Witnesses STEPHEN J. FLANSE
TERRIE FRANSSEN

Address

Surveyor's Seal

REGISTERED
 PROFESSIONAL
 LAND SURVEYOR

[Signature]

OREGON
 JULY 25, 1990
 RANDALL W. SMITH
 2469