

GOVERNMENT CORNER RESTORATION FORM

FILED

SR

Township 31S Range 2W Sec. 12 County DOUGLAS

APR 8 1991

State OR Date 4/3/91 No. _____

COUNTY SURVEYOR
DOUGLAS COUNTY, OREGON

Corner Designation

W 1/16 S 12
S 13

- Condition Report Only
- Not Found
- Renewed
- Unrecorded
- Surveyed In
- Referenced Out

Previous Renewals M1-38

Monument(s) Found: (Condition and Source)

FOUND A STONE
FIRMLY SET, TOP MEASURES
12" X 4" PROTRUDING 5" ABOVE
GROUND (M1-38)

N/A

Accessories Found:

18" NOW 15" DIA. 15FT TALL D. FIR SNAG WITH A
FULLY HEALED UPPER BLAZE, THE SCRIBING "BT" IS VISIBLE ON
LOWER BARK SCRIBED BLAZE. BEARS N 23° E, 21.5 FT
(REC. N 23° E, 21.8 FT IS A SLOPE DISTANCE). (M1-38)

17" NOW 16" DIA. DOWN AND ROTTED D. FIR, SCRIBING
IS FOUND "W", BEARS S 83° W, 9.2 FT (AGREES WITH
RECORD) (M1-38)

X

RENEWAL

Monument Set (Procedure and Description)

Monument Detail

POSITION OF STONE IS REFERENCED AND A 2 3/8" DIA. DCSO BRASS CAP ON A 1/2" O.D. BY 32" LONG IRON PIPE IS SET AT REFERENCED POSITION, PROTRUDING 6 IN ABOVE GROUND.

4" X 12" X 20" STONE IS SET ALONG NORTH EDGE OF DCSO BC/IP PROTRUDING 6" ABOVE GROUND.


DOUGLAS COUNTY SURVEYORS
 T 31 S
 S 12 R
 W 1/16 S 13 2
 W
 1991
 OFFICE

New Accessories

22" DIA. T CEDAR IS DOUBLE BLAZED AND SCRIBED "W 1/16 S 12 CS BT" BEARS N 70° E, 48.8 FT
 4" DIA. D. FIR DOUBLE BLAZED AND SCRIBED "X BT" BEARS N 20° W, 18.7 FT
 9" DIA. D. FIR DOUBLE BLAZED AND SCRIBED "W 1/16 S 13 CS BT" BEARS S 59° E, 20.0 FT
 10" DIA. D. FIR DOUBLE BLAZED AND SCRIBED "W 1/16 S 13 CS BT" BEARS S 50° W, 36.5 FT

Sketch of Monument, Accessories, and General Area

Location & Comments

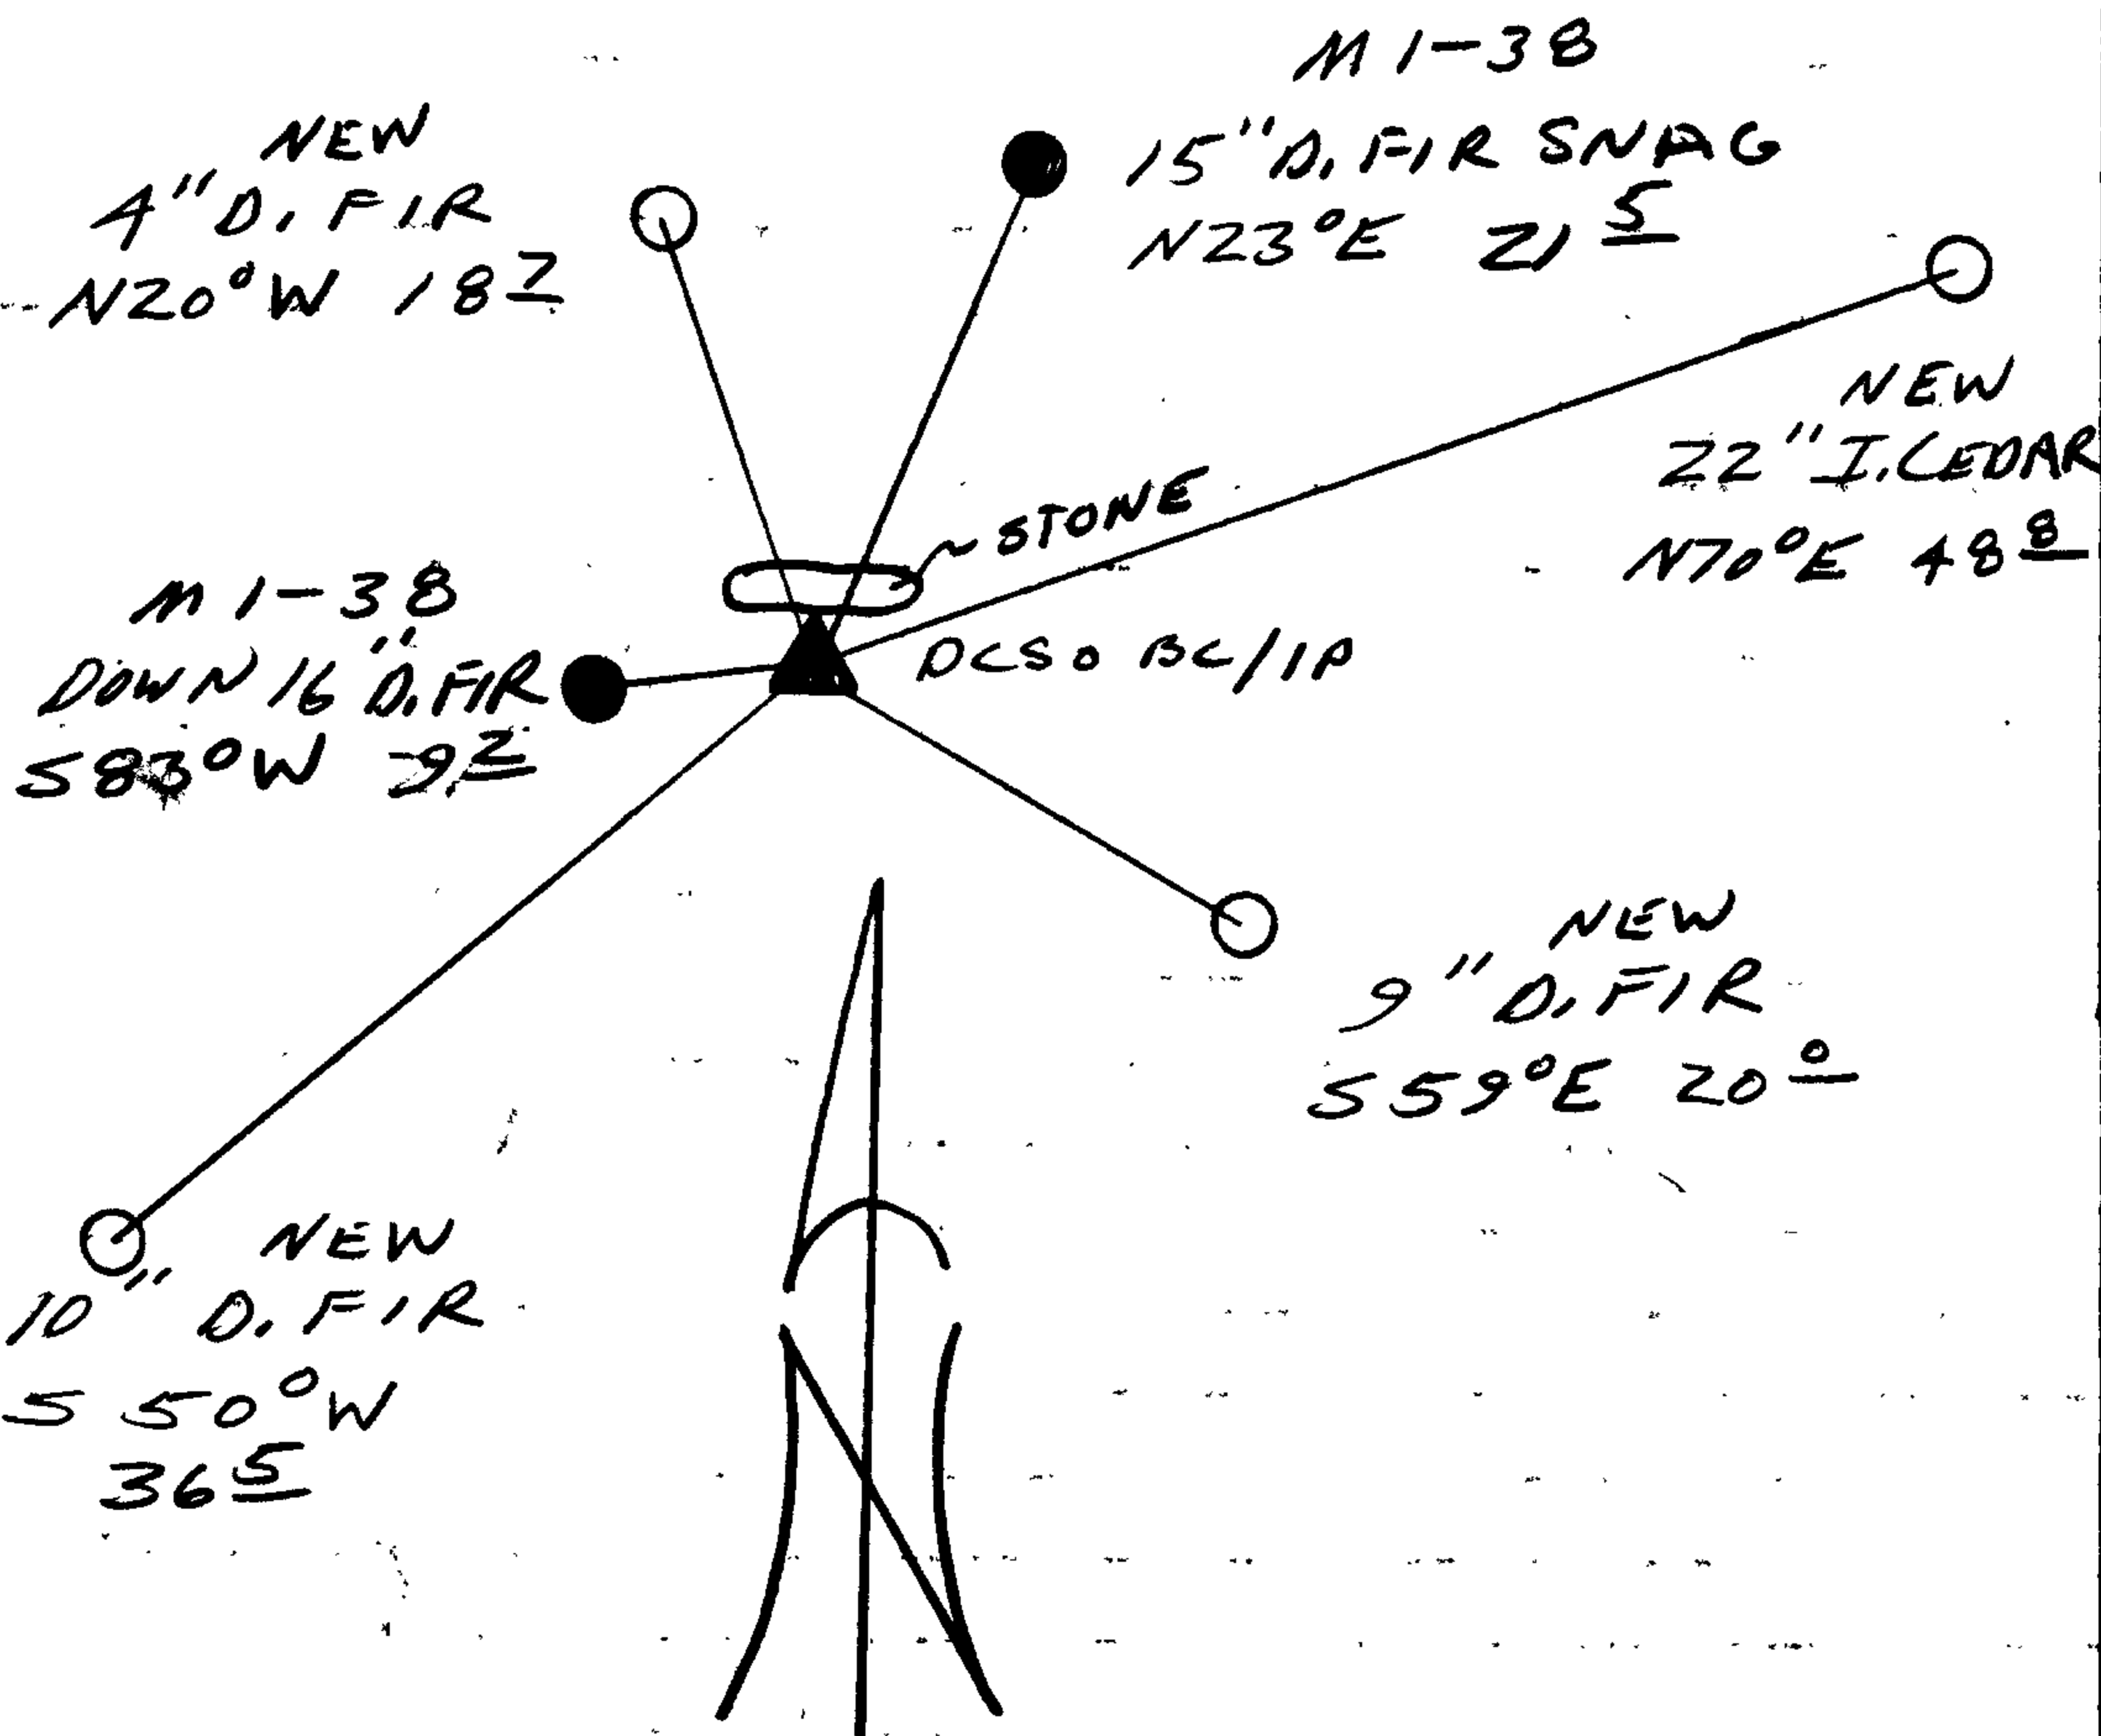

Comp. Declin. 18° E
 Agency DCSO
 Party Chief RANDALL W. SMITH
 Notekeeper Randall W. Smith
 Witnesses STEPHEN J. FLAUSIE
TERRIE FRANSSEN

Address

Surveyor's Seal

REGISTERED
 PROFESSIONAL
 LAND SURVEYOR

Randall W. Smith

OREGON
 JULY 25, 1990
 RANDALL W. SMITH
 2469