

RENEWAL

Monument Set (Procedure and Description)

Monument Detail

NONE


N/A

New Accessories

PP # 304301 (PPL 30-5) BEARS S 81 1/2° W, 85.3 FT
DCSO 5/8" I.R. (CR-11) BEARS N 10° W, 188.96 FT
7" MADRONE BARK SCRIBED "DLC 63 CS BT" BEAR N 65° W, 29.2 FT

Sketch of Monument, Accessories, and General Area

Location & Comments

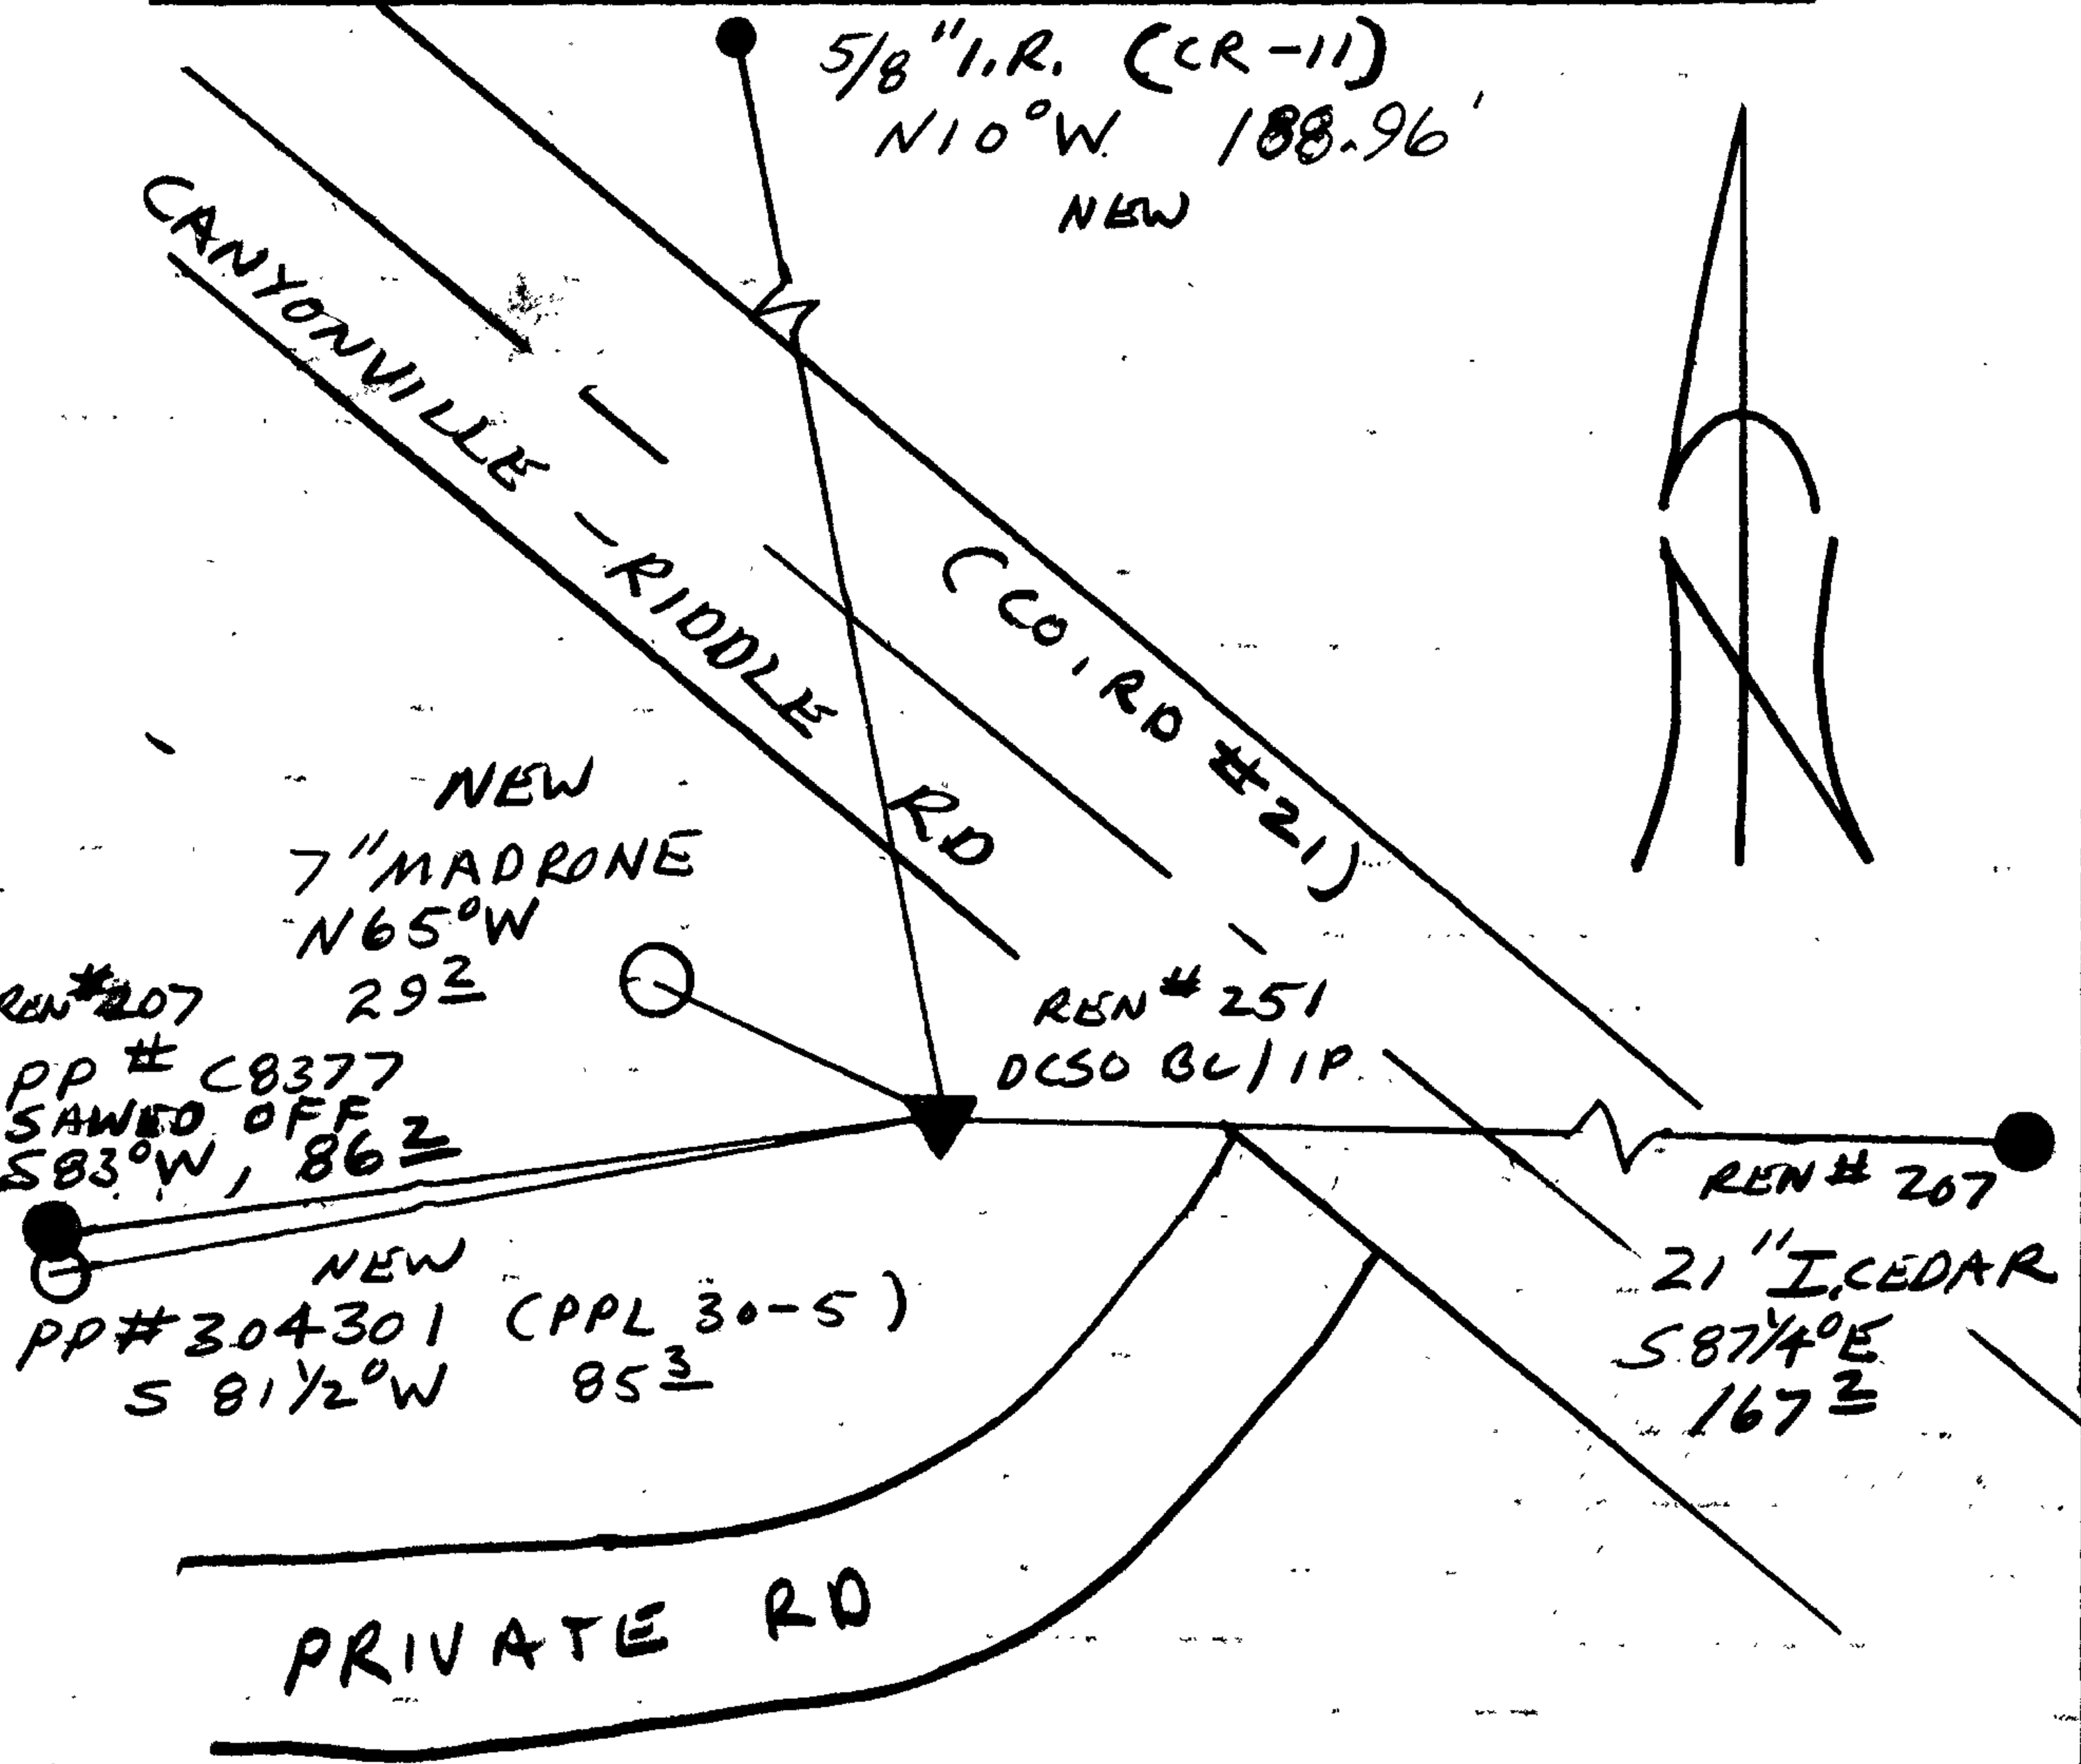

Comp. Declin. 18° E
Agency DCSO
Party Chief RANDALL W SMITH
Notekeeper Randall W Smith
Witnesses STEPHEN T FLAUSE
TERRIE FRANSSSEN
Address _____

Surveyor's Seal

REGISTERED
PROFESSIONAL
LAND SURVEYOR

Randall W Smith

OREGON
JULY 25, 1990
RANDALL W. SMITH
2469