

RENEWAL

Monument Set (Procedure and Description)

Monument Detail

3/4" I.R. IS REFERENCE AND REMOVED.
 A 2 3/8" DIA. DCSO BRASS ON A 1 3/8"
 O.D. BY 32" LONG IRON PIPE IS
 SET AT REFERENCED POSITION. BC/IP
 NOW PROTRUDING 5" ABOVE GROUND.
 3/4" I.R. MEASURES 40" LONG. I.R. IS
 SET ALONG NORTH EDGE OF BC/IP
 PROTRUDING 5" ABOVE GROUND.

1962 DCSO BC/IP (T29S R5W S1/4 SEC 21)
 BEARS WEST, 93.7 FT. (AGREES
 WITH REC.)

DOUGLAS COUNTY SURVEYORS
 T29S

NW | R
 | DCSO 5
 COR | 45 W

1991
 OFFICE


New Accessories

7" DIA MADRONE DOUBLE BLAZED AND SCRIBED "NW DCS 45 CS BT"
 BEARS S34°E, 16.4 FT.

9" DIA MADRONE DOUBLE BLAZED AND SCRIBED "NW DCS 45 CS BT"
 BEARS S45°W, 12.2 FT.

Sketch of Monument, Accessories, and General Area

Location & Comments

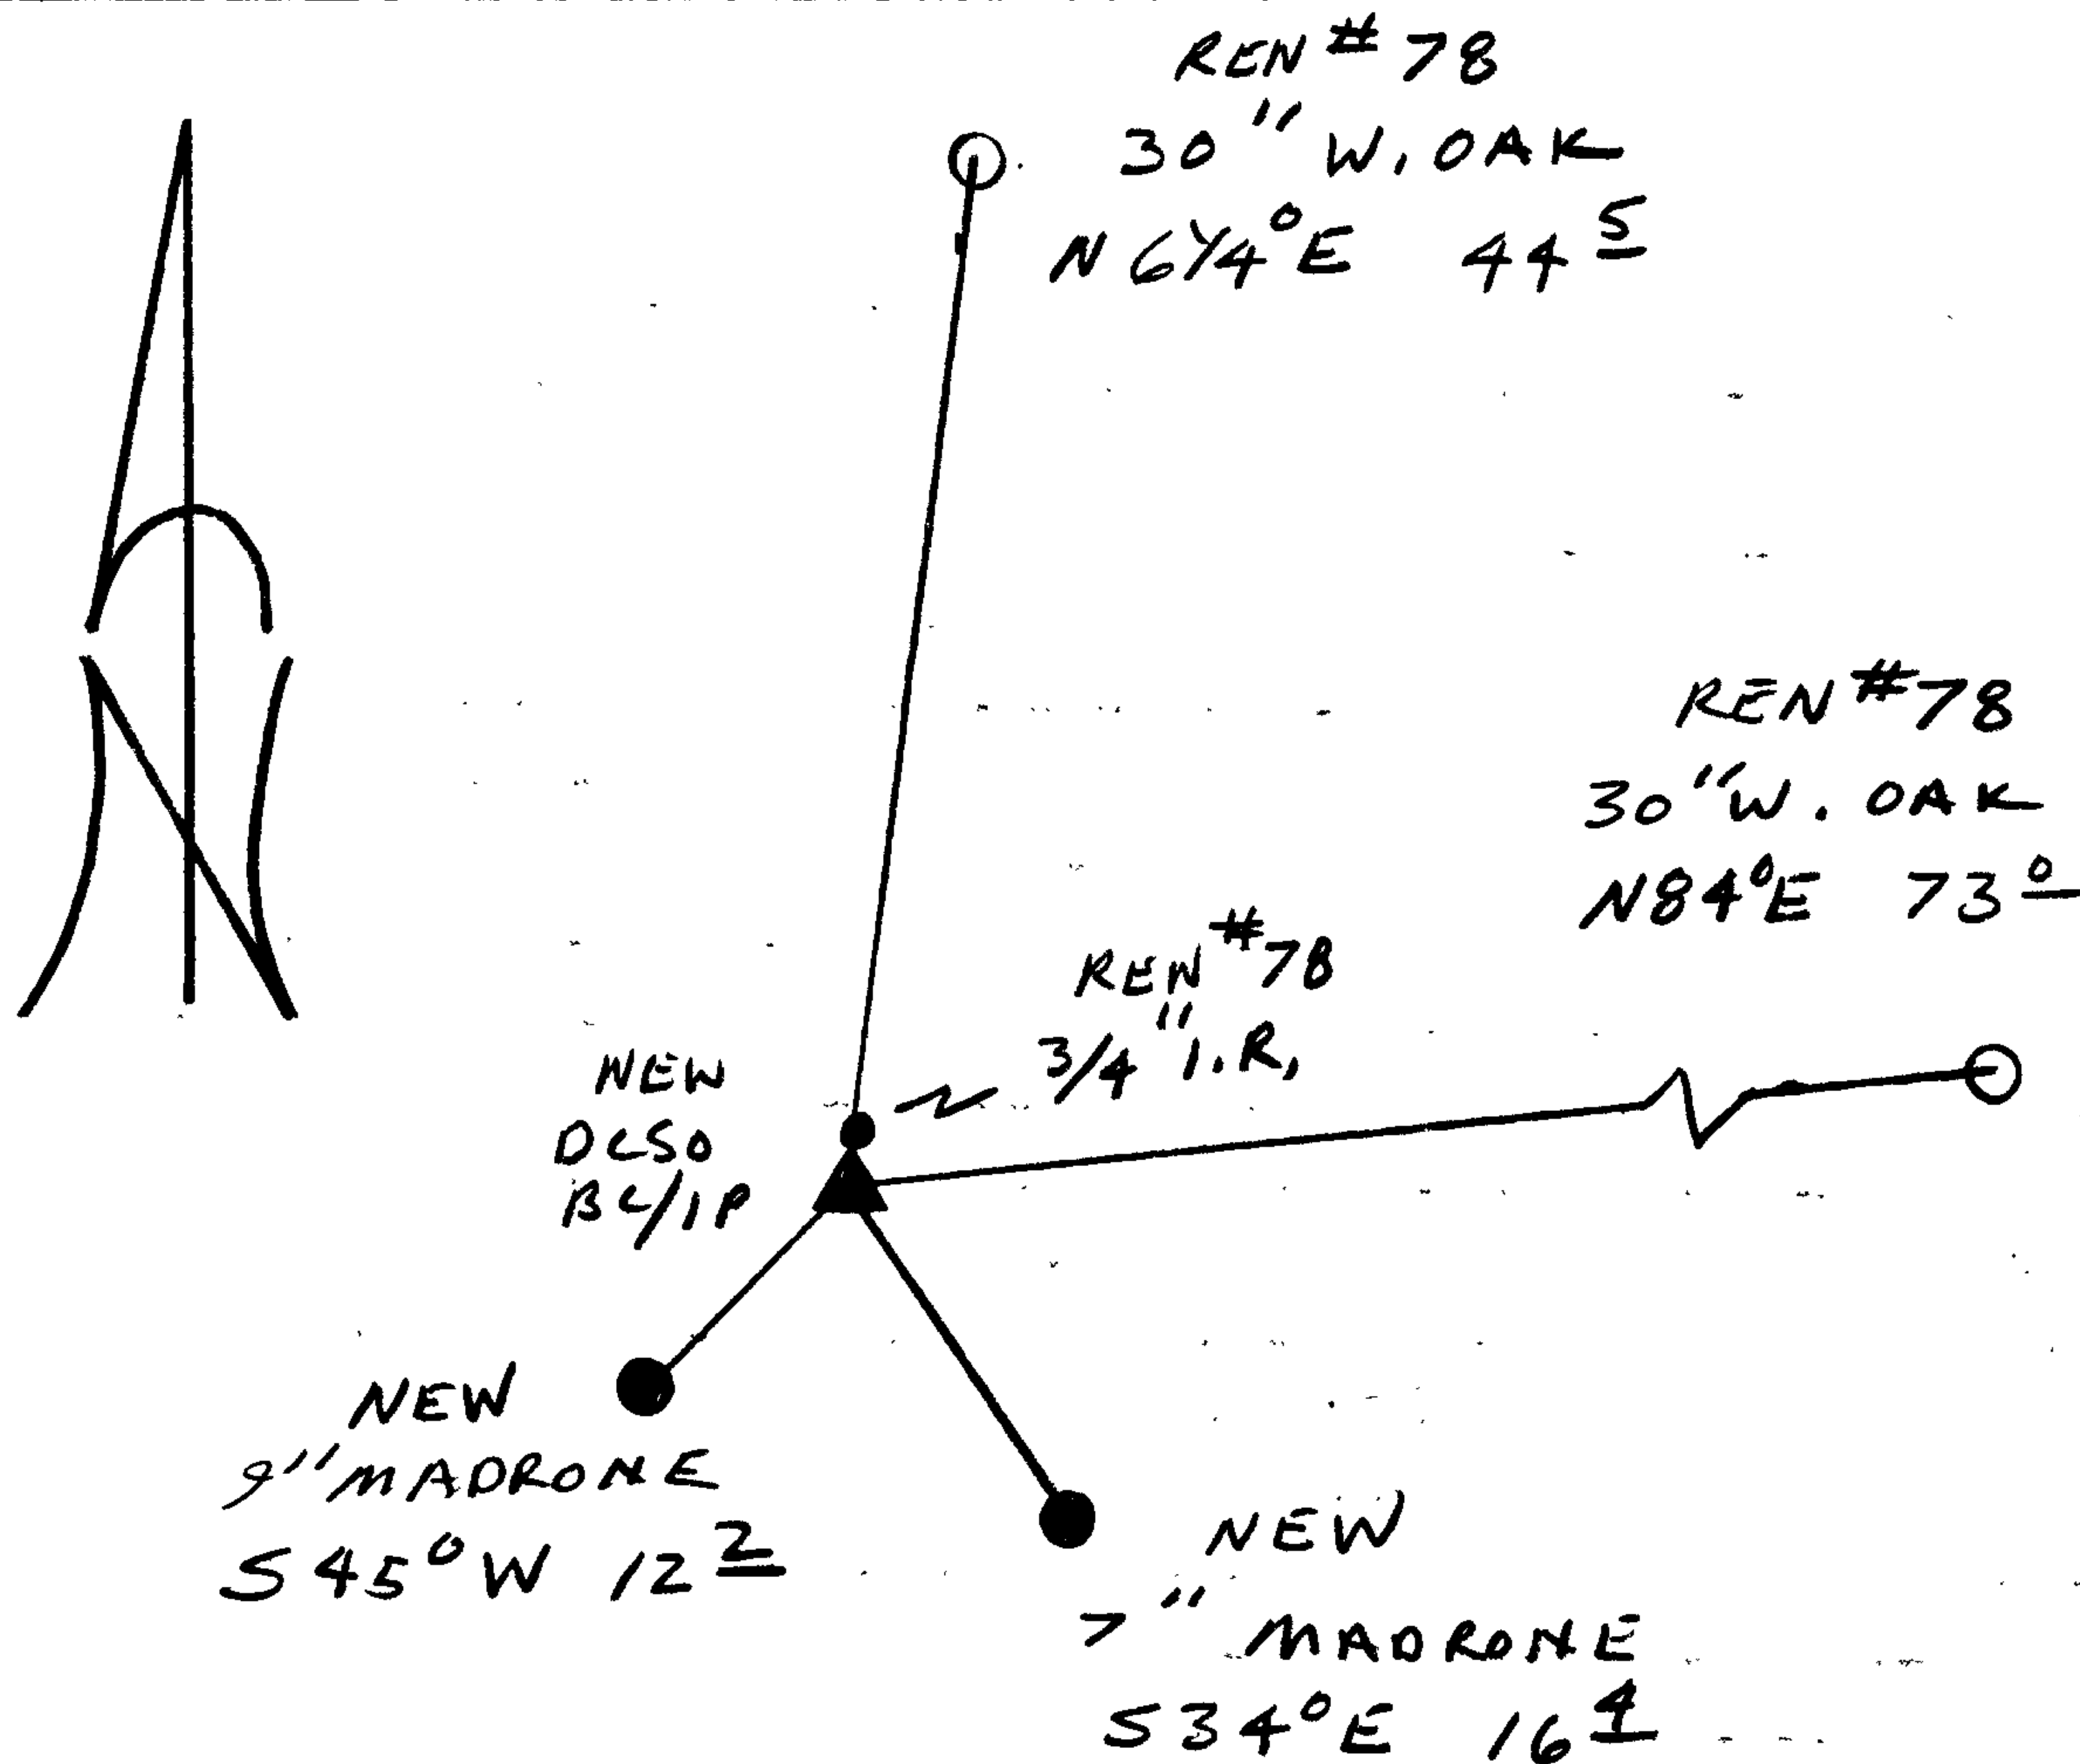

Comp. Declin. 18° E
 Agency DCSO
 Party Chief RANDALL W. SMITH
 Notekeeper Randall W. Smith
 Witnesses FERRIE FRANSSSEN

Address _____

Surveyor's Seal

REGISTERED
 PROFESSIONAL
 LAND SURVEYOR.

Randall W. Smith

OREGON
 JULY 25, 1990
 RANDALL W. SMITH
 2469