

GOVERNMENT CORNER RESTORATION FORM

FILED

Township 30 S Range 6 W Sec. 18 County DOUGLAS

State OR Date 5/3/91 No. _____

MAY 8 1991

Corner Designation

S13 | S18
S24 | S19

COUNTY SURVEYOR
DOUGLAS COUNTY, OREGON

- ____ Condition Report Only
- ____ Not Found
- Renewed
- ____ Unrecorded
- ____ Surveyed In
- ____ Referenced Out

MONUMENT DETAIL

Previous Renewals ~~#130~~ ^{T30-7} ~~#130~~ ^{T30-6} 1973 BLM D. RESERVE)

Monument(s) Found: (Condition and Source)

A 3/4" DIA. BLM BRASS CAP ON A
2 1/4" O.D. IRON PIPE PROTRUDING
12" ABOVE GROUND (1973 BLM)

U.S. DEPT. OF THE INTERIOR

T30 S
R7W R6W
S13 | S18
S24 | S19

1973

BUR. OF LAND MANAGEMENT

Accessories Found:

- 1 23" NOW 38" DIA. 40 FT HIGH DEAD B. OAK SNAG WITH AN OPENED BLAZE
SCRIBE MARKS "S" VISIBLE, BEARS N 76° E, 48.0 FT
(REC N 70° E, 46.2 FT) ORIG. BT
 - 2 15" NOW 36" DIA. 12" HIGH B. OAK STUMP WITH POSSIBLE LOWER
BLAZE, BEARS S 47° E, 79.6 FT (REC. S 50° E 80.5 FT
DISTANCE IS A SLOPE MEASUREMENT) ORIG. BT
WITH AN
 - 3 24" NOW 48" DIA 4 FT HIGH B. OAK STUMP ✓ OPEN ROTTED BLAZE
BEARS S 62° W 715.8 FT (REC S 60° W 215.8 FT) ORIG. BT.
 - 4 25" NOW 26" DIA. PONDEROSA PINE WITH PARTIALLY HEALED
DOUBLE BLAZE ILLEGIBLE SCRIBING VISIBLE, BEARS N 51° W,
3.6 FT (AGREES WITH REC) REN #130
 - 5 20" NOW 19" DIA 17 FT HIGH PONDEROSA PINE SNAG WITH
PARTIALLY HEALED DOUBLE BLAZE ILLEGIBLE SCRIBE MARKS
VISIBLE BEARS S 29 1/2° W, 55.8 FT (REC S 28° W, 58.0 FT
DIST. IS A SLOPE MEASUREMENT) REN #130
- NE BT FROM REN #130 IS GONE

~~#250 T30-6~~
~~#130 T30-7~~

CS 64/15-1C

RENEWAL

Monument Set (Procedure and Description)

Monument Detail

NONE

N/A

New Accessories


5" DIA. D. FIR DOUBLE BLAZED AND SCRIBED "T30SR7WS24CS BT"
BEARS S45 1/2° W, 11.7 FT.

5" DIA. D. FIR DOUBLE BLAZED AND SCRIBED "T30SR6WS18CS BT"
BEARS N40° E, 9.0 FT.

5" DIA. D. FIR DOUBLE BLAZED AND SCRIBED "T30SR6WS19CS BT"
BEARS S66 1/2° E, 52.2 FT.

Sketch of Monument, Accessories, and General Area

Location & Comments

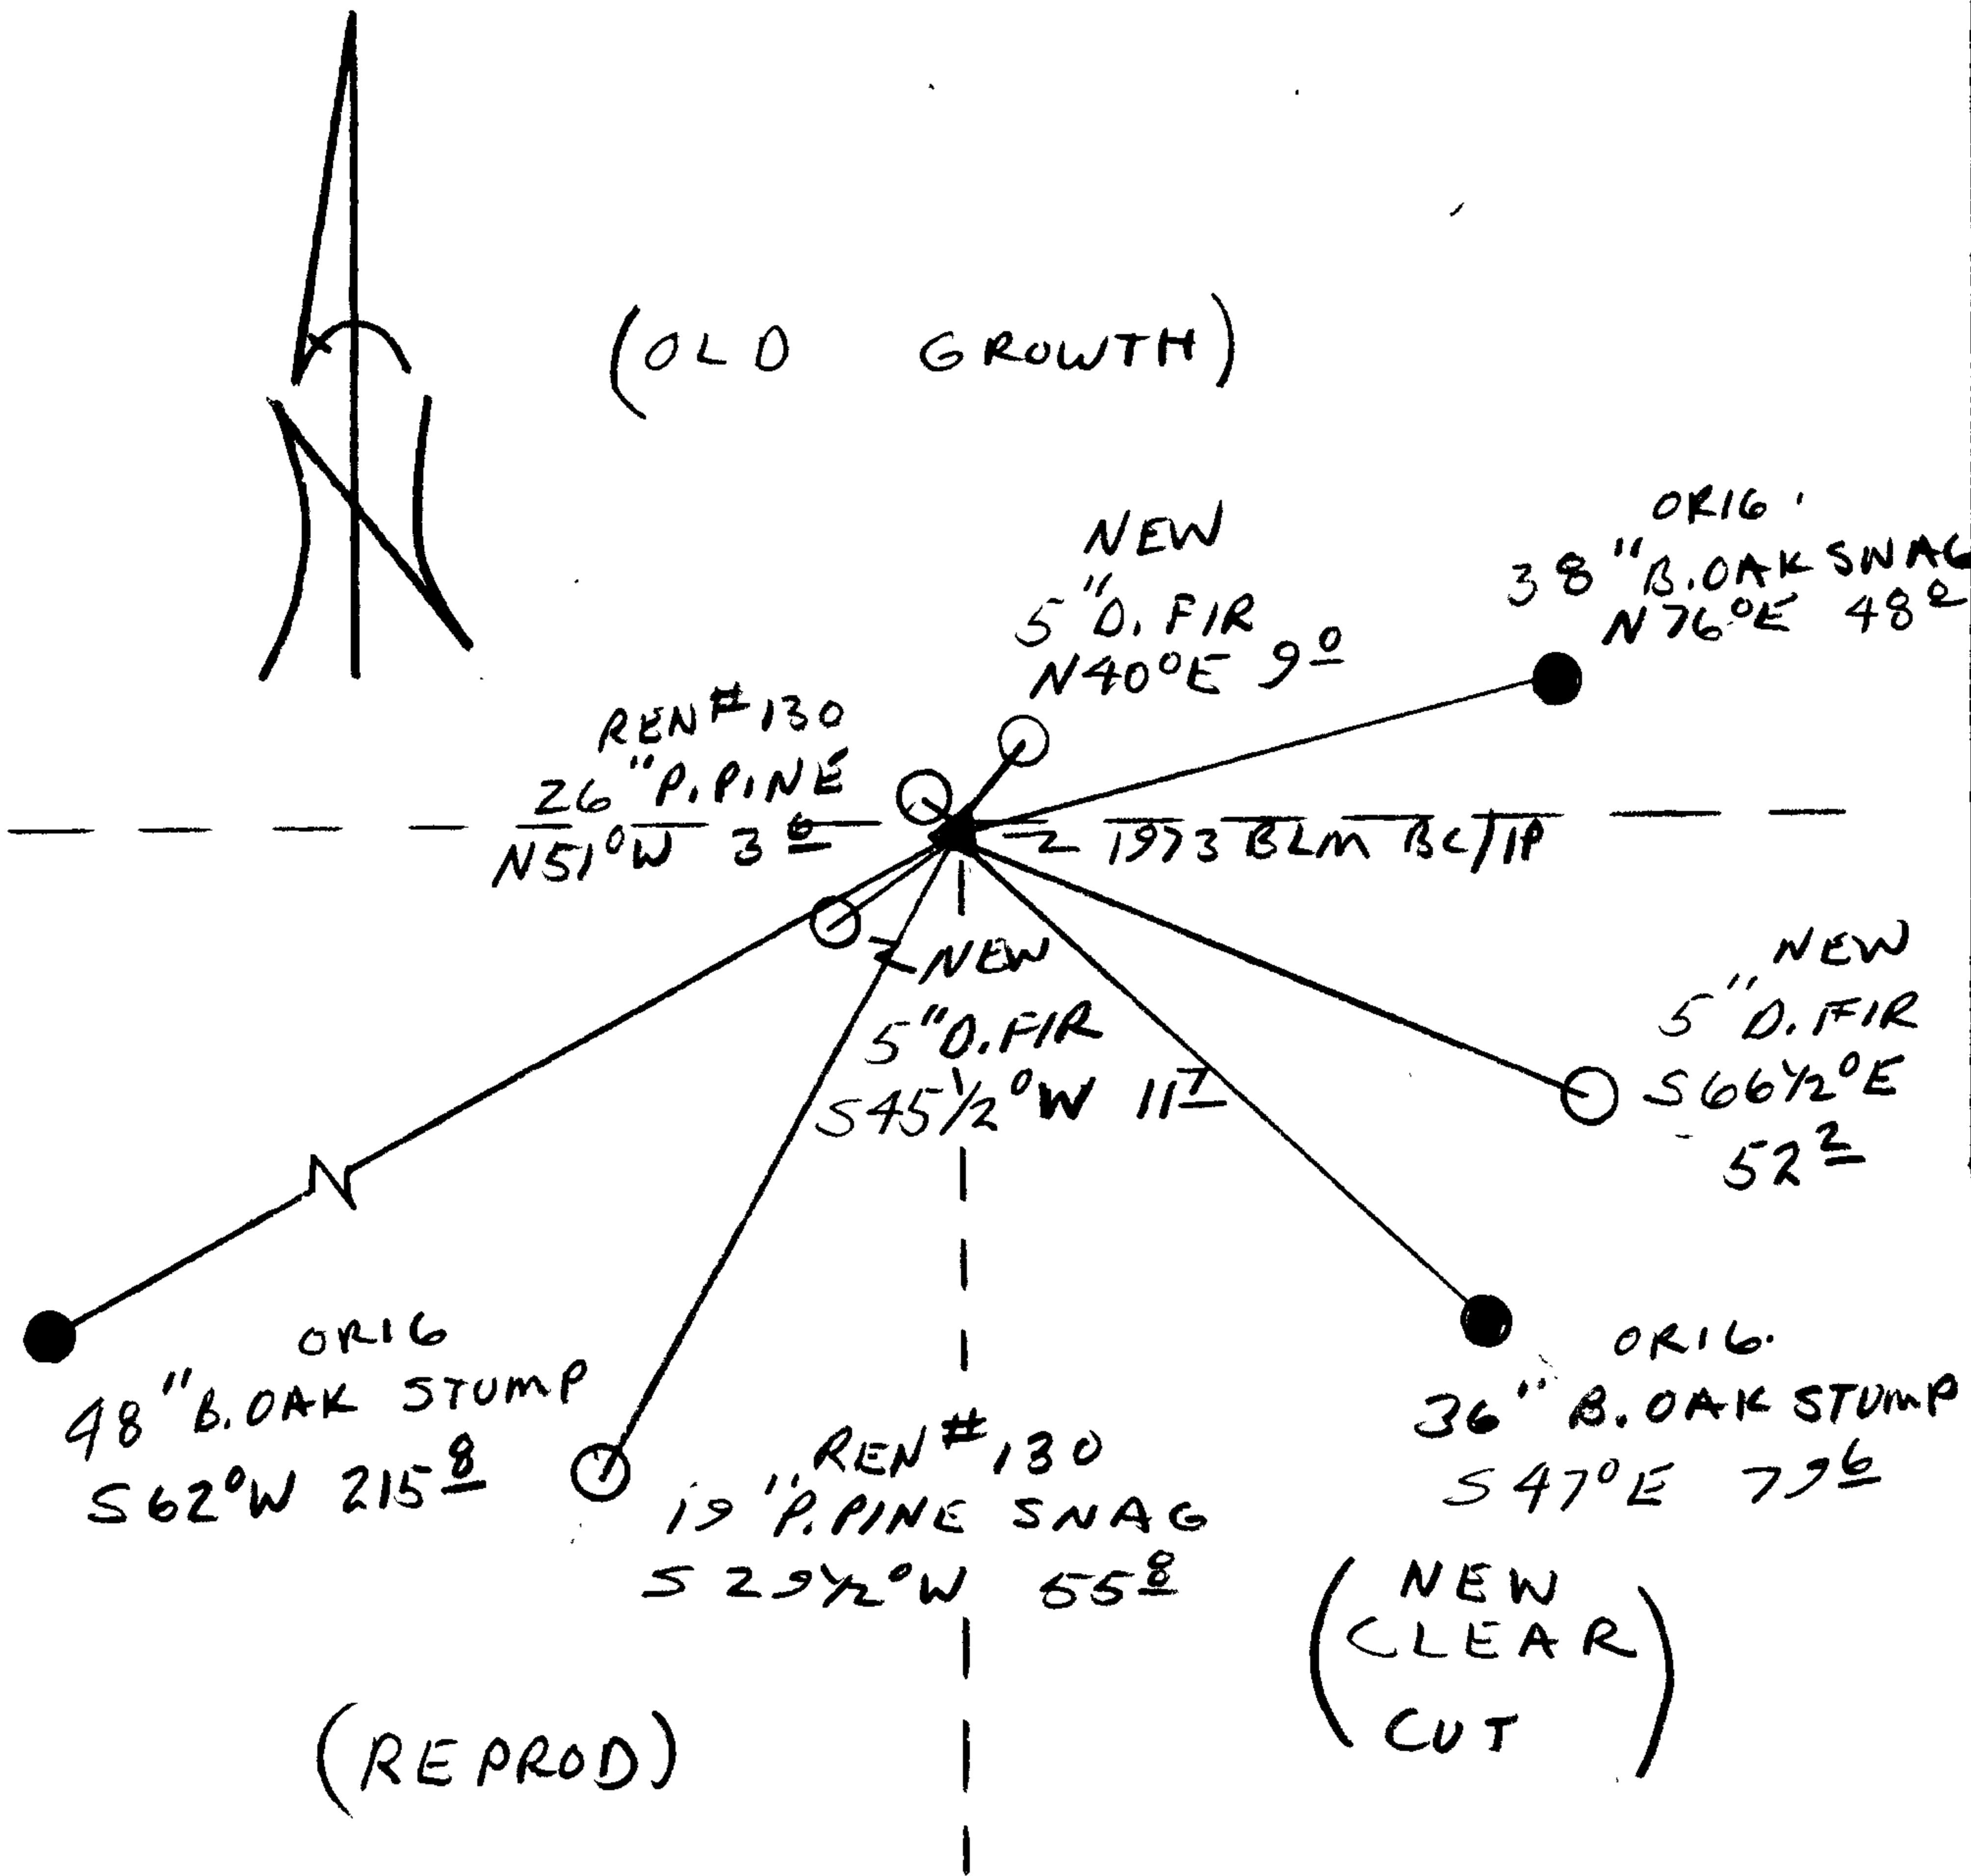

Comp. Declin. 18° E
 Agency DCSO
 Party Chief RANDALL W SMITH
 Notekeeper Randall W Smith
 Witnesses STEPHEN J FLAUSE
HILARY SIMMONS
JOHN PIKE

Address

REGISTERED **Surveyor's Seal**
PROFESSIONAL
LAND SURVEYOR
Randall W Smith
 OREGON
 JULY 25, 1990
RANDALL W. SMITH
 2469