

GOVERNMENT CORNER RESTORATION FORM

FILED

Township 30S Range 6W Sec. 19 County DOUGLAS

State OREGON Date MAY 6, 1991 No. \_\_\_\_\_

*[Signature]*  
MAY 31 1991

Corner Designation

T30S  
R7W R6W  
S24/S19  
S25/S30

COUNTY SURVEYOR  
DOUGLAS COUNTY, OREGON

- Condition Report Only
- Not Found
- Renewed
- Unrecorded
- Surveyed In
- Referenced Out

Previous Renewals 5, 154, 1973 DEPENDENT RESURVEY

Monument(s) Found: (Condition and Source)

FOUND AS DESCRIBED IN 1973 DEPENDENT RESURVEY

Accessories Found:

FOUND AS DESCRIBED IN 1973 DEPENDENT RESURVEY

MONUMENT DETAIL

*[Handwritten mark]*

RENEWAL

Monument Set (Procedure and Description)

Monument Detail

NA

New Accessories

NA


Sketch of Monument, Accessories, and General Area

Location & Comments

Comp. Declin. 18°E  
Agency DCSO  
Party Chief SJ FLAUSE  
Notekeeper Stephen J. Flause  
Witnesses T.R. FRANNSEN

Address

**Surveyor's Seal**

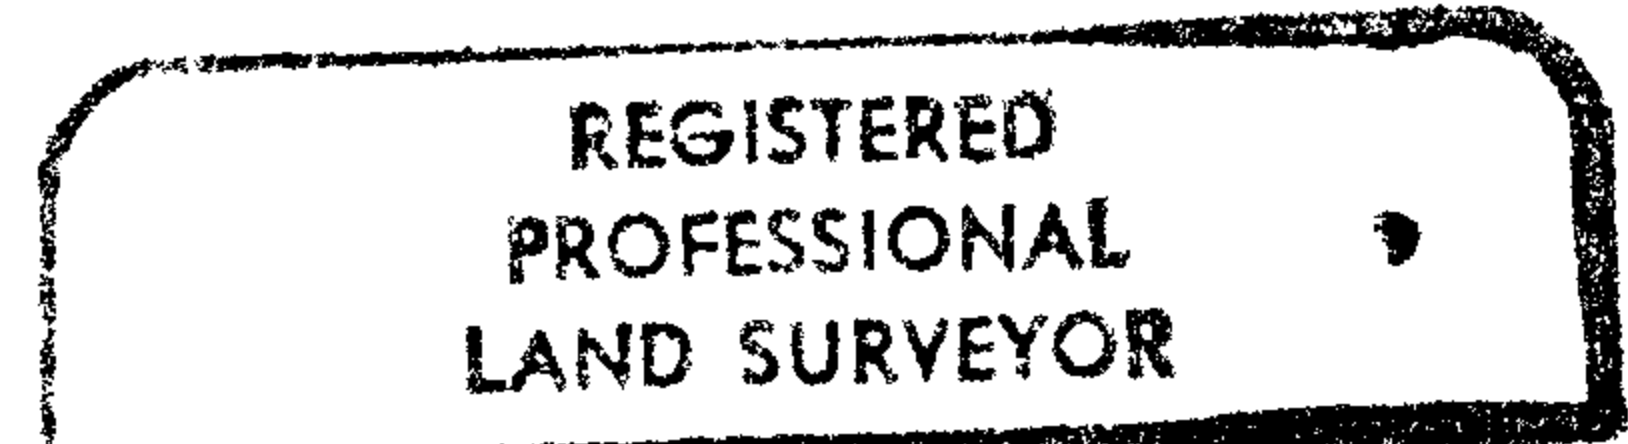

*Larry E. Monrean*

