

GOVERNMENT CORNER RESTORATION FORM

FILED

JH

Township 255 Range 6W Sec. 33 County DOUGLAS

SEP 13 1991

State OR Date 9/4/91 No. _____

Corner Designation

COUNTY SURVEYOR
DOUGLAS COUNTY, ORE.

1/4 S 33
54

- Condition Report Only
- Not Found
- Renewed
- Unrecorded
- Surveyed In
- Referenced Out

Previous Renewals ⁷⁰⁰³⁴⁰ # 133 ^{T25-6} # 340700 T26-6

MONUMENT DETAIL

Monument(s) Found: (Condition and Source)

A 2 1/2" DIA. OLDSO BRASS CAP
ON A 1 1/4" O.D. IRON PIPE,
PROTRUDING 9" ABOVE GROUND.
(REN # 133)

COUNTY SURVEYORS OFFICE

T255
1/4 S 33 R
54 W
T265
1963

Accessories Found:

- 20" NOW ROOT HOLE, A FALLEN ROTTED 20" DIA. OAK;
HAS AN OPEN ROTTED BLAZE (ILLEGIBLE) SCRIBING VISIBLE,
ROOT HOLE BEARS S20°W 16 FT (AGREES WITH REC.) ORIG. BT
- 29" NOW ROOT HOLE, A FALLEN OUT OF POSITION 26" DIA. ROTTED
OAK HAS A PREVIOUSLY OPENED ROTTED BLAZE NO SCRIBING
VISIBLE, ROOT HOLE BEARS N27°W, 17.8 FT (AGREES WITH REC.)
ORIG. BT
- 14" NOW 24" DIA. 1 FT HIGH D. FIR STUMP WITH A
HEALED LOWER BLAZE, BEARS S70°W, 23.3 FT
(AGREES WITH REC.) REN # 133
- 16" NOW 20" DIA. 2 1/2 FT HIGH D. FIR STUMP WITH
A PARTIALLY HEALED BLAZE, NO SCRIBING VISIBLE,
BEARS N55°W, 14.4 FT (AGREES WITH REC.) REN # 133

T26-6
340700
340100
T25-6

Monument Set (Procedure and Description)

Monument Detail

NONE

N/A

New Accessories


- 7" DIA. D. FIR DOUBLE BLAZED AND SCRIBED "1/4 S 33 CS BT"
BEARS N 72 1/2° E, 27.3 FT.
- 6" DIA. D. FIR DOUBLE BLAZED AND SCRIBED "1/4 S 33 CS BT"
BEARS N 80° W, 43.0 FT
- 6" DIA. W. OAK DOUBLE BLAZED AND SCRIBED "1/4 S 4 CS BT"
BEARS S 80° W, 72.9 FT.
- 8" DIA. D. FIR DOUBLE BLAZED AND SCRIBED "1/4 S 4 CS BT"
BEARS S 29 1/2° E, 74.3 FT

Sketch of Monument, Accessories, and General Area

Location & Comments

SECOND GROWTH D. FIRS

CORNER LIES 150' EAST OF A N-S RUNNING RIDGE AND 1 FT SOUTH OF A E-W FENCE LINE

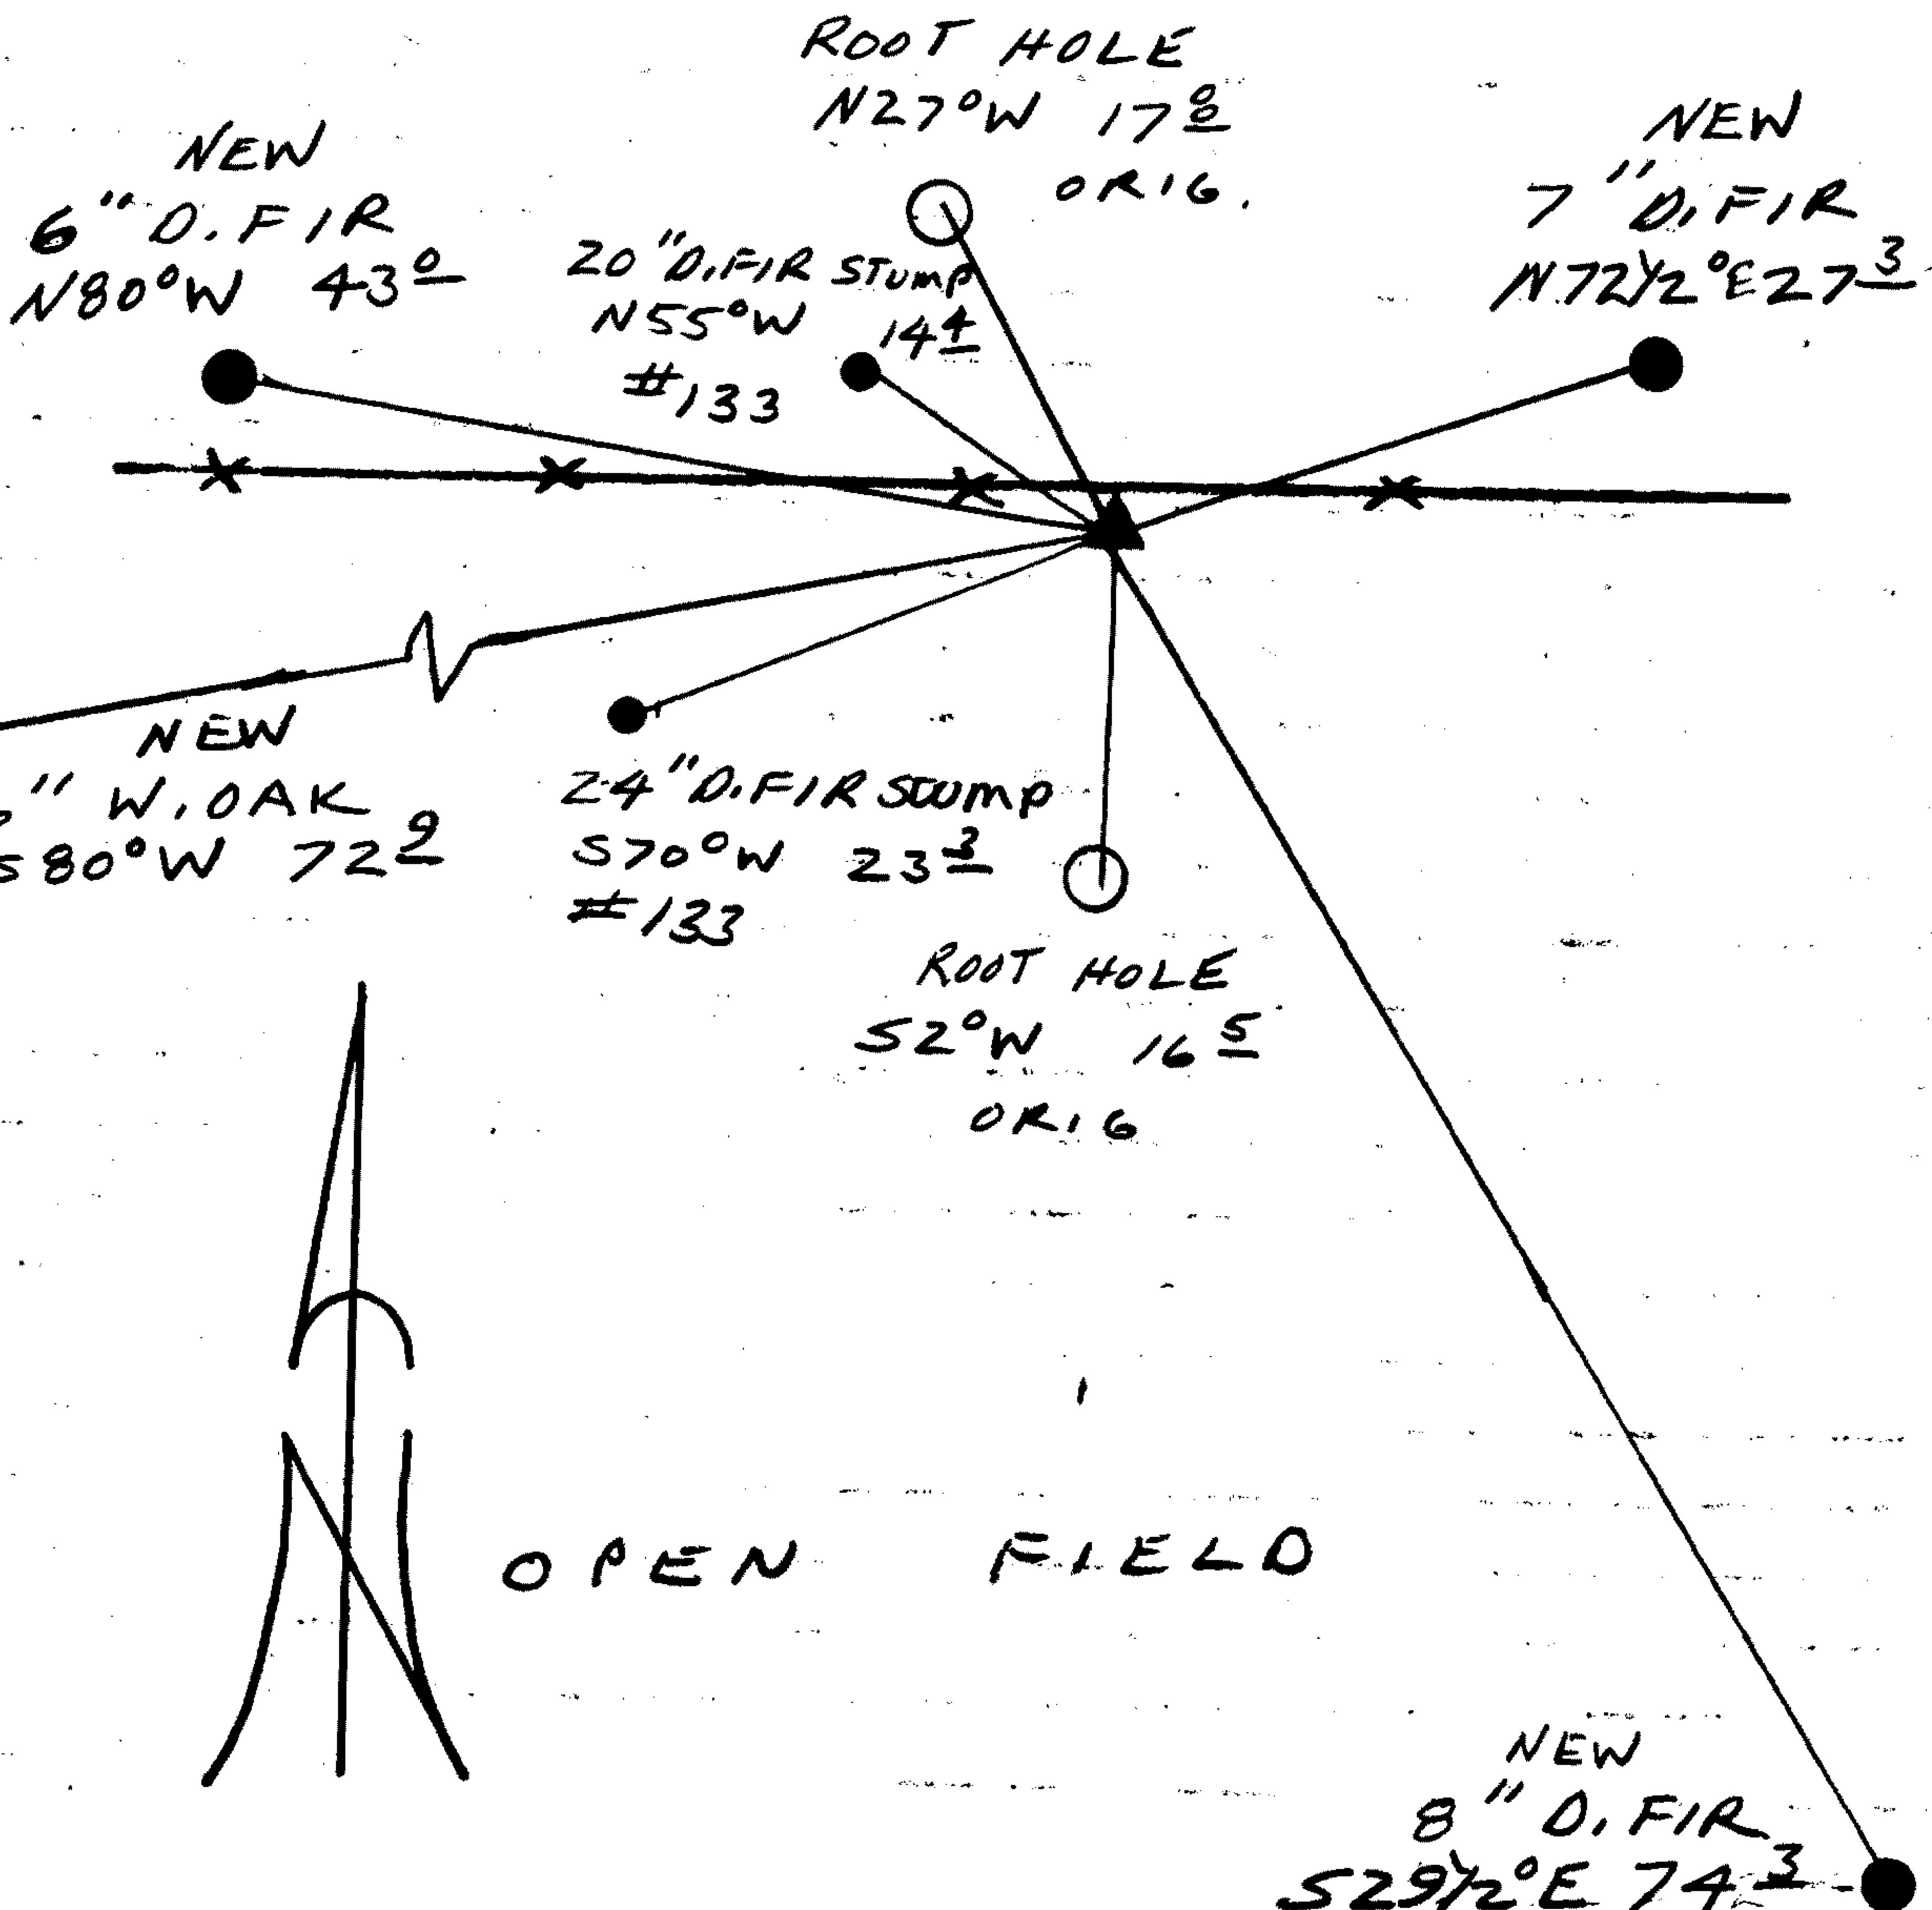

Comp. Declin. 18° E
 Agency DCSO
 Party Chief RANDALL W SMITH
 Notekeeper Randall W Smith
 Witnesses STEPHEN J. FLAUSÉ

Address

Surveyor's Seal
 REGISTERED
 PROFESSIONAL
 LAND SURVEYOR

Randall W Smith

OREGON
 JULY 25, 1980
 RANDALL W. SMITH
 1980