

JK

Township 215 Range 4W Sec. 25 County DOUGLAS

NOV 19 1991

State OREGON Date 11/13/91 No. _____

COUNTY SURVEYOR
DOUGLAS COUNTY, ORE

Corner Designation

526	525
535	536

- Condition Report Only
- Not Found
- Renewed
- Unrecorded
- Surveyed In
- Referenced Out

Previous Renewals * 26, BLM DEPENDENT RESURVEY 1958

MONUMENT DETAIL

Monument(s) Found: (Condition and Source)

NO EVIDENCE OF ORIGINAL OR RENEWAL #26 MONUMENTS FOUND FROM 1958 BLM DEPENDENT RESURVEY A 3/4 INCH DIAMETER BRASS CAP (MARKED AS AT RIGHT) ON A 2 1/2 INCH O.D. IRON PIPE FIRMLY SET AND PROTRUDING 6 INCHES ABOVE GROUND.

U.S. CADASTRAL SURVEY

T 215 R 4W

526	525
535	536

1958

BUREAU OF LAND MANAGEMENT

Accessories Found:

NO EVIDENCE OF ORIGINAL BEARING TREES FOUND.

BEARING TREES FROM RENEWAL # 26 EVIDENT BUT NOT CHECKED (BLM DID NOT ACCEPT G.A. GARDNERS CORNER POSITION).

FOUR BEARING TREES FROM 1958 BLM DEPENDENT RESURVEY FOUND.
A FIR, 8 INS. DIAM NOW A 15 INCH D.B.H., 6 FOOT TALL FIR STUMP WITH A FULLY HEALED SINGLE BLAZE BEARS N 32° E, 28 1/4 FEET DISTANT (RECORD N 32° E, 31 1/2 FT. (POSSIBLE ERROR IN RECORD LINKS MEAS.))
A FIR, 14 INS. DIAM. NOW 22 INCH D.B.H., 5 FOOT TALL FIR STUMP WITH A FULLY HEALED SINGLE BLAZE BEARS S 55° E, 31° FEET DISTANT (AS PER RECORD)
A FIR, 10 INS. DIAM. NOW A 16 INCH D.B.H. DOUGLAS FIR WITH A FULLY HEALED SINGLE BLAZE BEARS S 48 1/4° W, 12 1/2 FEET DISTANT (AS PER RECORD)
A FIR, 9 INS. DIAM. NOW A 16 INCH D.B.H., 5 1/2 FOOT TALL FIR STUMP WITH A FULLY HEALED SINGLE BLAZE BEARS N 16 3/4° W, 25 1/2 FEET DISTANT (AS PER RECORD).

#1594

Monument Set (Procedure and Description)

Monument Detail

NA)

NA)

New Accessories


A 13 INCH D.B.H. DOUGLAS FIR SCRIBED T21S, R4W, S36, CS BT ON A DOUBLE BLAZE BEARS S02 1/2° E, 3 1/4 FEET DISTANT.

A 22 INCH D.B.H. DOUGLAS FIR SCRIBED T21S, R4W, S35, CS BT ON A DOUBLE BLAZE BEARS S89° W, 34° FEET DISTANT.

Sketch of Monument, Accessories, and General Area

Location & Comments

CLEARCUT

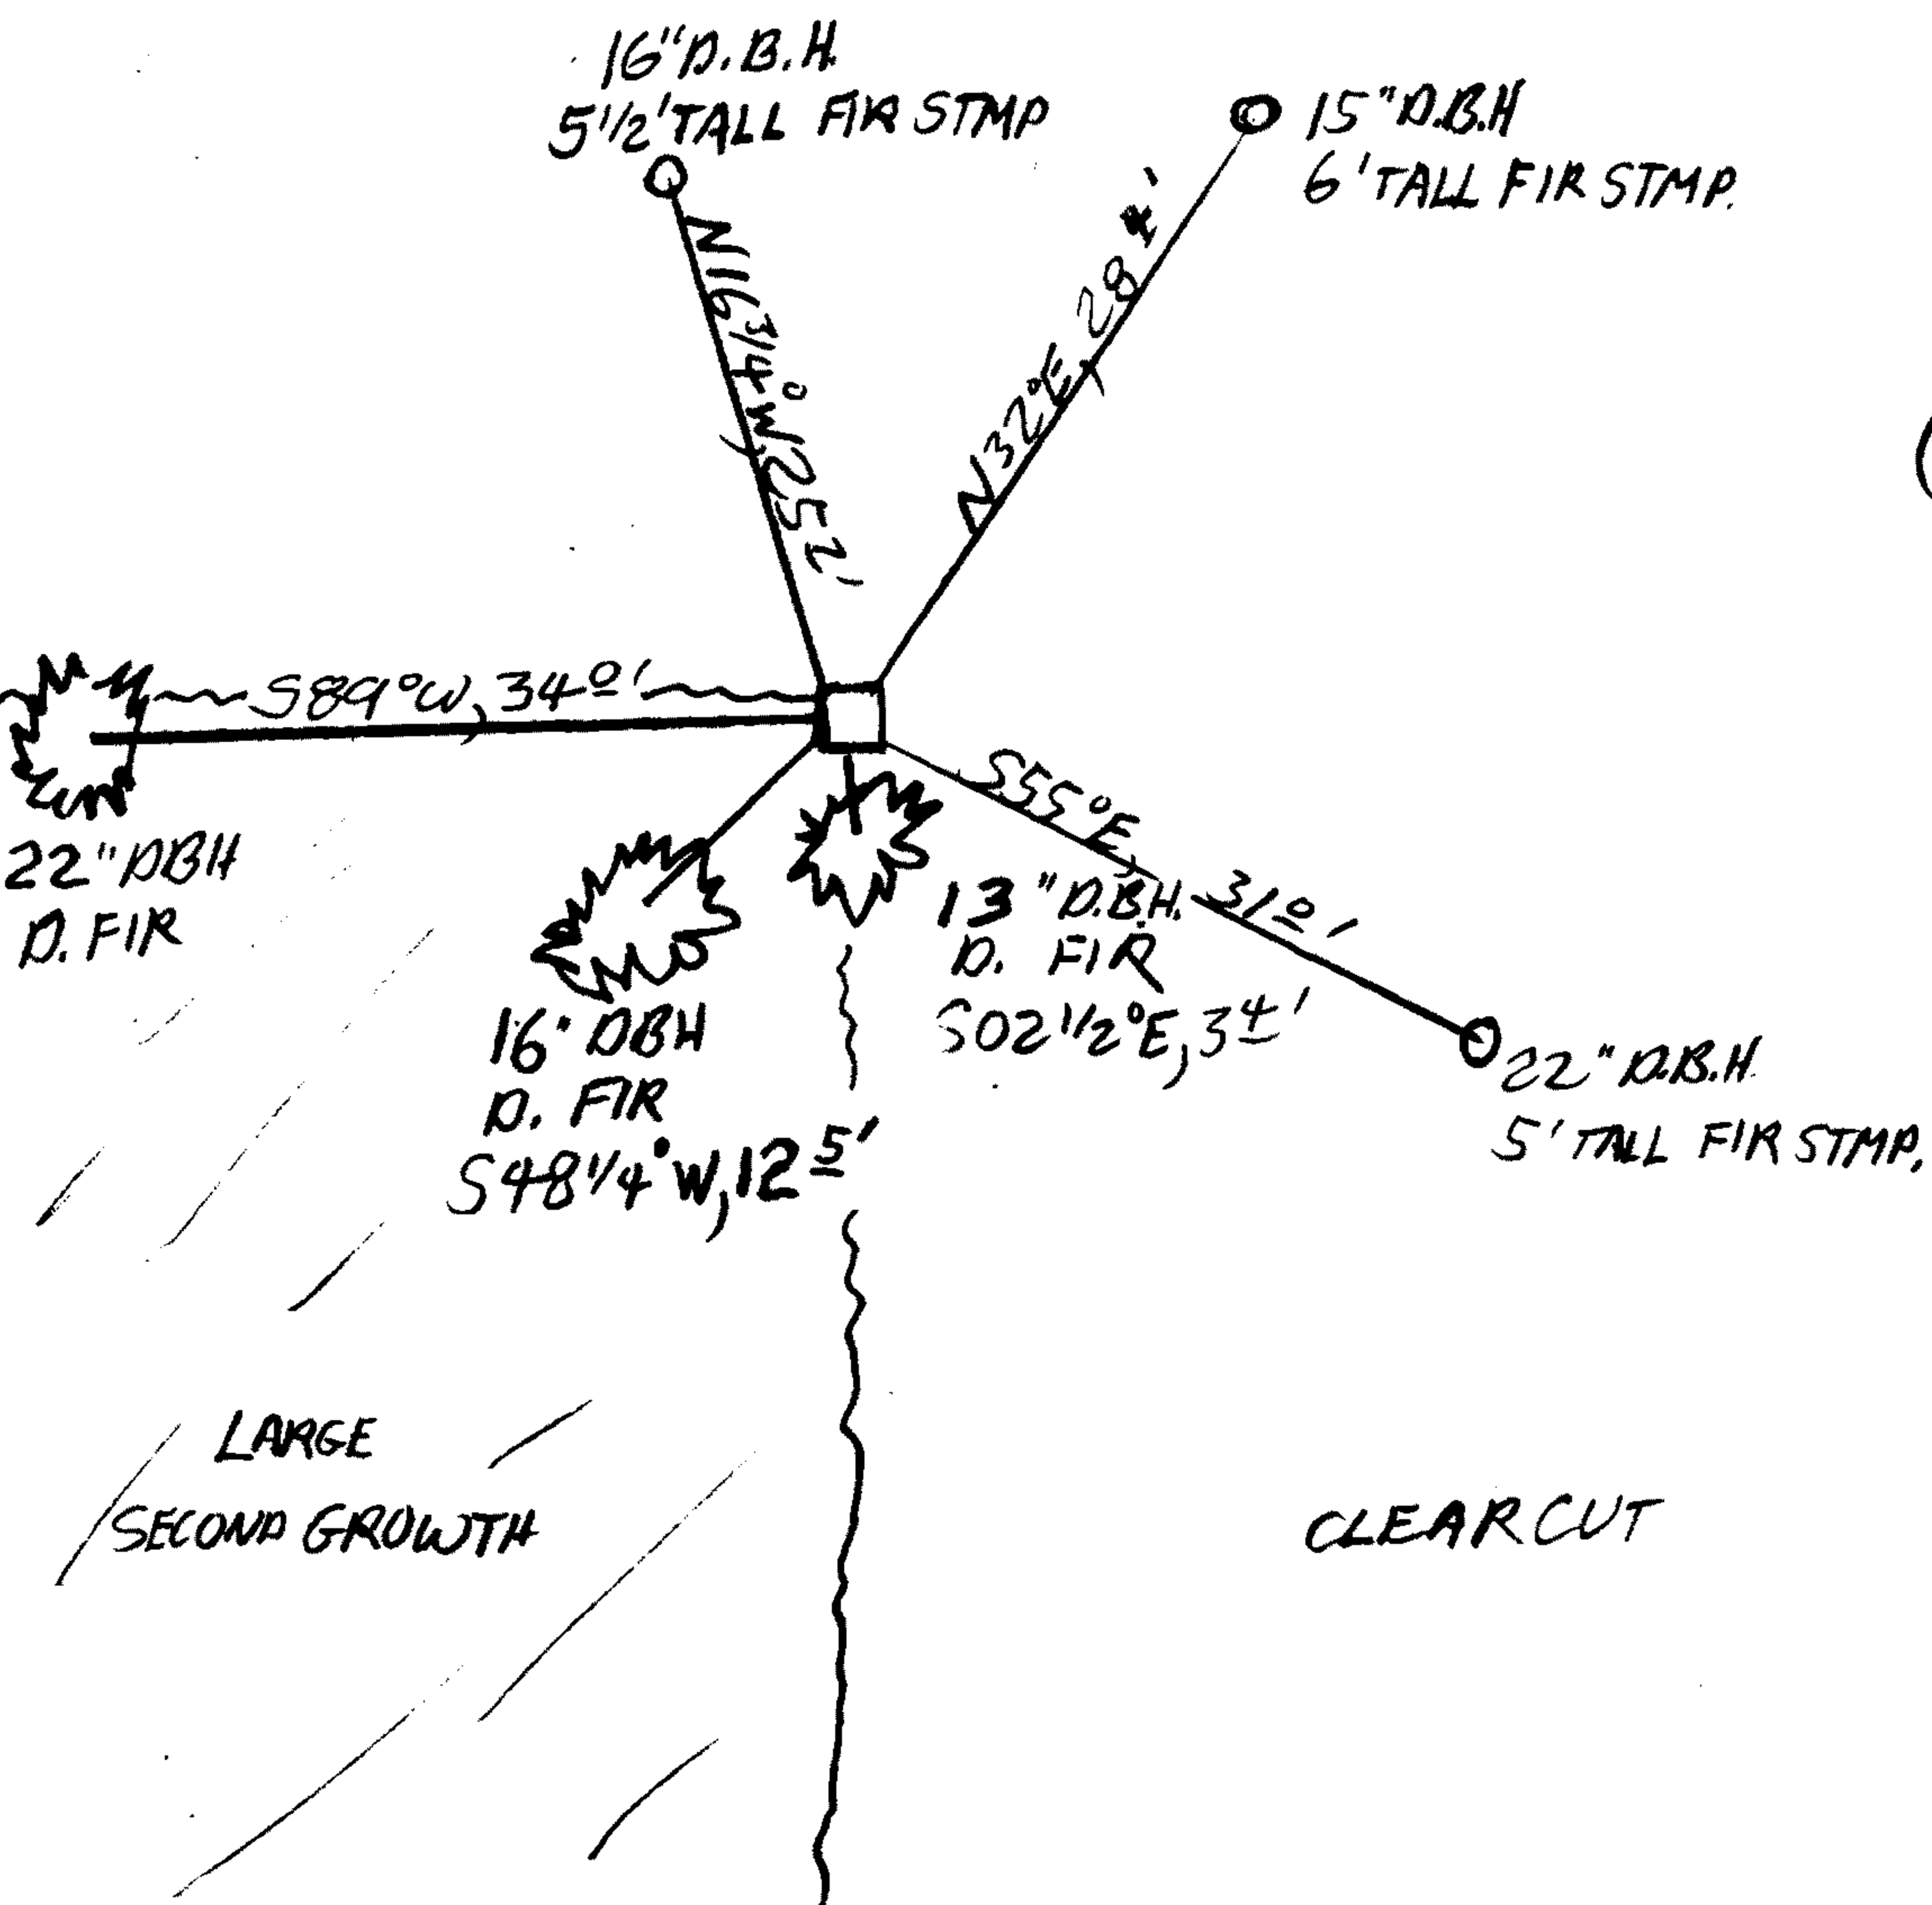

CORNER IS IN LARGE CLEARCUT WITH LARGE SECOND GROWTH TIMBER REMAINING IN SW QUADRANT. CORNER IS APPROX. 100 FT. SOUTHERLY FROM WEYERHAEUSER TIMBER ACCESS ROAD

Comp. Declin. 17 3/4° E
Agency DCSO
Party Chief R.W. SMITH
Notekeeper S.J. FLAUSE
Witnesses Stephen John Flause

Address

Surveyor's Seal

REGISTERED PROFESSIONAL LAND SURVEYOR

Randall W Smith

OREGON
JULY 25, 1990
RANDALL W. SMITH
2469