

FILED

Township 21S Range 5W Sec. 6 County DOUGLAS

State OR Date 11/19/91 No. DEC 4 1991

Corner Designation

S1 | S6
S12 | S7

COUNTY SURVEYOR
DOUGLAS COUNTY
Condition Renewed Only
 Not Found
 Renewed
 Unrecorded
 Surveyed In
 Referenced Out

Previous Renewals *28 *59 ^{T21-5 #34 T21-6} 1962 BLM (SUSPENDED 1991)

MONUMENT DETAIL

Monument(s) Found: (Condition and Source)
2 1/2" DIA. ALSO BRASS CAP 1/4"
OD IRON PIPE PROTRUDES 12" ABOVE
GROUND. (REN#59)

WILFORD N HAINES "T" IRON
MARKED "239" IS FOUND
NORTHWEST OF SCIP 0.5 FT.
PROTRUDES 7" ABOVE GROUND
(REN#28)

OFFICE COUNTY SURVEYORS
T21S
R S1 | S6 R
6 S12 | S7 S
W W

USBLM
1962
1958

Accessories Found:

12" NOW ROTTED TIPPED OUT STUMP OF INDETERMINABLE SIZE
NO SCRIBING VISIBLE, ROOT HOLE BEARS N27°W 9.8 FT
(AGREES WITH REC) ORIG. BT.

28" NOW 30" DIA 4' HIGH D.FIR STUMP WITH A GAL
STEEL CAP ON TOP, A PARTIALLY HEALED SINGLE BLAZE
FACING SOUTHWEST HAS SCRIBE MARKS "BT" VISIBLE,
BEARS S87°E, 10.4 FT (AGREES WITH REC) REN#59

22" NOW 22" DIA 3 1/2' HIGH D.FIR STUMP WITH A GAL STEEL
CAP ON TOP AND A FULLY HEALED SINGLE BLAZE, BEARS S48°E
15.2 FT (AGREES WITH REC) REN#59

14" NOW 20" DIA, 3 1/2' HIGH ROTTED D.FIR STUMP WITH
AN OPEN BLAZE, SCRIBING "S12 BT" VISIBLE, BEARS
S17°W, 19.9 FT (REC S17°W, 21.5 FT). REN#59

40" NOW 40" DIA, 4 1/2 FT HIGH D.FIR STUMP WITH A FULLY HEALED
BLAZE AND A GAL STEEL CAP ON TOP, BEARS S14°E, 32.1 FT
(AGREES WITH REC) 1962 BLM

62" NOW 60" DIA, 3 FT HIGH D.FIR STUMP WITH A FULLY HEALED
BLAZE, AND A GAL STEEL CAP ON TOP, BEARS S45°W, 49.2 FT
(REC S45°W, 47.5 FT DIST TO FACE) 1962 BLM

#179 T21-5 X
#144 T21-6 X

(ON BACK)

C.S. File No. 64/21-7

Monument Set (Procedure and Description)

Monument Detail

NONE

N/A

ACCESSORIES FOUND:

4" NOW 15" DIA. D. FIR WITH A FULLY HEALED SINGLE BLAZE, BEARS N18°W, 31.0 FT (AGREES WITH REC.) 1962 BLM


New Accessories

9" DIA. HEMLOCK DOUBLE BLAZED AND SCRIBED "TZIS R5WS6CSBT" BEARS N66°E, 8.0 FT

8" DIA. D. FIR DOUBLE BLAZED AND SCRIBED "TZIS R6WS12CSBT" BEARS S19 1/2°W, 8.0 FT

12" DIA. HEMLOCK DOUBLE BLAZED AND SCRIBED "TZIS R5WS7CSBT" BEARS S47 1/2°E, 29.6 FT

Sketch of Monument, Accessories, and General Area

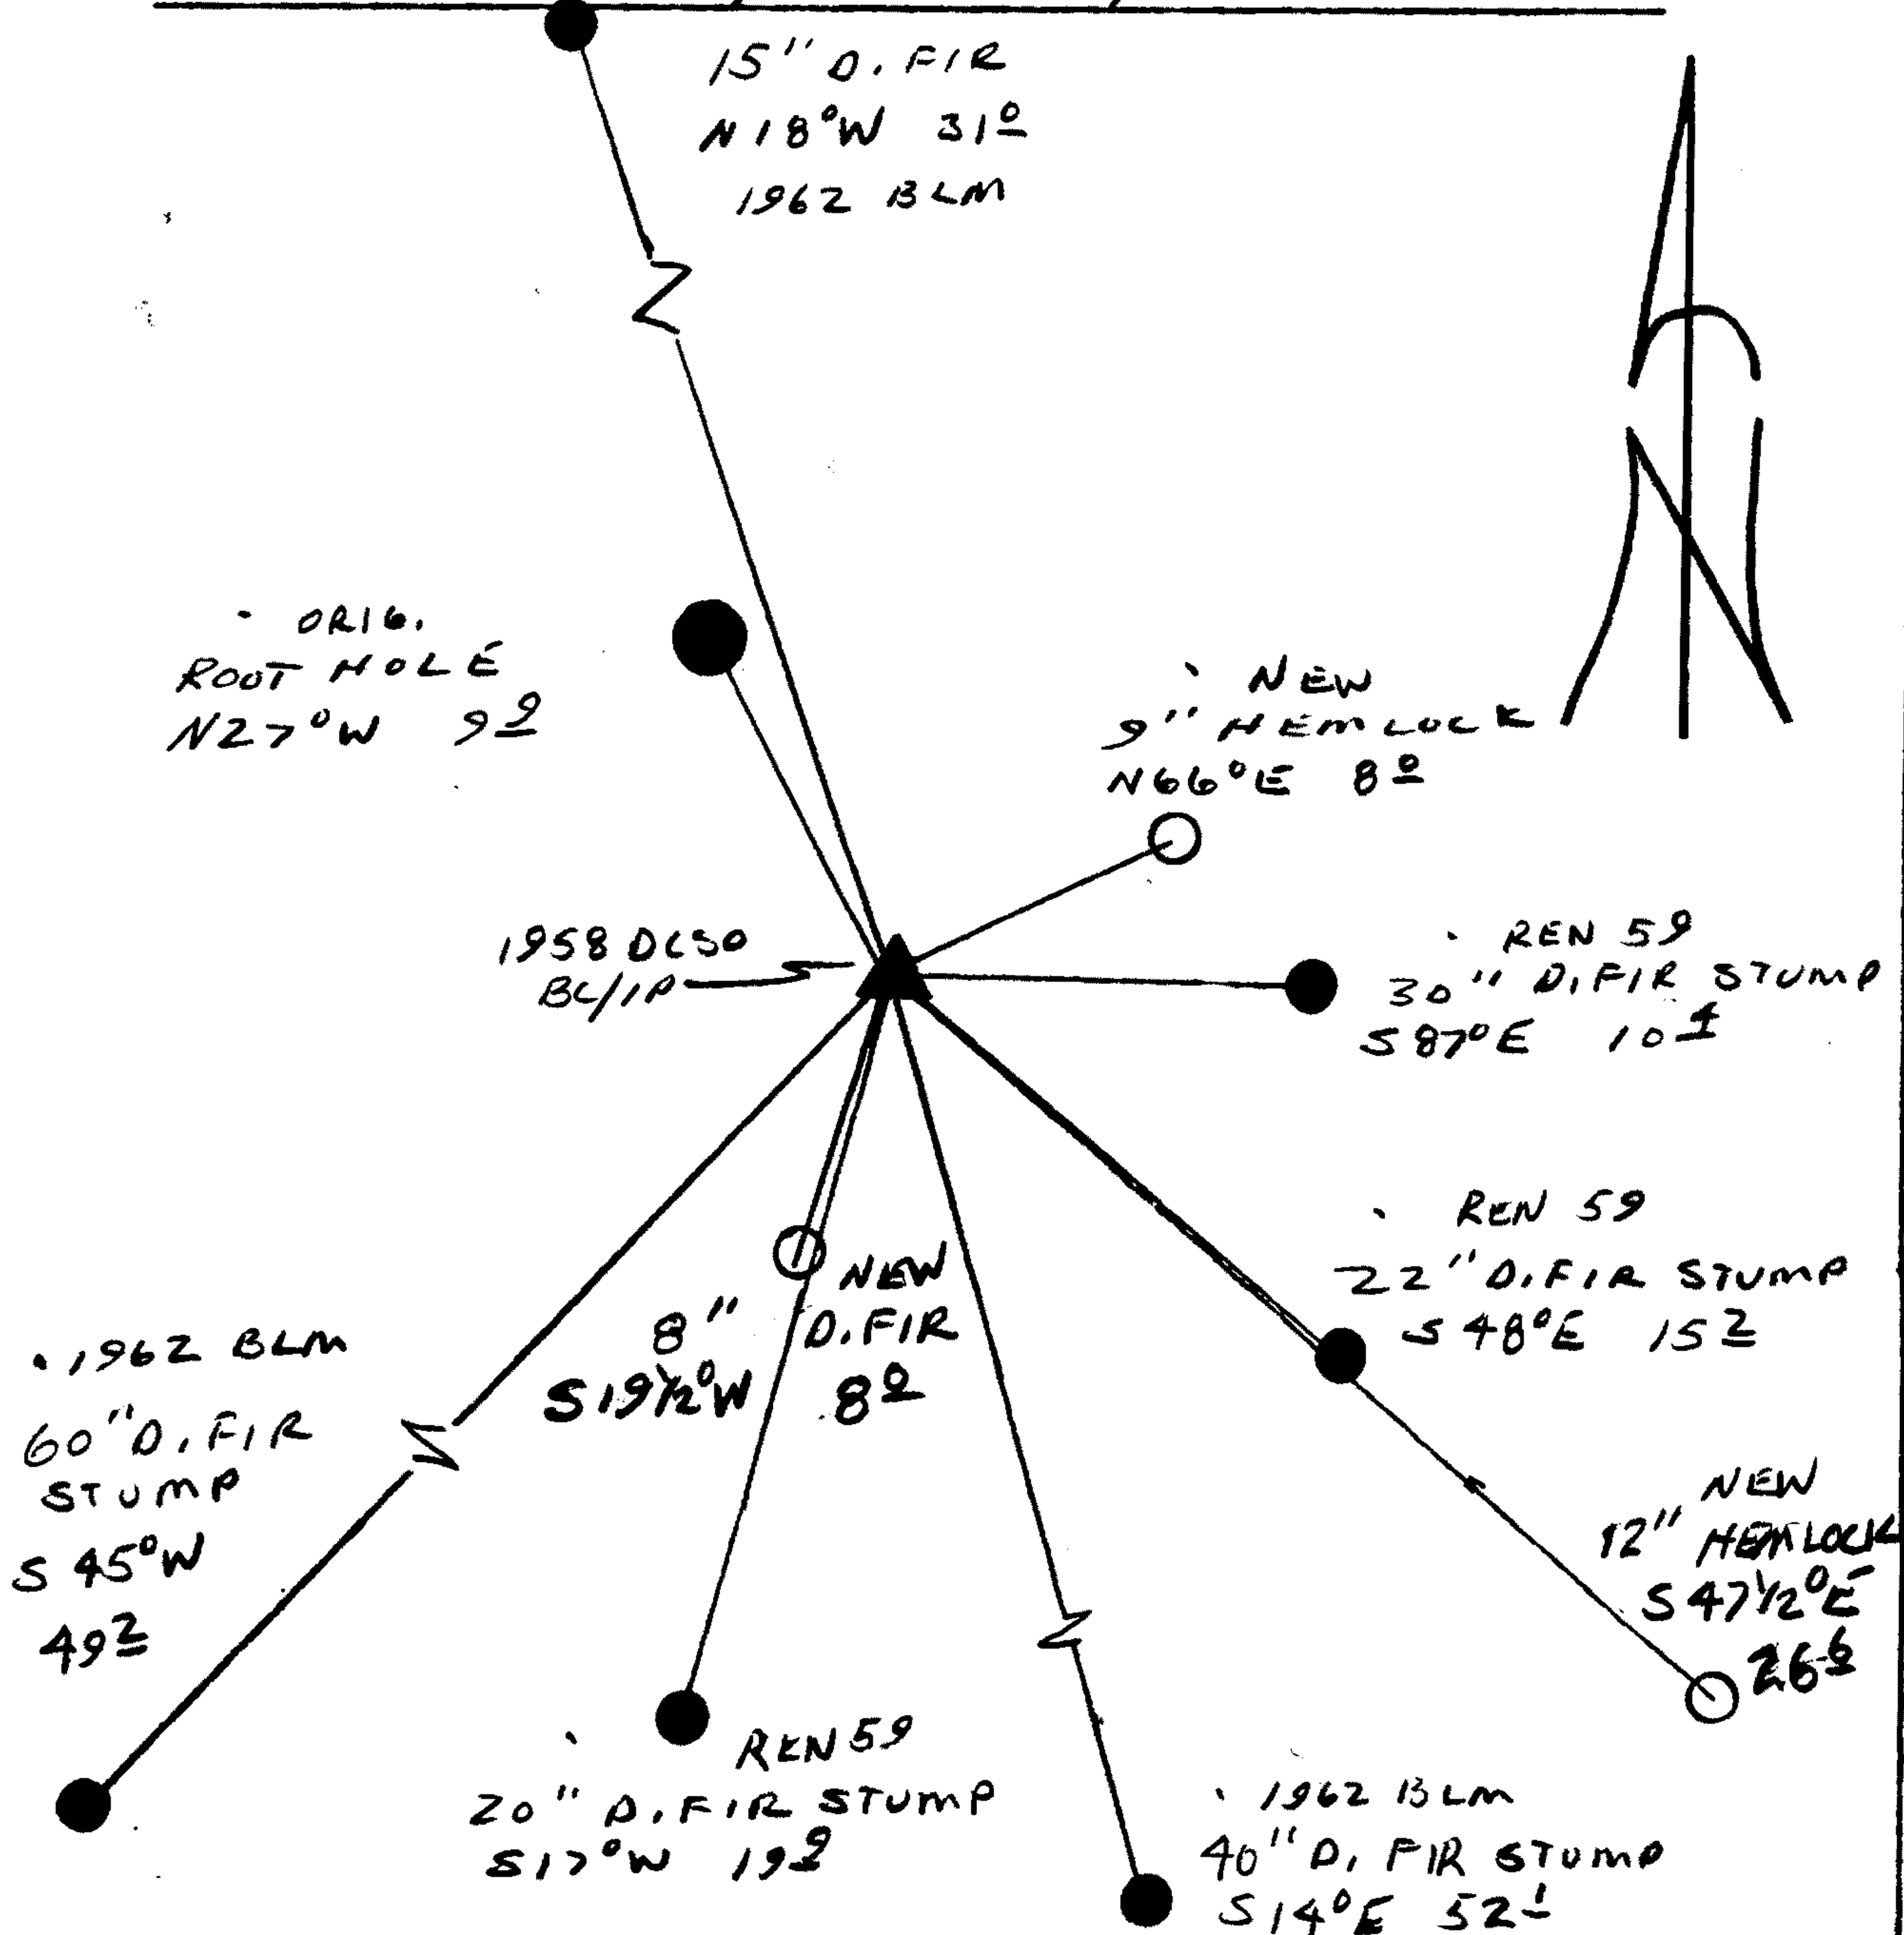

Location & Comments

Comp. Declin. 18°E
 Agency DCSO
 Party Chief RANDALL W SMITH
 Notekeeper Randall W Smith
 Witnesses STEPHEN J FLAUSE

Address

Surveyor's Seal

REGISTERED PROFESSIONAL LAND SURVEYOR

Randall W Smith

OREGON
 JULY 25, 1990
 RANDALL W. SMITH
 2469