

Township 22S Range 4W Sec. 26 County DOUGLAS

State OR Date 11/14/91 No. _____

DEC 4 1991

Corner Designation

C 1/4 S26

COUNTY SURVEYOR
DOUGLAS COUNTY, ORE.

- Condition Report Only
- Not Found
- Renewed
- Unrecorded
- Surveyed In
- Referenced Out

Previous Renewals #41

Monument(s) Found: (Condition and Source)

1/2" I.P. WITH PLASTIC CAP MARKED
"WEYER CO." PROTRUDES 12" ABOVE
A 2' BY 4' LONG MOUND OF STONE.
(REN #141)

3/4" I.D. BY 35" LONG IRON PIPE
FOUND LOOSE IN GROUND, PROTRUDING
2 FT ABOVE GROUND. I.P. BEARS
S20°E, 1.0 FT FROM I.P.
(SOURCE UNKNOWN)

N/A

Accessories Found:

37" NOW 37" DIA. 1. CEDAR WITH A FULLY HEALED SINGLE
BLAZE BEARS S75 1/2°E, 29.9 FT (REC. S72°E, 29.9 FT)
(REN #41)

27" NOW 28" DIA. D. FIR WITH A FULLY HEALED SINGLE BLAZE,
BEARS S24 1/2°W, 39.4 FT (REC. S28 1/2°W, 39.4 FT)
(REN #141)

DISTANCES TAKEN TO CENTER AT BASE, REC. DIST FROM REN #141
TAKEN TO "W" NAIL

see 3

#157 X

RENEWAL

Monument Set (Procedure and Description)

POSITION OF 1/2" I.R. IS REFERENCED I.R. MEASURED 28 1/2" LONG. A DC SO 2 3/8" DIA. BRASS CAP ON A 1 3/8" O.D. X 32" LONG IRON PIPE IS SET AT REFERENCED POSITION OF 1/2" I.R. BC/IP PROTRUDES 12" ABOVE A 4 FT LONG BY 2 FT WIDE 1 FT HIGH MOUND OF STONE. 3/4" I.D. IRON PIPE IS SET ALONG NORTH EDGE OF BC/IP PROTRUDING 18" ABOVE GROUND. 1/2" I.R. IS SET ALONG SOUTH EDGE OF BC/IP PROTRUDING 11" ABOVE GROUND. AT CORNER SOLID ROCK WAS HIT APPROX. 6" BELOW GROUND SURFACE. BRASS CAP IS MARKED AS A RIGHT.


Monument Detail

DOUGLAS COUNTY SURVEYORS
T 22 S
R
C 1/4 . 4
S 26 W
1991
OFFICE

New Accessories

13" DIA. D. FIR DOUBLE BLAZED AND SCRIBED "C 1/4 S 26 CS BT"
BEARS N 88 1/2° E, 15.6 FT
7" DIA. D. FIR DOUBLE BLAZED AND SCRIBED "C 1/4 S 26 CS BT"
BEARS N 57° W, 5.3 FT

Sketch of Monument, Accessories, and General Area

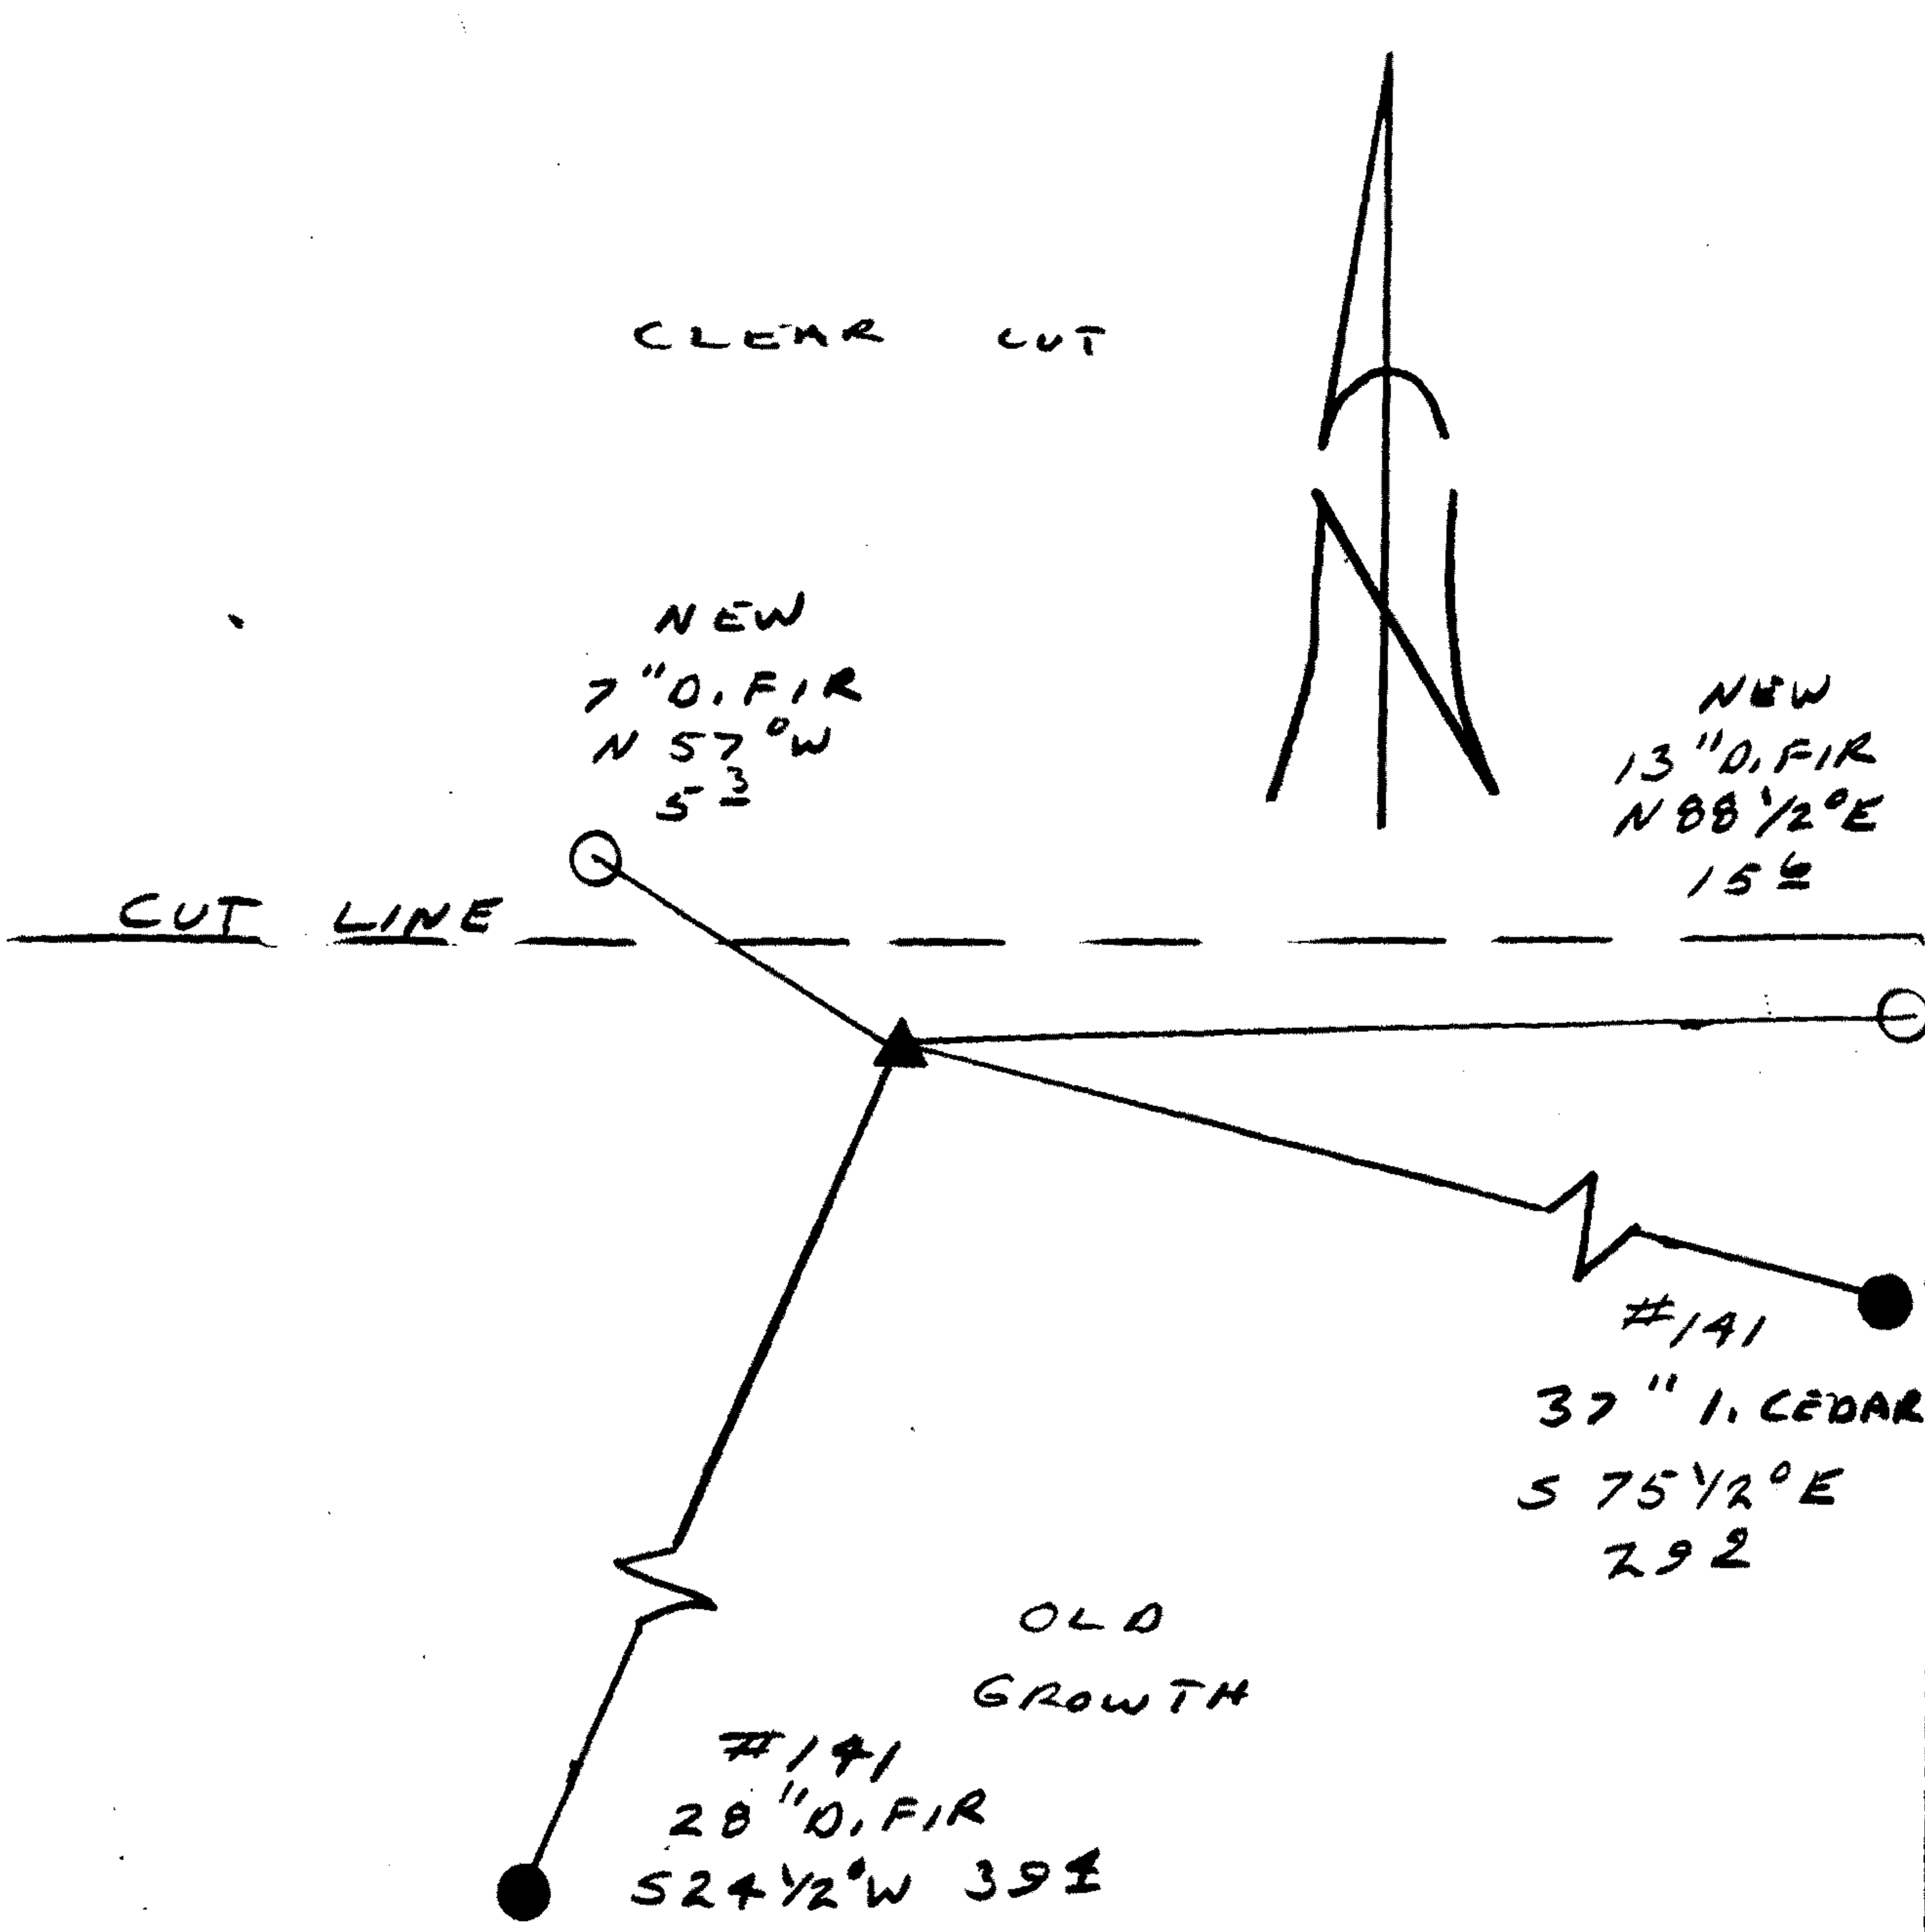

Location & Comments

Comp. Declin. 18° E
Agency DC SO
Party Chief RANDALL W. SMITH
Notekeeper Randall W. Smith
Witnesses STEPHEN J. FLAUS
Address

Surveyor's Seal

REGISTERED
PROFESSIONAL
LAND SURVEYOR

Randall W. Smith

OREGON
JULY 25, 1990
RANDALL W. SMITH
2469