

GOVERNMENT CORNER RESTORATION FORM

FILED

Township 20S Range 11W Sec. 8

County DOUGLAS

FEB 13 1992

State OR Date 2/5/92

No. \_\_\_\_\_

COUNTY SURVEYOR  
DOUGLAS COUNTY, ORE.

Corner Designation

S8 | S9  
---  
S17 | S16

Condition Report Only  
 Not Found  
 Renewed  
 Unrecorded  
 Surveyed In  
 Referenced Out

Previous Renewals #5, #12, #65

MONUMENT DETAIL

Monument(s) Found: (Condition and Source)

2 1/2" DIA. DCSO BRASSCAP ON A  
1/4" O.D. IRON PIPE, PROTRUDING 1 FT  
ABOVE GROUND. WITNESS CORNER  
LIES IN CREEK BANK, LEANING  
WEST OF PLUMB. (REN #65)

COUNTY SURVEYORS OFFICE

T20S R11W  
W.C. 90 FT NORTH

TO  
S8 | S9  
---  
S17 | S16

1969

Accessories Found: BRG'S + DIST. TAKEN FROM  
A POINT DETERMINED AS SEC COR.

30" NOW 84" DIA. CEDAR NO BLAZES VISIBLE BEARS S41°W,  
143.2 FT. (AGREES WITH REC) ORIG BT

23" NOW 15" DIA. 12 FT HIGH MAPLE SNAG POSSIBLE ROTTED BLAZE,  
BEARS S56°E, 213.8 FT. (AGREES WITH REC) REN #12

DCSO BE/JP WIT. COR BEARS SOUTH 90.0 FT  
(AGREES WITH REC) REN #65

2/24

C.S. File No. 64/23-5

Monument Set (Procedure and Description)

Monument Detail

AT A POINT DETERMINED FROM  
BT'S AND BC/IP W. COR. SET  
A 2 1/2" DIA. DCSO BRASS CAP ON  
A 1 3/8" O.D. X 32" LONG IRON PIPE  
12" BELOW GROUND. (CORNER LIES  
IN OPEN PASTURE.

DOUGLAS COUNTY SURVEYORS

T 20 S

58 | 59 R  
517 | 516 W

WIT. COR. BC/IP RETURNED TO PLUMB  
POSITION

1992  
OFFICE

New Accessories

32" DIA HEMLOCK DOUBLE BLAZED AND SCRIBED "T20S R11WS8 CS BT"  
BEARS N20 3/4° W, 401 1/2 FT.


18" DIA. ALDER DOUBLE BLAZED AND SCRIBED "T20S R11WS9 CS BT"  
BEARS N60 1/2° E, 363 1/2 FT.

9" DIA. R. CEDAR DOUBLE BLAZED AND SCRIBED "T20S R11WS16 CS BT" BEARS S74° E, 521 1/2 FT.

Sketch of Monument, Accessories, and General Area

Location & Comments

CORNER POSITION IS IN OPEN  
PASTURE. A WOODEN HUB + TACK  
WAS FOUND NORTH 0.35 FT  
FROM POSITION OF CORNER AS  
WE DETERMINED.

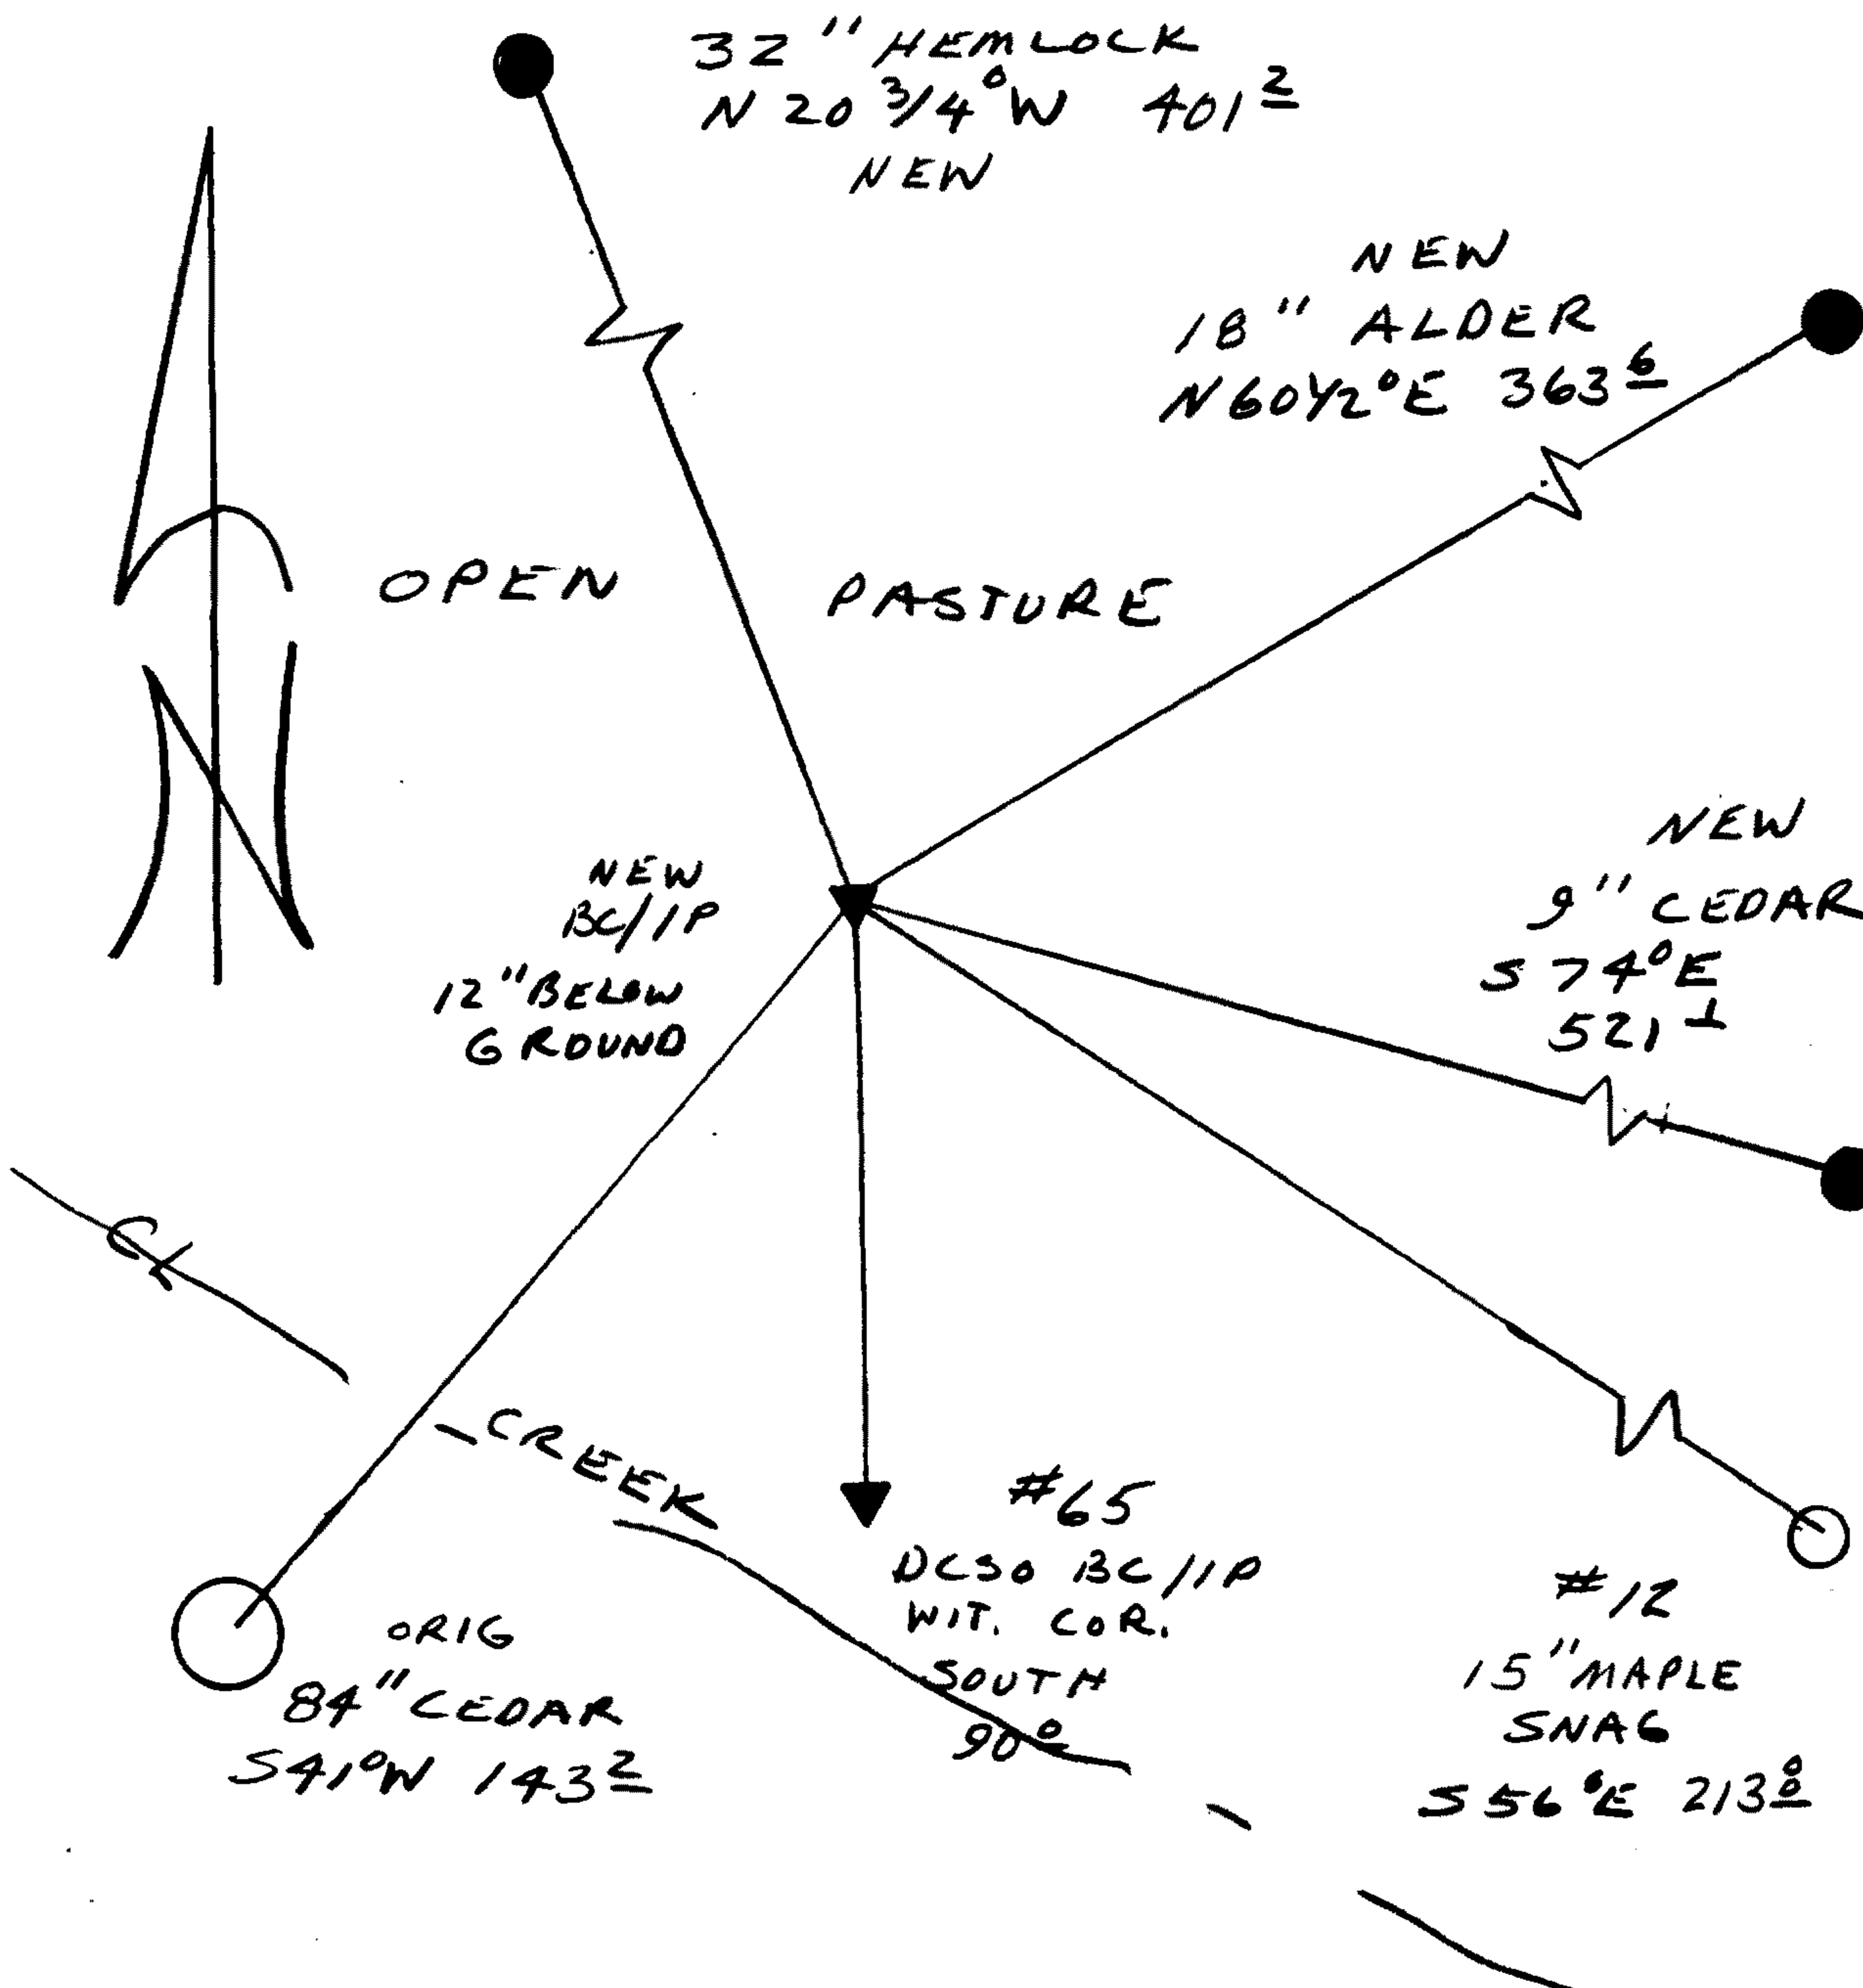

Comp. Declin. 18° E  
Agency DCSO  
Party Chief RANDALL W SMITH  
Notekeeper Randall W Smith  
Witnesses STEPHEN J FLAUSE

Address

Surveyor's Seal  
REGISTERED  
PROFESSIONAL  
LAND SURVEYOR  
*Randall W Smith*  
OREGON  
JULY 25, 1980  
RANDALL W. SMITH  
2469