

GOVERNMENT CORNER RESTORATION FORM

FILED

JK

Township 26S Range 5W Sec. 31 County DOUGLAS FEB 13 1992

State OR Date 2/6/92 No. _____

COUNTY SURVEYOR
DOUGLAS COUNTY, ORE.

Corner Designation

S31 | S32
S6 | S5

- Condition Report Only
- Not Found
- Renewed
- Unrecorded
- Surveyed In
- Referenced Out

Previous Renewals P1 # 200100 (1963 DCSO)

(200700
T27-5)

MONUMENT DETAIL

Monument(s) Found: (Condition and Source)

2 1/2" DIA. DCSO BRASS CAP ON A
1 1/2" O.D. IRON PIPE, PROTRUDING
12" ABOVE GROUND. (1963 DCSO)

COUNTY SURVEYORS OFFICE

T 26 S

S31 | S32 R
S6 | S5 5
W

T 27 S

1963

Accessories Found:

NO ORIG. BT'S FOUND

8" NOW 12" DIA B. OAK WITH A FULLY HEALED DOUBLE BLAZE,
BEARS N 31°W, 11.7 FT (AGREES WITH REC) 1963 DCSO

10" NOW 10" DIA. W. OAK WITH A PARTIALLY HEALED SINGLE
BLAZE, ILLEGIBLE SCRIBING VISIBLE, BEARS N 22°E, 19.8 FT
(AGREES WITH REC.) 1963 DCSO

16" NOW 21" DIA. B. OAK WITH A FULLY HEALED DOUBLE BLAZE,
BEARS S 31°W, 21.3 FT (REC S 31°W, 22.3 FT POSSIBLE TAPING
ERROR) 1963 DCSO

✓ T26-5.003

✓ T27-5.001

C.S. file No. 64/23-15

Monument Set (Procedure and Description)

Monument Detail

NONE


N/A

New Accessories

18" DIA. D. FIR DOUBLE BLAZED AND SCRIBED " T26S R5W S32 CS BT " BEARS N43°E, 3.7 FT

NO REASONABLE TREES TO THE SOUTHEAST

Sketch of Monument, Accessories, and General Area

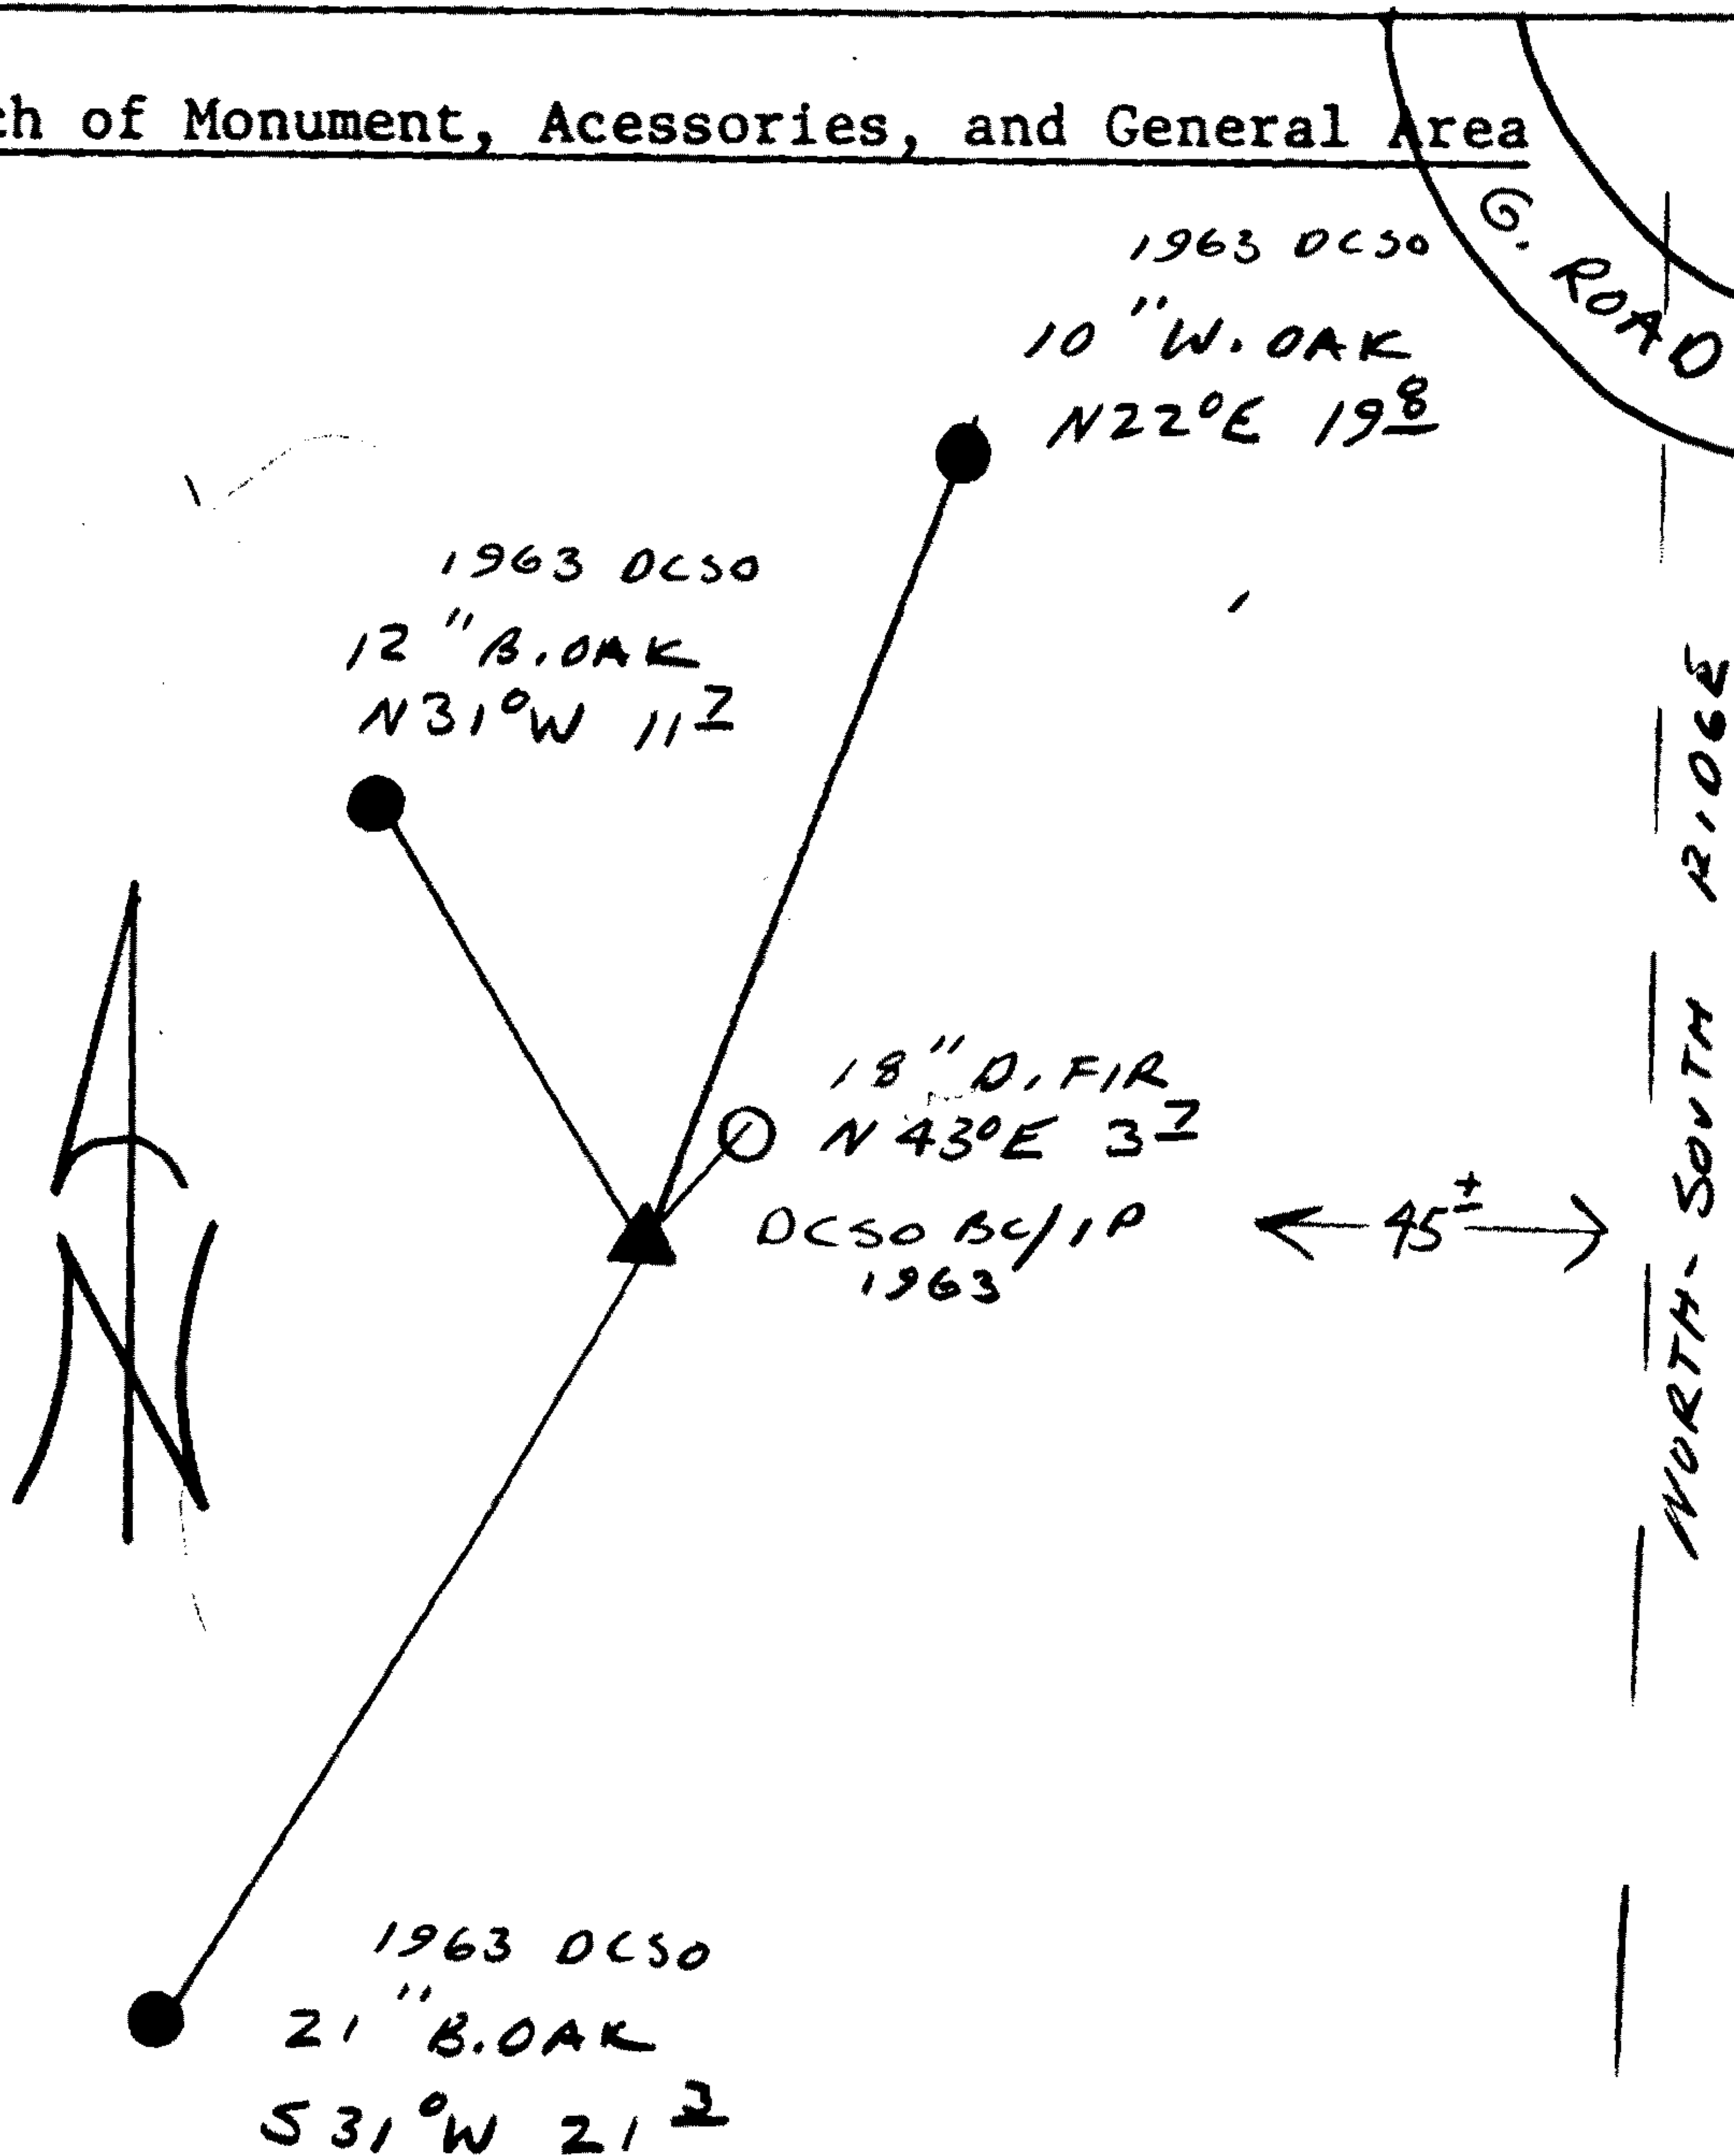

Location & Comments

CORNER LIES APPROX 50 FT SOUTH WEST OF A CORNER IN GRAVEL ROAD ON A NORTH-SOUTH RIDGE

Comp. Declin. 18° E
Agency DCSO
Party Chief RANDALL W SMITH
Notekeeper Randall W Smith
Witnesses STEPHEN J FLAUSE

Address

Surveyor's Seal

REGISTERED PROFESSIONAL LAND SURVEYOR

Randall W Smith

OREGON
JULY 25, 1990
RANDALL W. SMITH
2469