

Township 21S Range 5W Sec. 31 County DOUGLAS

State OR Date 3/16/92 No. \_\_\_\_\_

MAR 18 1992

Corner Designation

S 36 | S 31  
S 1 | S 6

COUNTY SURVEYOR  
DOUGLAS COUNTY, ORE.

- Condition Report Only
- Not Found
- Renewed
- Unrecorded
- Surveyed In
- Referenced Out

Previous Renewals (#59T22-6) (#60T22-5)  
(#52T21-5) (#33T21-6)

Monument(s) Found: (Condition and Source)

DCSO BRASS CAP FLUSH WITH GROUND. (SET IN 1990)

NOTE:  
RENEWAL OF THIS CORNER NOT RECORDED IN 1990. DCSO BC/IP WAS SET AT POSITION OF STONE. (SET BY HAINES IN 1943 PER REN #52) STONE WAS SET ALONG EDGE OF BC/IP BELOW GROUND. (SEE COMMENTS ON BACK).

DOUGLAS COUNTY SURVEYORS  
T215

R S36 | S31 R  
6 1 | 5  
W S1 | S6 W  
T 225  
1990  
OFFICE

Accessories Found:

40" NOW 46" DIA D.FIR WITH A FULLY HEALED BLAZE, BEARS S21°E, 31.0 FT (AGREES WITH REC) REN #52

8" NOW 22" DIA. D.FIR WITH A FULLY HEALED DOUBLE BLAZE, BEARS N72°E, 56.0 FT (AGREES WITH REC) REN #52

10" NOW 14" DIA. R. OAK WITH A FULLY HEALED DOUBLE BLAZE, BEARS S28°W 18.8 FT (AGREES WITH REC.) REN #52

8" NOW 11" DIA. W. OAK WITH A FULLY HEALED DOUBLE BLAZE, BEARS N2°W, 10.0 FT (AGREES WITH REC) REN #52

20" NOW 39" DIA. W. OAK WITH A FULLY HEALED BLAZE, BEARS S7 1/2°E, 97.9 FT (REC S7 1/2°E, 95.7 FT. DIST IS A FACE MEASUREMENT) ORIG. RT

24" NOW 24" DIA. 1 1/2 FT HIGH ROTTED OAK STUMP WITH A ROTTED BLAZE NO SCRIBING VISIBLE, BEARS S13°W, 138.6 FT (AGREES WITH REC) ORIG. RT.

#180 T21-5 X  
#145 T21-6 X  
#161 T22-6 X  
#197 T22-5 X

Monument Set (Procedure and Description)

Monument Detail

NONE

N/A

New Accessories

NONE


Sketch of Monument, Accessories, and General Area

Location & Comments

RANDALL W SMITH AND  
STEPHEN J FLAUSE SET  
DCSO 1990 BC/LP DURING  
CONTROL SURVEY ON FILE  
IN DOUGLAS COUNTY  
SURVEYOR'S OFFICE

Comp. Declin. 18° E  
Agency DCSO  
Party Chief RANDALL W SMITH  
Notekeeper Randall W Smith  
Witnesses STEPHEN J FLAUSE

Address

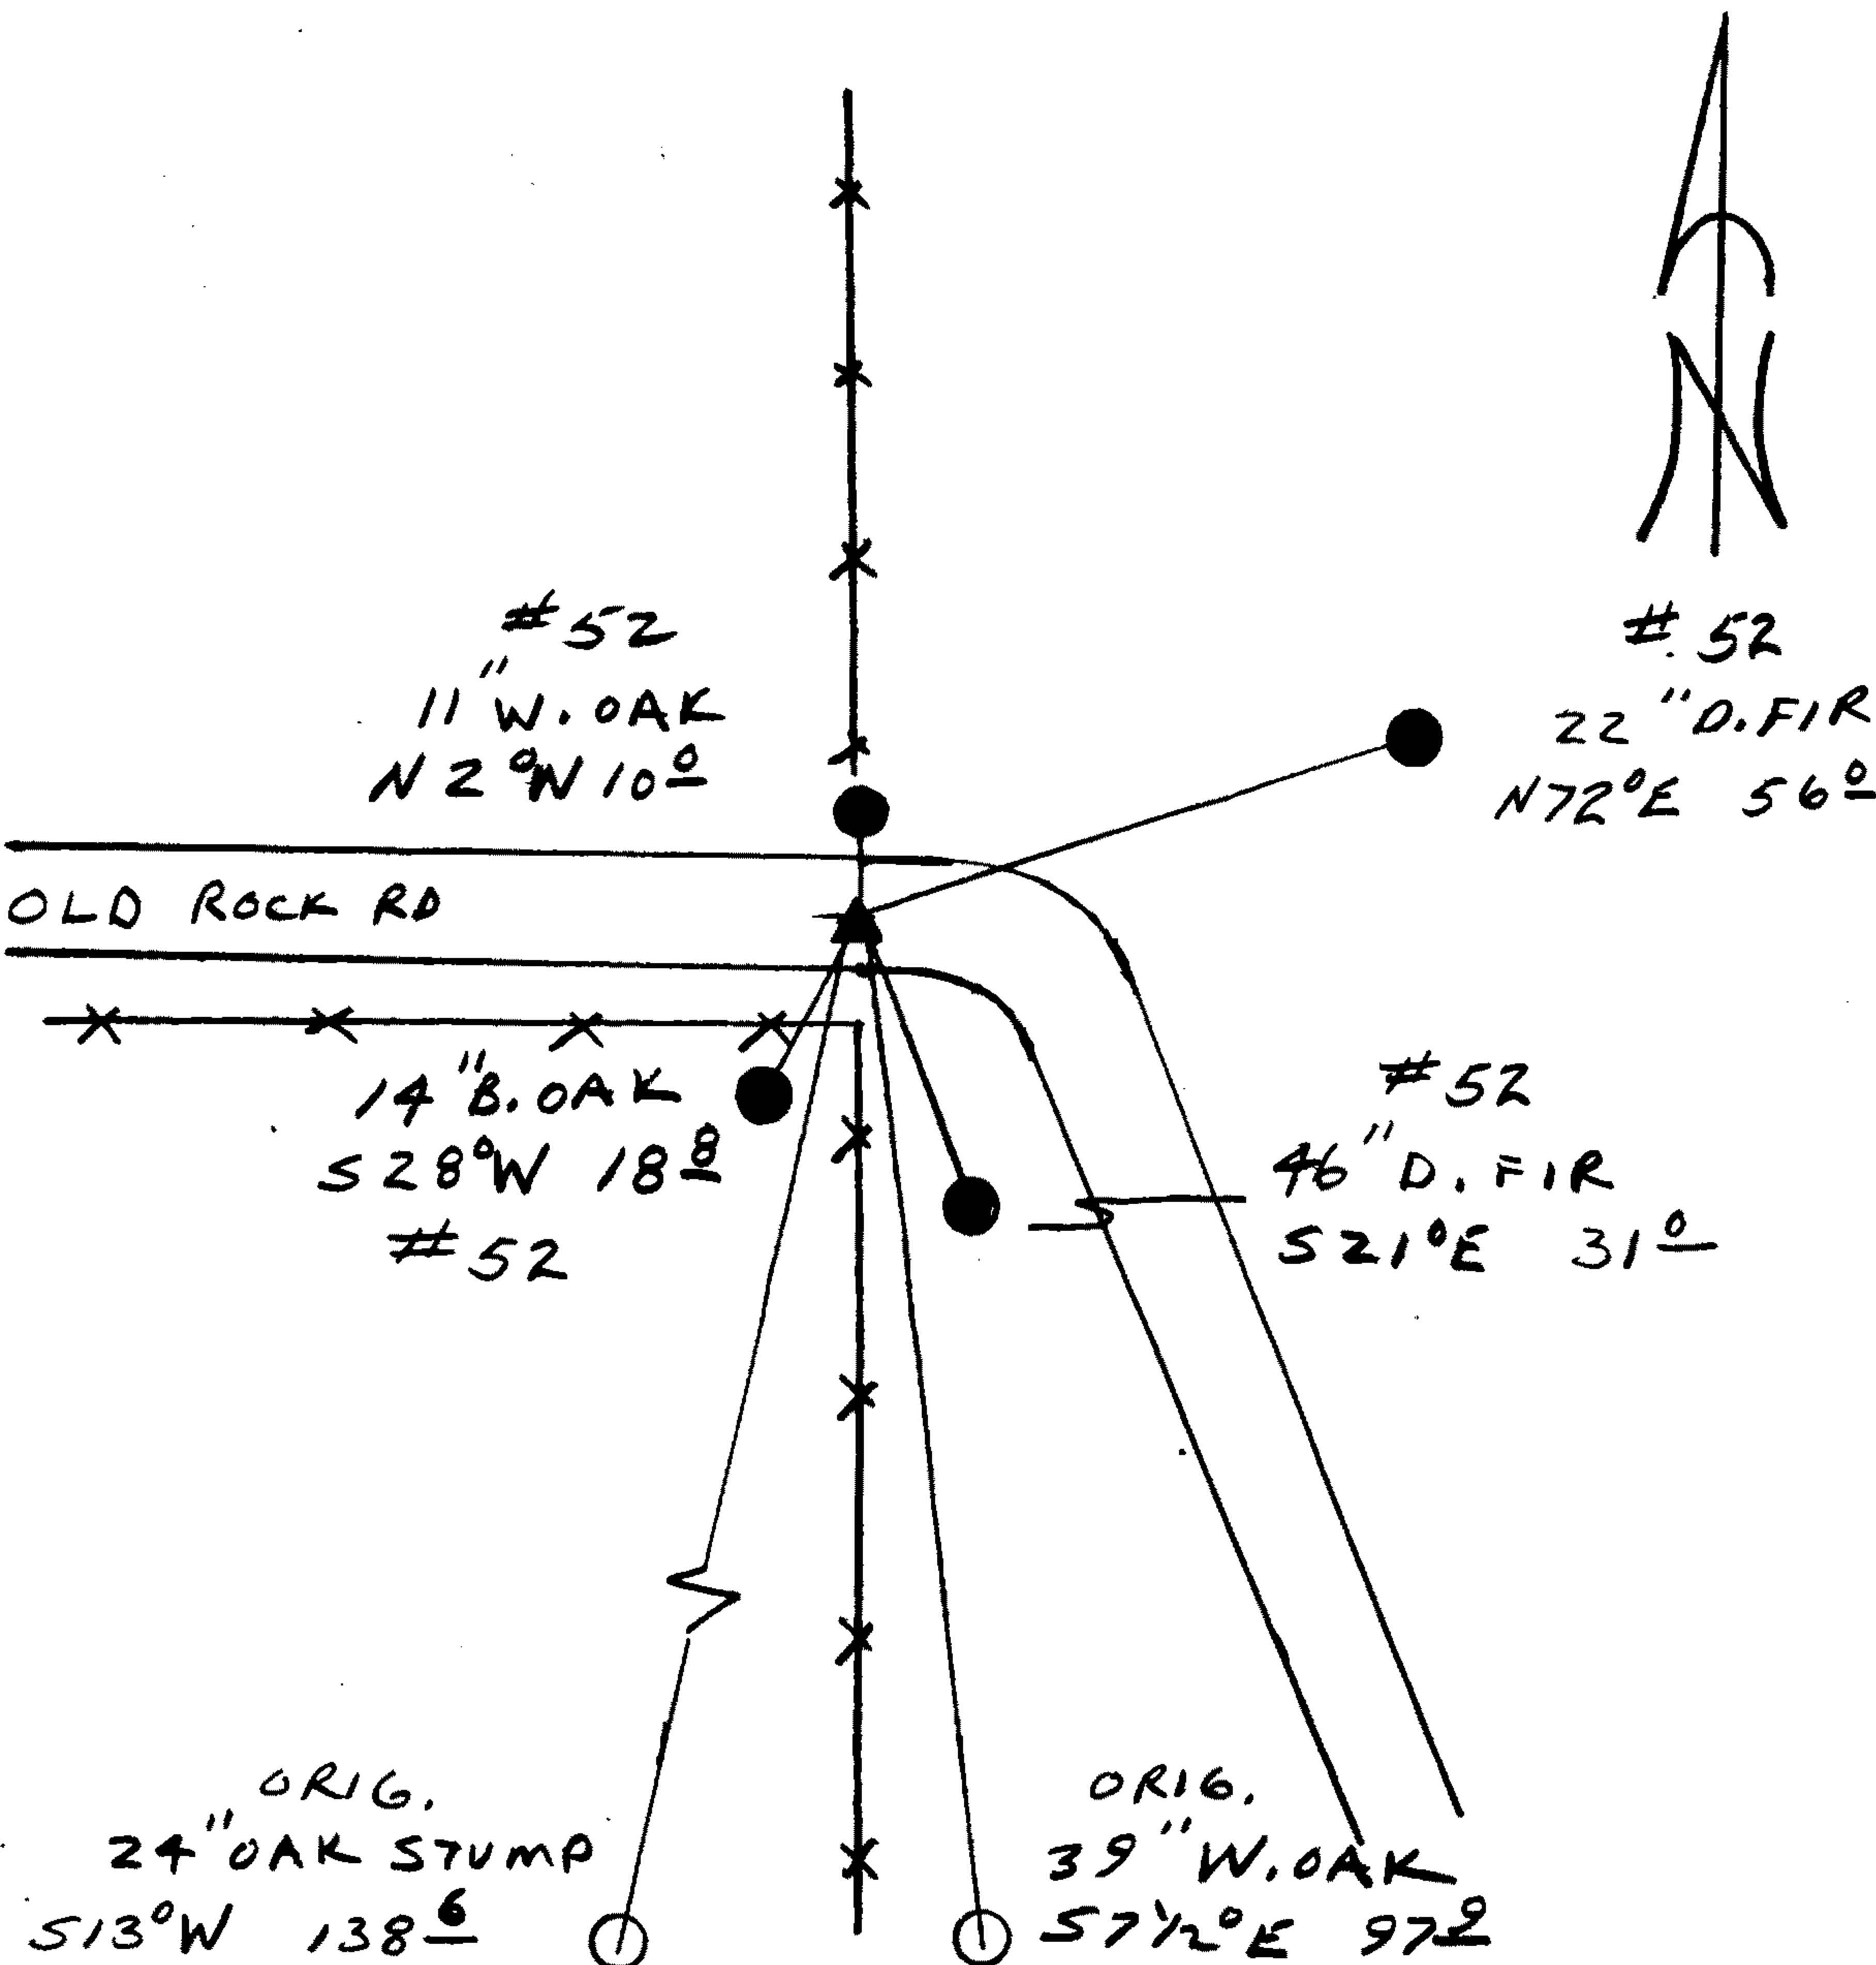

Surveyor's Seal

REGISTERED  
 PROFESSIONAL  
 LAND SURVEYOR

*Randall W. Smith*

OREGON  
 JULY 25, 1990  
 RANDALL W. SMITH  
 2469