

Township Z2S Range 10W Sec. 6 County DOUGLAS

MAR 15 1992

State OR Date 3/5/92

No. \_\_\_\_\_

Corner Designation

COUNTY SURVEYOR  
DOUGLAS COUNTY, ORE.

M.C.  
S 1 / S 6

- \_\_\_\_\_ Condition Report Only
- \_\_\_\_\_ Not Found
- Renewed
- \_\_\_\_\_ Unrecorded
- \_\_\_\_\_ Surveyed In
- \_\_\_\_\_ Referenced Out

Previous Renewals M 56-56 (T22-10) (# 77) (# 146 T22-11)

MONUMENT DETAIL

Monument(s) Found: (Condition and Source)

2 1/2" O.D. BRASS CAP ON AN IRON PIPE  
3" BELOW GROUND. #77

DOUGLAS CO. SURVEYOR

T 22 S

M. C.

R		R
11	S 1 / S 6	10
W		W

1976

Accessories Found:

18" N.W. 58" DIA. BROKEN TOP SPRUCE, WITH A ROTTED CENTER,  
PARTIALLY HEALED, PITCHED OVER BLAZE, WITH ILLEGIBLE  
SCRIBING FROM M 56-56 VISIBLE. BT BEARS S 8° E, 111.5 FT  
(AGREES WITH REC.) ORIG. BT

#175 T22-11 X  
# ~~146~~ T22-10 X

Monument Set (Procedure and Description)

Monument Detail

NONE


N/A

New Accessories

9" DIA. ALDER, BARK SCRIBED "MC 51 CS BT", BEARS S 97 1/2° W, 104.4 FT

Sketch of Monument, Accessories, and General Area

Location & Comments

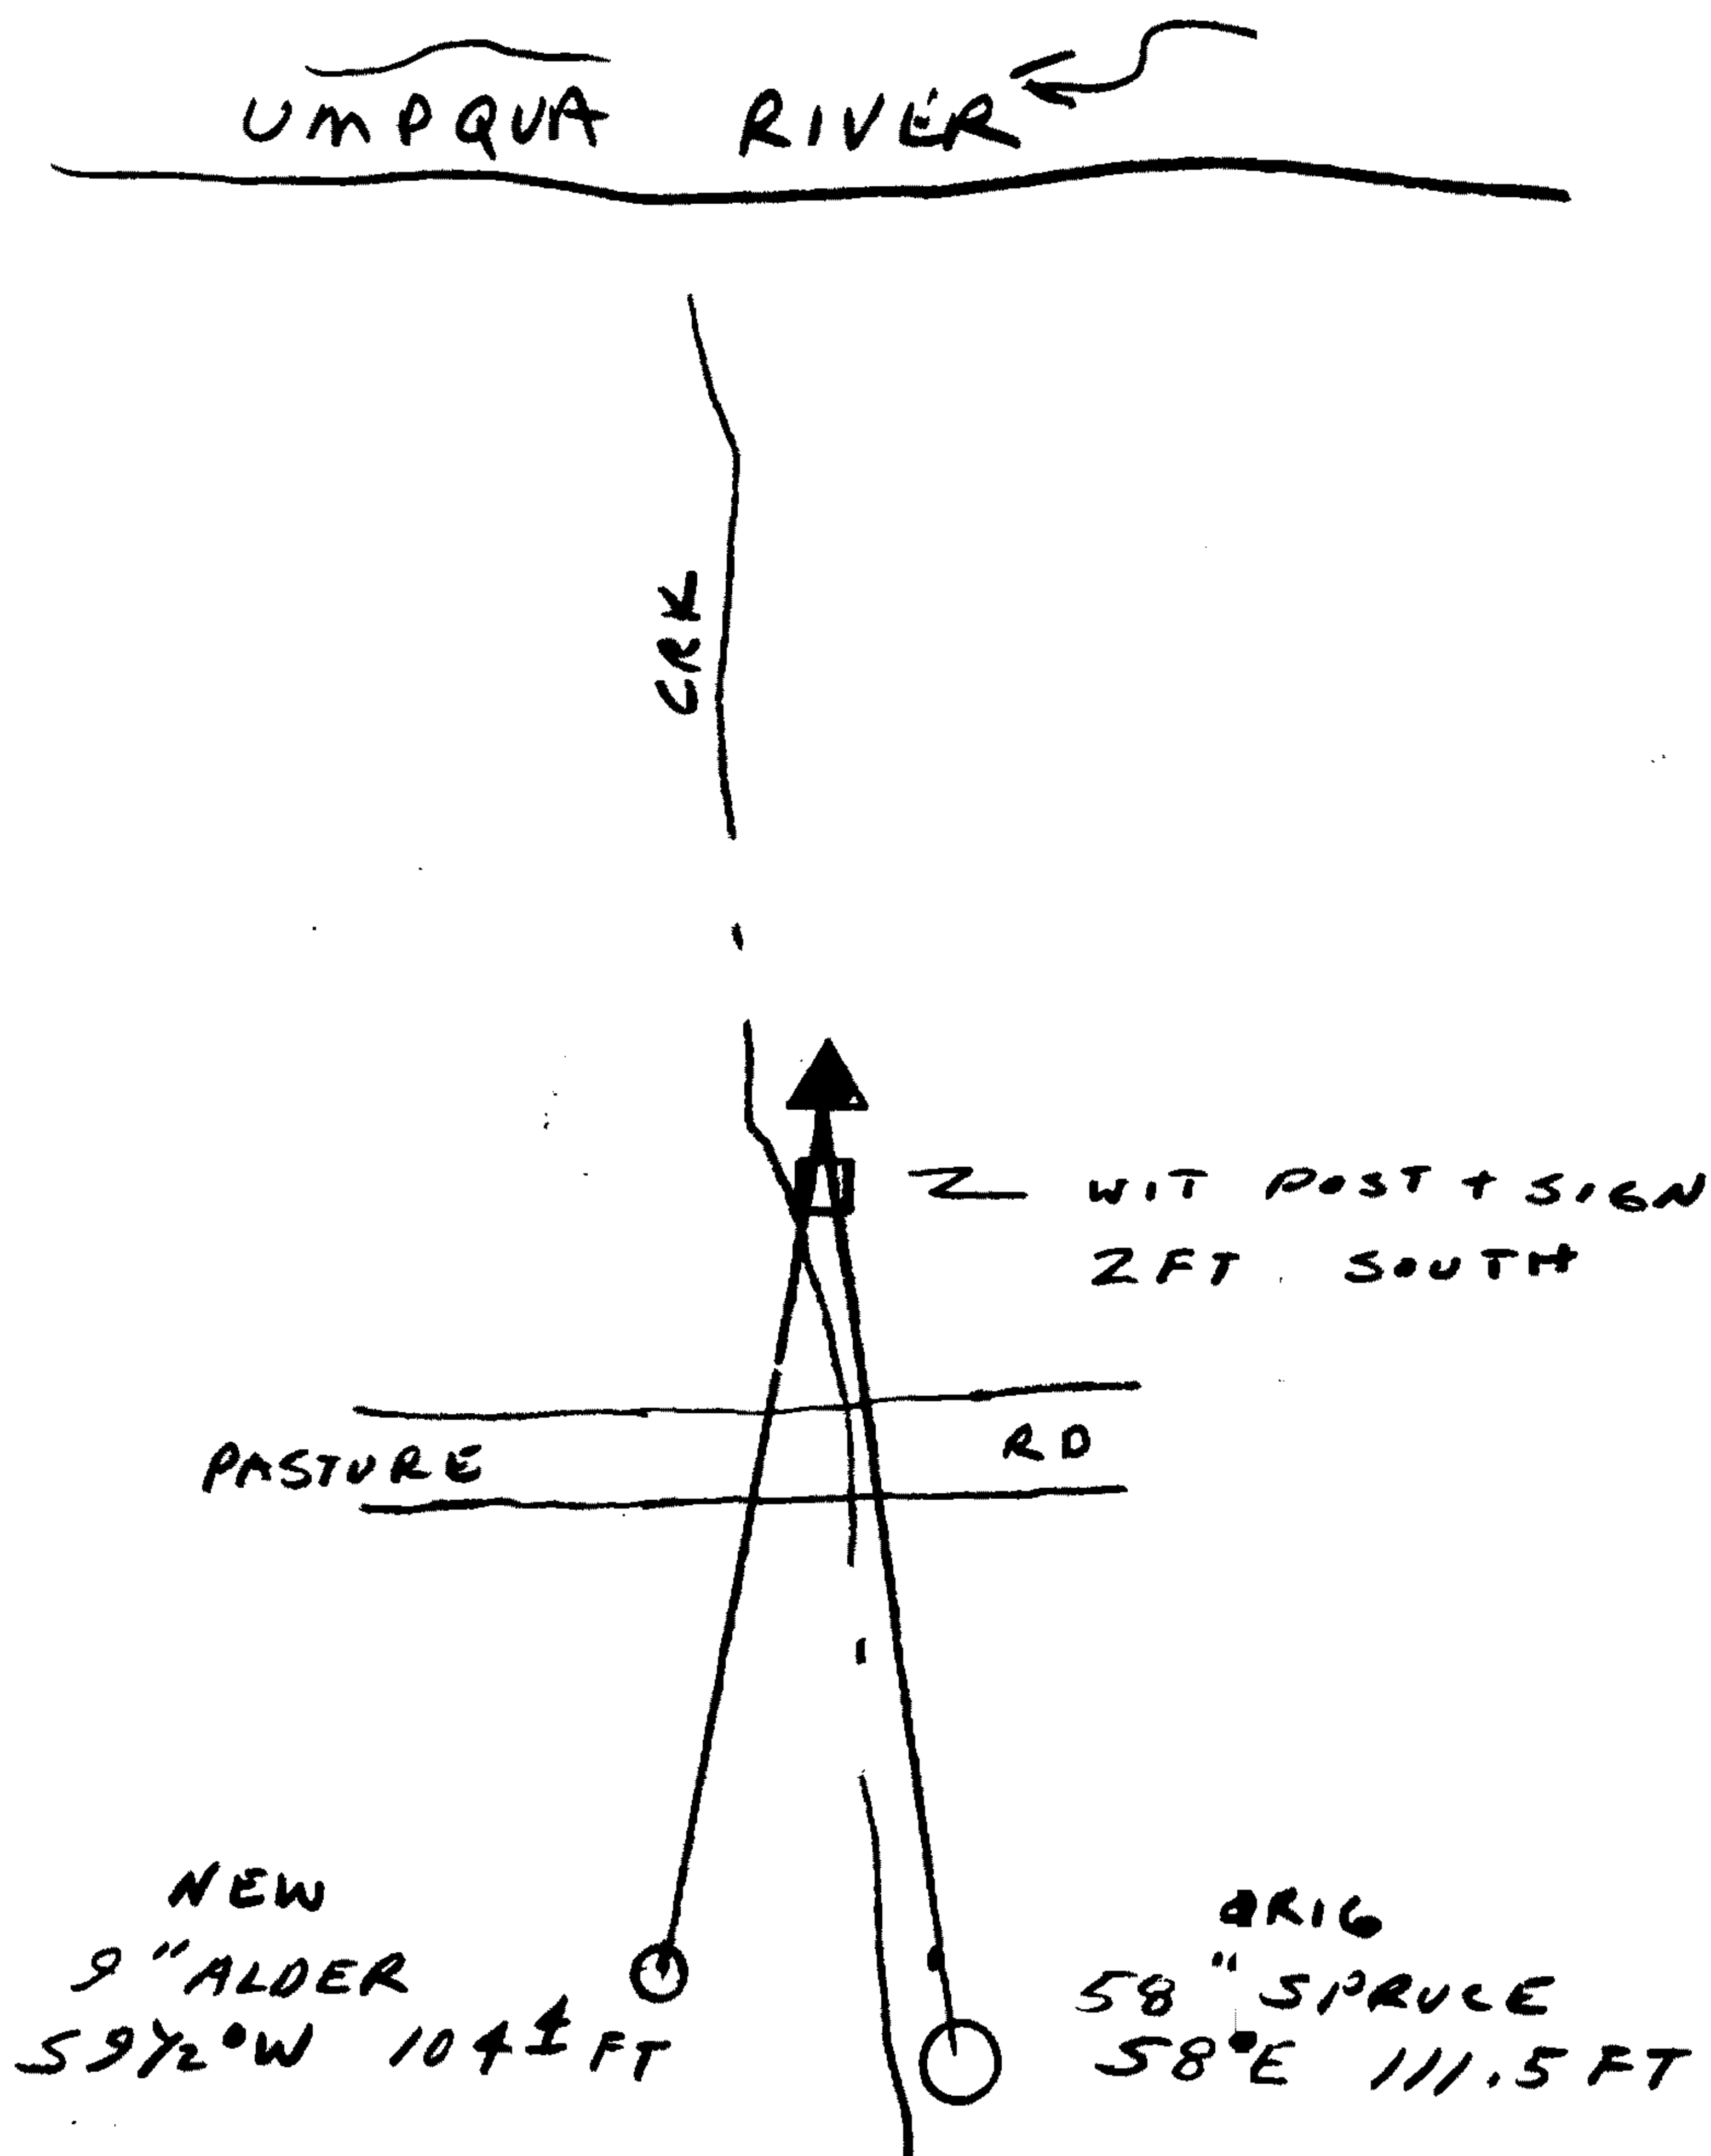

Comp. Declin. 18° E  
 Agency DCSO  
 Party Chief RANDALL W. SMITH  
 Notekeeper Randall W. Smith  
 Witnesses \_\_\_\_\_

Address

