

GOVERNMENT CORNER RESTORATION FORM FILED JP

Township 21S Range 6W Sec. 22 County DOUGLAS

State OREGON Date APRIL 16, 1992 No. \_\_\_\_\_

MAY 1 1992

Corner Designation

COUNTY SURVEYOR  
DOUGLAS COUNTY, OREGON

22 | 23  
---  
27 | 26

- \_\_\_\_\_ Condition Report Only
- \_\_\_\_\_ Not Found
- Renewed
- \_\_\_\_\_ Unrecorded
- \_\_\_\_\_ Surveyed In
- \_\_\_\_\_ Referenced Out


Previous Renewals # 88

MONUMENT DETAIL

Monument(s) Found: (Condition and Source)

A 12x14x36 INCH STONE WITH AN "X" SCRIBED IN TOP (AS SHOWN AT RIGHT), PARTIALLY BURIED AND FIRMLY SET.

ON WEST EDGE OF ABOVE STONE, A HAINES "T" IRON WITH HAINES IDENTIFYING BRASS WASHER MISSING PROTRUDES 14 INCHES ABOVE GROUND AND IS FIRMLY SET.

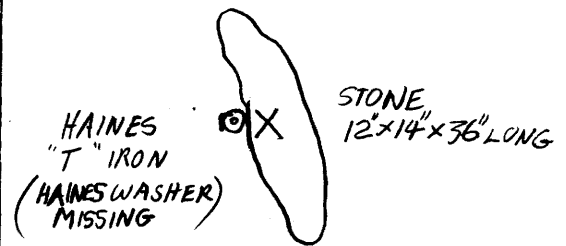

Accessories Found:

(BEARINGS AND DIST. ARE TO "X" IN STONE)

THREE ORIGINAL BT'S ARE NOT FOUND LOCATIONS ARE IN SLIDE, CREEK AND BURN AREAS.

ONE ORIGINAL BEARING TREE ALSO NOTED IN RENEWAL #88 IS FOUND.

A FIR 16 INS. DIAM. NOW A 37 INCH D.B.H. DOUGLAS FIR WITH A FULLY HEALED DOUBLE BLAZE BEARS S46°E, 9 1/2 FEET DISTANT (AS PER RECORD).

ONE BEARING TREE MARKED IN RENEWAL #88 IS FOUND. A 7 INCH R. CEDAR NOW A 16 INCH D.B.H. RED CEDAR WITH A PARTIALLY HEALED SINGLE BLAZE SCRIBED "S23 T21S R6W BT" BEARS N51°E 12 1/2 FEET DISTANT (RECORD DISTANCE 11 1/4 FT. IS TO HAINES WASHER ON TREE). (NW HEMLOCK FALLS IN ERODED CREEK BED; GONE)

