

GOVERNMENT CORNER RESTORATION FORM

FILED

JK

Township 19S Range 10W Sec. 36 County DOUGLAS

MAY 20 1992

State OREGON Date 5/6/92

No. _____ COUNTY SURVEYOR
DOUGLAS COUNTY, ORE.

Corner Designation

$\frac{1}{4}$ $\frac{536}{51}$ T19-10
T20-10

- Condition Report Only
- Not Found
- Renewed
- Unrecorded
- Surveyed In
- Referenced Out

Previous Renewals 1954 BLM RESURVEY

Monument(s) Found: (Condition and Source)

A $2\frac{1}{2}$ INCH DIAMETER BRASS CAP
(MARKED AS AT RIGHT) ON A $\frac{1}{4}$ INCH O.D.
IRON PIPE FIRMLY SET AND PROTRUDING
APPROXIMATELY 3 INCHES ABOVE GROUND

U.S. GENERAL LAND OFFICE

$\frac{1}{4}$ $\frac{536}{51}$

1952

Accessories Found:

TWO BEARING TREES FROM 1954 BLM RESURVEY FOUND.
A FIR, 36 INS. DIAM. NOW A FALLEN AND PARTIALLY ROTTEN
FIR SNAG, WITH EVIDENCE OF A FULLY HEALED SINGLE BLAZE,
THE ROOT HOLE OF WHICH BEARS N 75° E, 39 6 FEET DISTANT (AS PER RECORD).
A FIR 54 INS. DIAM, NOW A 45 INCH D.B.H. DOUGLAS FIR WITH A FULLY
HEALED SINGLE BLAZE BEARS S 86° E, 53 2 FEET DISTANT (RECORD S 83° 45' E,
52 1 FT.; PREVIOUSLY RECORDED DIAMETER APPEARS TO BE ERRONEOUS).

#50 T19-104
#129 T20-104

U.S. File No. 64/26-5

C

Monument Set (Procedure and Description)

Monument Detail

N/A


N/A

New Accessories

A 5.5 INCH D.B.H. 80 FOOT TALL FIR SNAG WITH A HIGH, OPEN, CRUISERS BLAZE BEARS S 72° W, 57 1/2 FEET DISTANT.
A 6 INCH D.B.H. ALDER BARK SCRIBED "1/4 SI CS BT" BEARS N 86 3/4° W 30 1/2 FEET DISTANT.

Sketch of Monument, Accessories, and General Area

Location & Comments

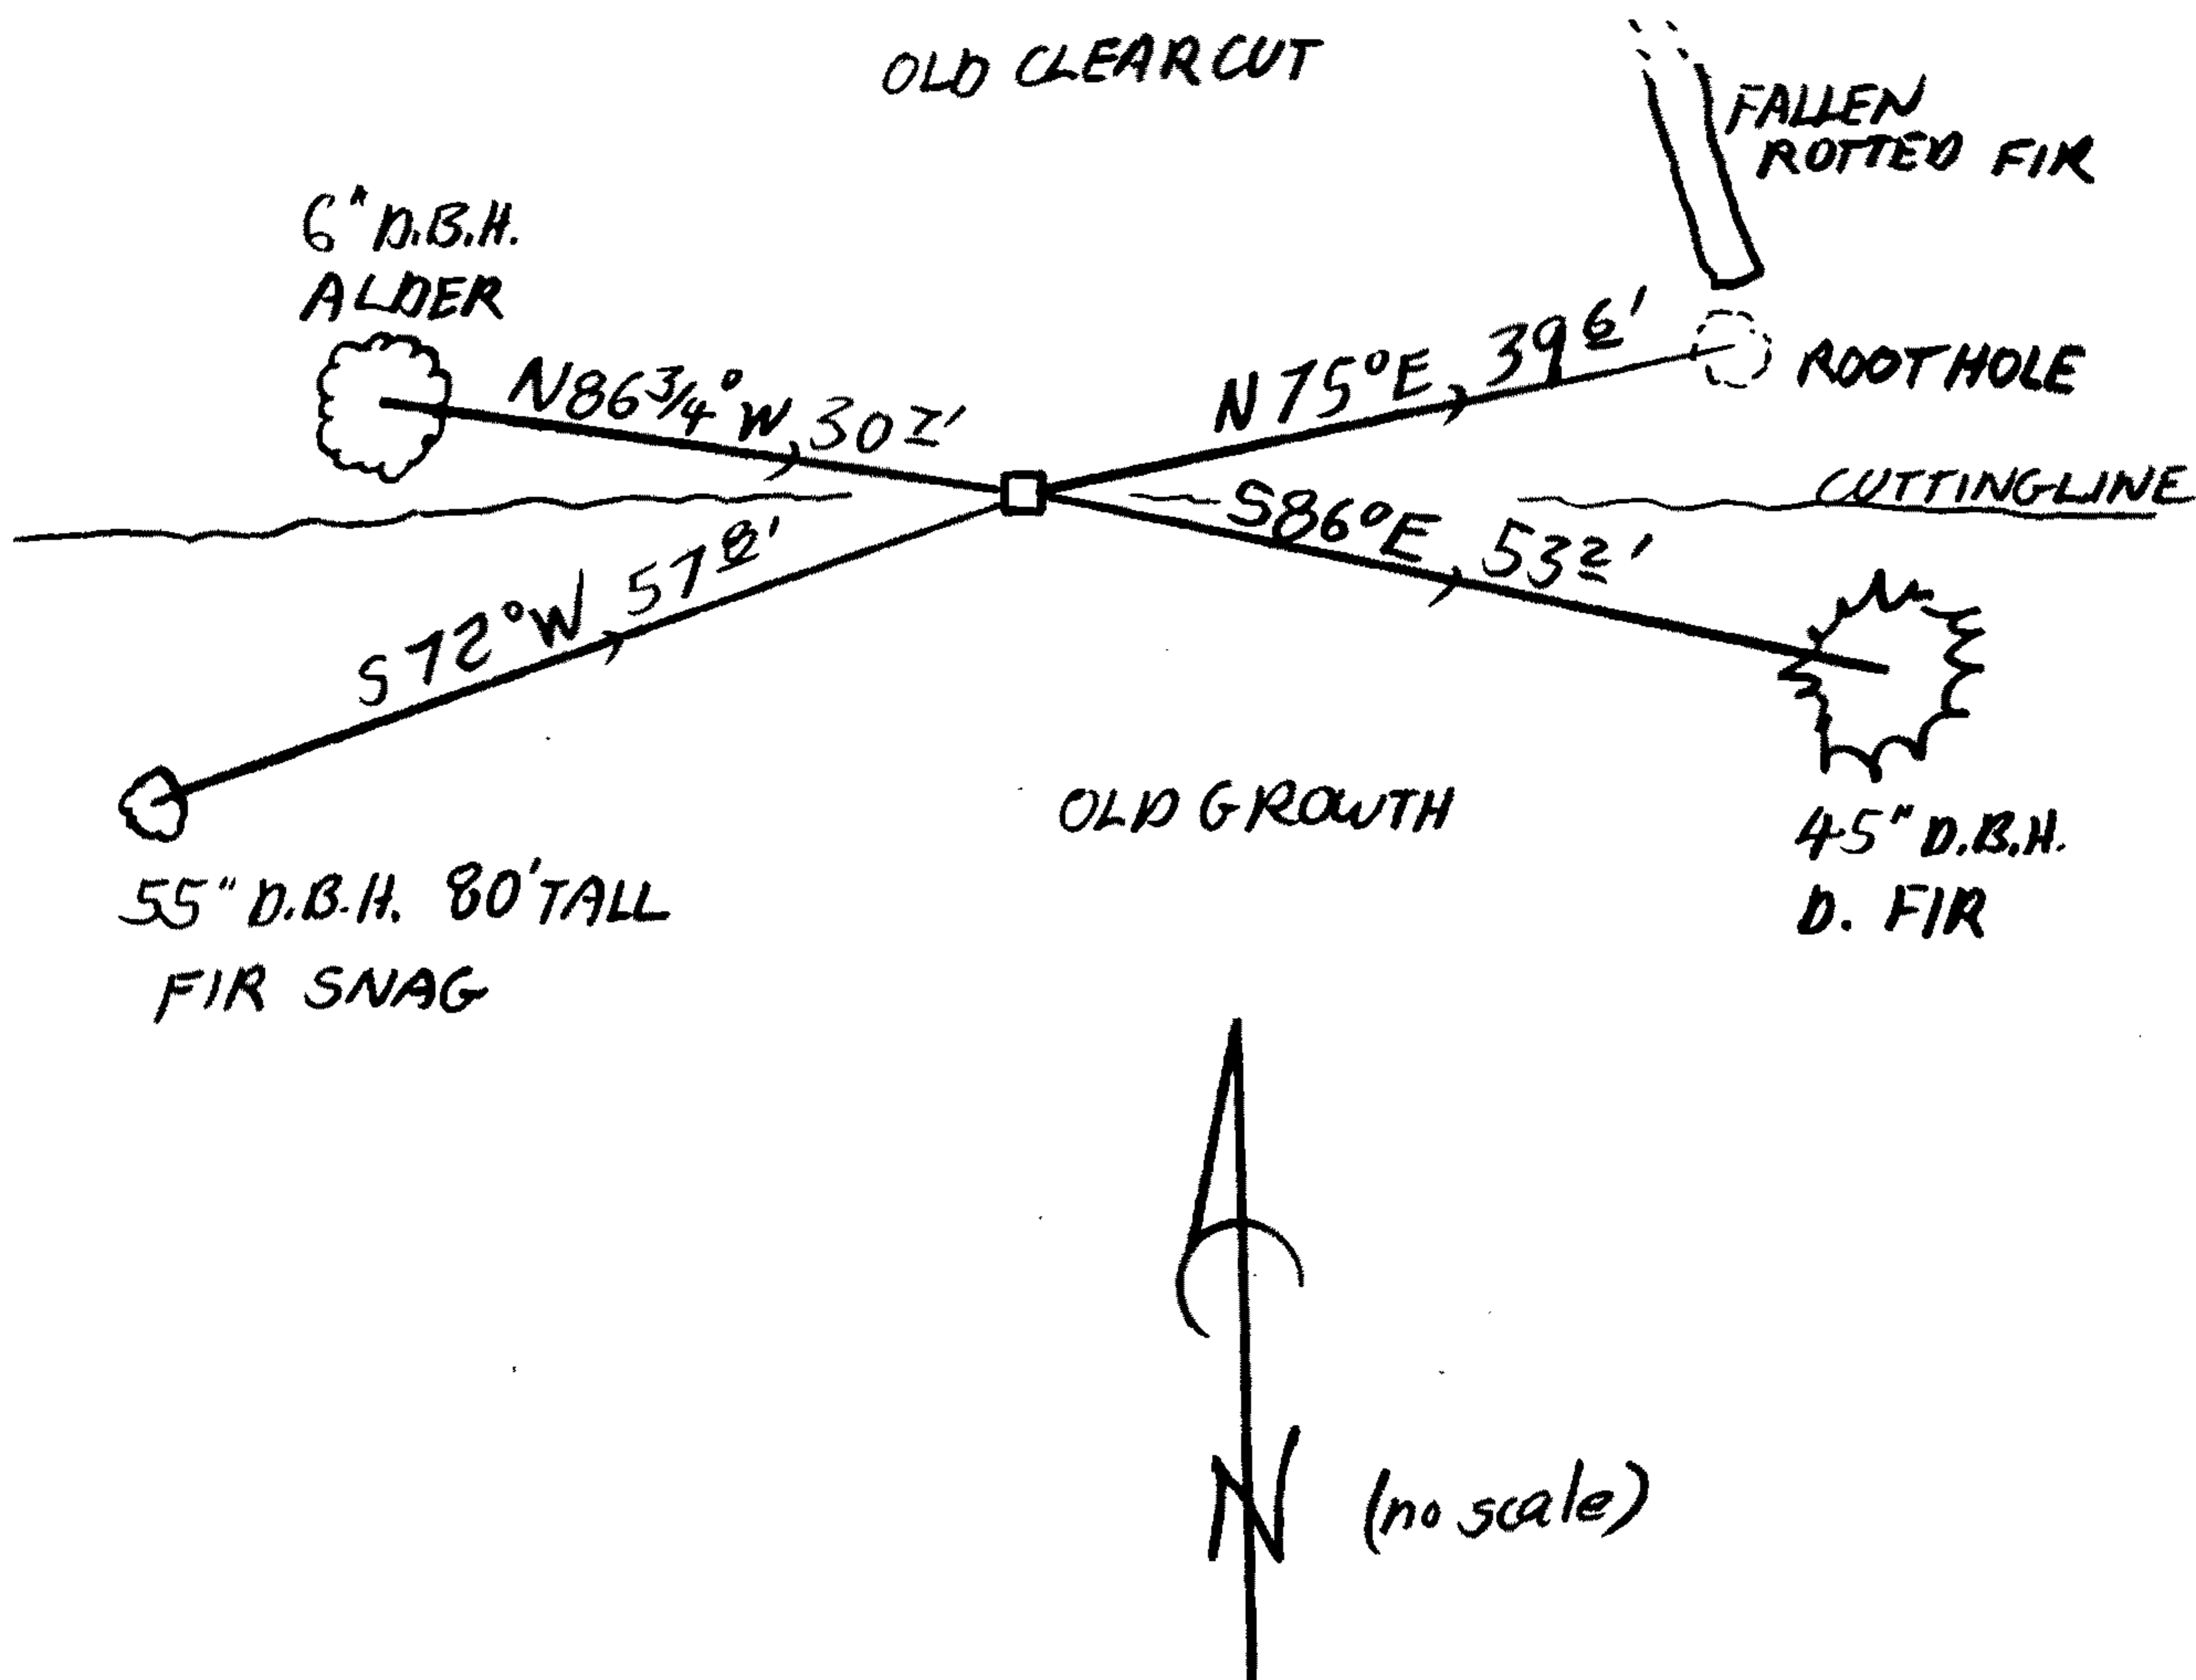

MONUMENT IS ON A SOUTH SLOPE NEAR BOTTOM OF VERY STEEP SOUTH SLOPE. MONUMENT ON AN EAST WEST CUTTING LINE WITH OLDER CLEAR CUT TO NORTH OLD GROWTH TO SOUTH. MONUMENT IS APPROX 200 FT SOUTH FROM A CLOSED LOGGING SPAUR ROAD END.

Comp. Declin. 18° E
Agency DCSD
Party Chief RW SMITH
Notekeeper Stephen John Blaine
Witnesses J. PIKE

Address

Surveyor's Seal
REGISTERED PROFESSIONAL LAND SURVEYOR
Randall W. Smith
OREGON JULY 25, 1990
RANDALL W. SMITH
2469