

GOVERNMENT CORNER RESTORATION FORM

FILED *ph*

Township 245 Range 2W Sec. 26 County DOUGLAS

State OR Date 6/2/92 No. \_\_\_\_\_

JUN 4 1992

Corner Designation

S27 | S26  
---  
S34 | S35

COUNTY SURVEYOR  
DOUGLAS COUNTY, ORE

- Condition Report Only
- Not Found
- Renewed
- Unrecorded
- Surveyed In
- Referenced Out

Previous Renewals 1951 GLO D. RESURVEY

Monument(s) Found: (Condition and Source)

A 2 1/2" DIA. GLO BRASS CAP ON A  
2" O.D. IRON PIPE, PROTRUDING  
6" ABOVE. BC/IP LEANS 4" SOUTHWEST  
OF PLUMB. (1951 GLO)

U.S. GENERAL LAND OFFICE

T 245 R 2W

S27 | S26  
---  
S34 | S35

1951  
SURVEY

Accessories Found:

16" NOW 30" DIA. 25' HIGH HEMLOCK SNAG WITH SCRIBING  
VISIBLE ON AN OPEN BLAZE "S26", BEARS N 16 1/2° E, 21.6 FT  
(1951 GLO REC. N 16 1/2° E, 19.8 FT) ORIG. BT

10" FIR NOW 20" DIA 2' HIGH HEMLOCK STUMP WITH SCRIBING  
VISIBLE ON A ROTTED BLAZE "35", BEARS S 31 1/4° E, 42.8 FT  
(AGREES WITH 1951 GLO REC) ORIG BT

18" NOW 28" DIA. 15' HIGH CEDAR SNAG WITH SCRIBING VISIBLE  
ON AN OPEN BLAZE "2W", BEARS S 26 1/2° W, 19.1 FT  
(AGREE WITH 1951 GLO REC) ORIG BT

20" NOW 26" DIA. 25' HIGH CEDAR SNAG, NO BLAZES OR  
SCRIBING VISIBLE, BEARS N 27 1/2° W, 16.8 FT (1951 GLO REC  
N 27 1/2° W, 15.8 FT) ORIG BT

REN. #118  
X

C.S. File No. 64/26-13  
C

RENEWAL

Monument Set (Procedure and Description)

Monument Detail

1951 GLO BC/IP RETURNED TO PLUMB POSITION, PROTRUDES 6" ABOVE GROUND.


N/A

New Accessories

7" DIA. HEMLOCK DOUBLE BLAZED AND SCRIBED "T245 R2W S27 CS BT"  
 BEARS N 16 1/2° W, 33.3 FT  
 7" DIA. D. FIR DOUBLE BLAZED AND SCRIBED "T245 R2W S26 CS BT"  
 BEARS N 61° E, 31.6 FT  
 5" DIA. HEMLOCK DOUBLE BLAZED AND SCRIBED "T245 R2W S35 CS BT"  
 BEARS S 58 1/2° E, 11.0 FT.  
 9" DIA. HEMLOCK DOUBLE BLAZED AND SCRIBED "T245 R2W S34 CS BT"  
 BEARS S 56 1/2° W, 48.4 FT.

Sketch of Monument, Accessories, and General Area

Location & Comments

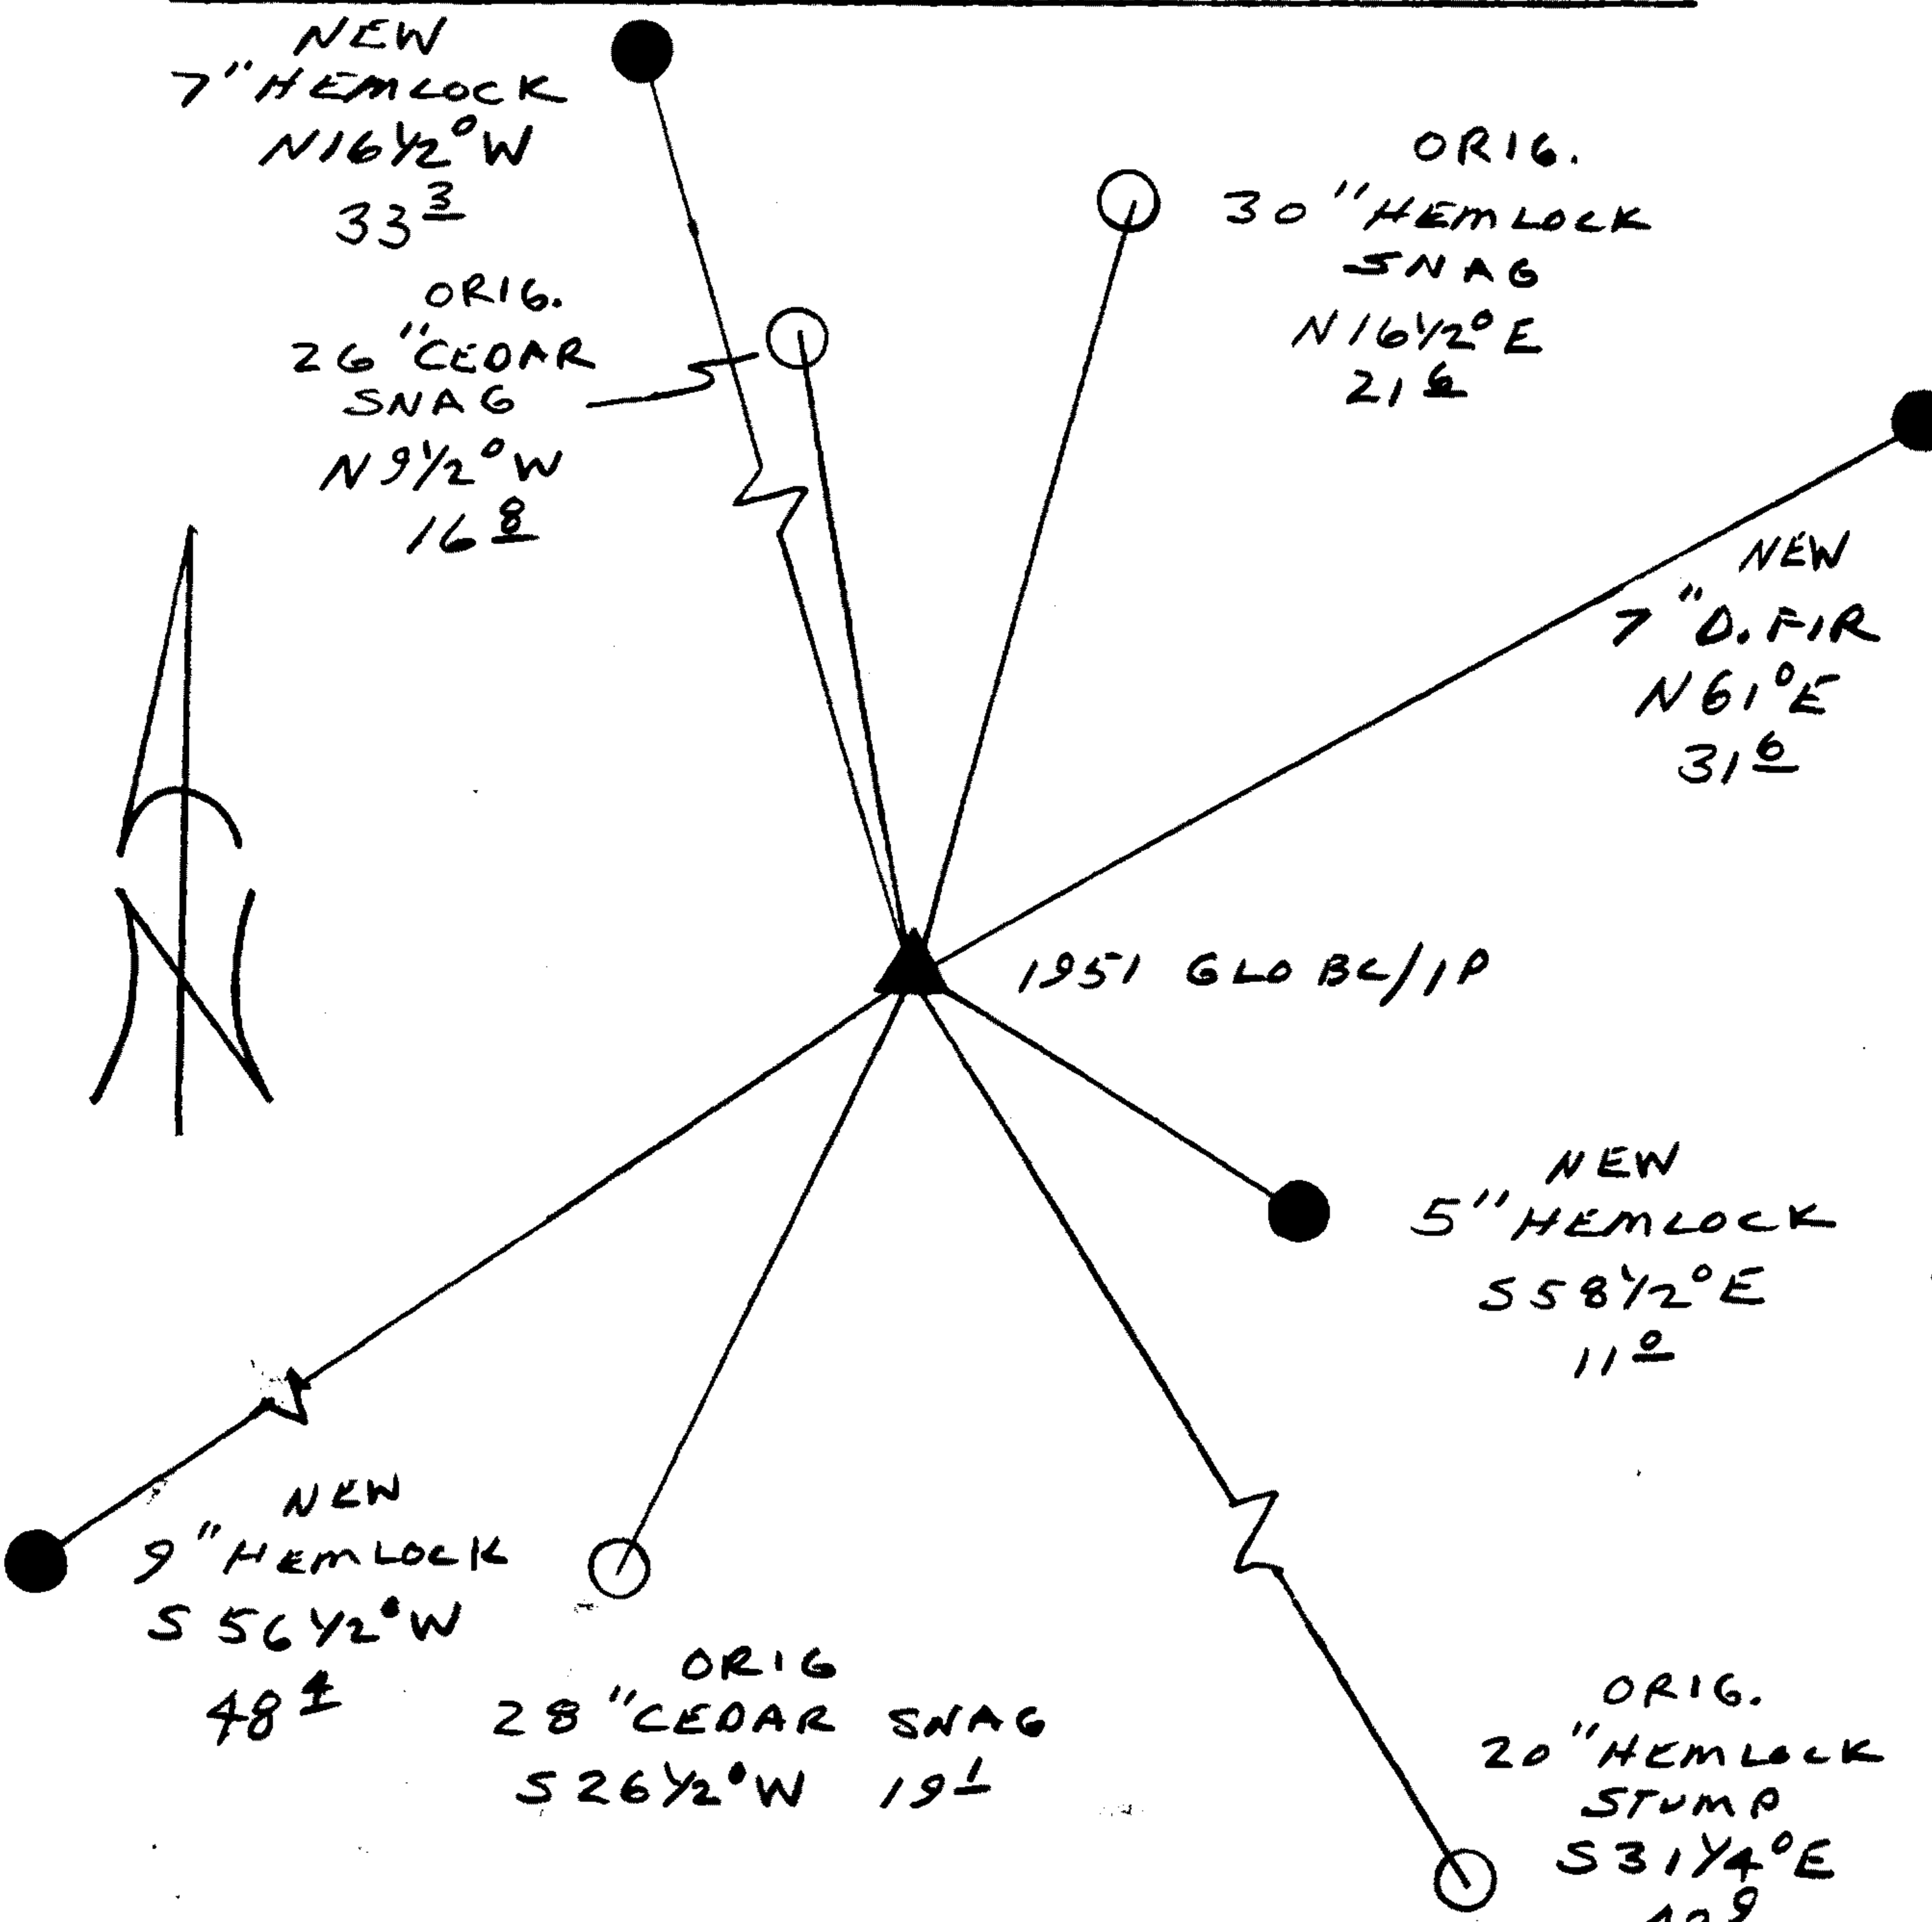

ORIG SW AND SE BT'S WILL PROBABLY BE DESTROYED BY ROAD CONSTRUCTION.

BC/IP SHOULD BE ALONG NORTH SIDE OF RD, WHEN CONSTRUCTED. CORNER IS ON TOP OF A SE RIDGE.

Comp. Declin. 18° E  
 Agency DLCO  
 Party Chief RANDALL W. SMITH  
 Notekeeper *Randall W. Smith*  
 Witnesses STEPHEN J. FLAUSE

Address

**Surveyor's Seal**

REGISTERED  
 PROFESSIONAL  
 LAND SURVEYOR

*Randall W. Smith*

OREGON  
 JULY 25, 1990  
 RANDALL W. SMITH  
 2469